

DCMO BOCES - Phase 1&2 AS BUILT

Norwich / Masonville, New York



As Prepared By

AIR TEMP HEATING & AIR CONDITIONING, INC.

A LINC SERVICE ® CONTRACTOR

1165 Front Street

Binghamton, New York 13905

Phone Number: 607-772-8362

Architect Bearsch, Compeau, Knudson

Mechanical Engineer Bearsch, Compeau, Knudson

Mechanical Contractor Louis N. Picciano & Son

AUTOMATEDLOGIC®
CORPORATION


DCMO BOCES
P7425

Printed On: 11/19/2007

1 of 69

Table of Contents


1: Titlepage	38: HPNorwich C163 Bathrooms
2: Table of Contents	39: EF'S NORWICH
3: Symbol Legend	40: Convector
4: Summary Bill of Materials	41: Boiler Wiring 01- HC
5: Riser Diagram	42: Boiler Wiring 02 - HC
6: Norwich Boiler Room	43: Boiler Wiring 03 - HC
7: Norwich Boiler Room 2	44: HPHarold A308 Bathrooms
8: HRU Indoor 1C	45: HPHarold A212
9: HRU Indoor 2C	46: HPHarold A301 Bathrooms
10: HRU INDOOR 3C, 4C	47: HPHarold A16 Corridor
11: HRU ROOF	48: HPHarold A226 Office
12: AHU 1C	49: HPHarold B312 Bathrooms
13: AHU 2C	50: HPHarold A215 Bathrooms
14: AHU - 7, 8, 9	51: HPHarold A227.3 Work Room
15: AHU 10, 11	52: HPHarold A222 Office
16: MUA Paint Booth	53: HPHarold South Stairs Upper
17: MUA Prep Booth	54: MAU - HC
18: MUA Autobody	55: HRU - HC & CC
19: Radiant Panels	56: AHU 1H MSN
20: Radiant Panel rev2	57: UV - HC ZN 551
21: Fin Tube	58: UV-HC SE6104
22: Fin Tube Greenhouse	59: NETWORKED EF'S HAROLD
23: Greenhouse Hydronics	60: Valve Schedule
24: Heat Pump - HC & CC TYPICAL	61: Sequence Of Operation-pg.1
25: HPNorwich C172 Special Ed	62: Sequence Of Operation-pg.2
26: HPNorwich C157 Offices	63: Sequence Of Operation-pg.3
27: HPNorwich C161 Special Ed	64: Sequence Of Operation-pg.4
28: Riser 2	65: Sequence Of Operation-pg.5
29: HPNorwich C118 Computer Network	
30: HPNorwich HP C154 Special Ed	
31: HPNorwich 146 Bathrooms	
32: HPNorwich C136 Bathrooms	
33: HPNorwich C133.1 Girls Locker	
34: HPNorwich C132.1 Boys Locker	
35: HPNorwich C19 Corridor	
36: HPNorwich CG07 Bathroom	
37: HPNorwich CG05 Bathroom	

DCMO BOCES - Phase 1&2 AS BUILT			
Norwich / Masonville, New York			
Air Temp Heating & Air Conditioning, Inc.			
Table of Contents			
REV: 1	As-Built	11/19/2007	JOB NO: P7425-7290
 AIR TEMP HEATING & AIR CONDITIONING, INC. <small>A LINC SERVICE © CONTRACTOR</small>			CHECK BY: RSL
			DSCODE:
			2 of 69


Symbol Legend



Supply Fan

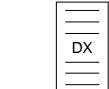


DX Cooling Coil

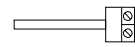


Duct Temperature Sensor



Exhaust Fan

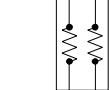

Electric Heating Coil

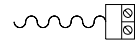

Averaging Duct Temperature Sensor




Return Fan




Gas Heating



Duct Humidity Sensor

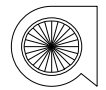

Fan w/ Inlet Vane Control

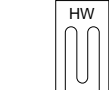

Hot Water Heating Coil




Immersion Temperature Sensor w/ Well




Pump




Chilled Water Cooling Coil

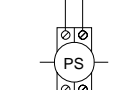


Pressure Sensor

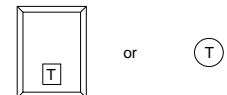


Room Temperature Sensor

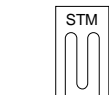


Steam Heating Coil

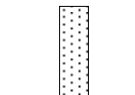


Filter

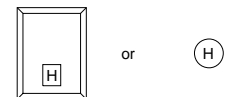


Room Humidity Sensor

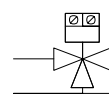


3 - Way Valve

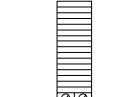


Air Flow Station

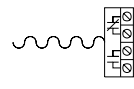


FreezeStat

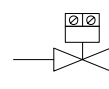


2 - Way Valve

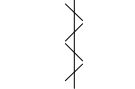

Damper

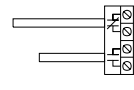

Smoke Detector

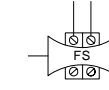

Flow Sensor

Common Abbreviations:


AC - Air Conditioning
 ACU - Air Conditioning Unit
 AHU - Air Handling Unit
 AI - Analog Input
 AO - Analog Output
 AUTO - Automatic
 AUX - Auxiliary
 C - Common
 CHW - Chilled Water
 CHWP - Chilled Water Pump
 CHWR - Chilled Water Return
 CHWS - Chilled Water Supply
 COND - Condenser
 CW - Condenser Water
 CWP - Condenser Water Pump
 CWR - Condenser Water Return
 CWS - Condenser Water Supply
 DA - Discharge Air
 DI - Digital Input
 DO - Digital Output
 EA - Exhaust Air
 EF - Exhaust Fan

EVAP - Evaporator
 F - Fahrenheit
 FCU - Fan Coil Unit
 HOA - Hand / Off / Auto
 HP - Heat Pump
 HRU - Heat Recovery Unit
 HTEX - Heat Exchanger
 HW - Hot Water
 HWP - Hot Water Pump
 HWR - Hot Water Return
 HWS - Hot Water Supply
 MAX - Maximum
 MIN - Minimum
 MISC - Miscellaneous
 NC - Normally Closed
 NO - Normally Open
 OA - Outdoor Air
 PIU - Powered Induction Unit
 RA - Return Air
 RF - Return Fan
 RH - Relative Humidity
 RTU - Roof-top Unit

SA - Supply Air
 SF - Supply Fan
 SP - Static Pressure
 TEMP - Temperature
 UH - Unit Heater
 UV - Unit Ventilator
 VAV - Variable Air Volume
 VVTU - Variable Volume Terminal Unit
 W/ - with
 W/O - without
 WSHP - Water-Source Heat Pump


General Notes:

1. All control modules are drawn using standard ALC module representations.
2. Electrical points are identified by a tagged method (LN# - LG - CM - EX - Z0):

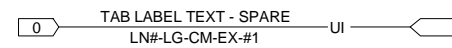


LN# - The line number (optional).
 LG - The gateway number (optional).
 CM - The control module address.
 EX - The expander module number.
 #1 - The channel number.

These tags include wiring for all AI's, DI's, AO's and DO's. Points using pneumatic tubing follow the same convention.

DCMO BOCES - Phase 1&2 AS BUILT			
Norwich / Masonville, New York			
Air Temp Heating & Air Conditioning, Inc.			
Symbol Legend			
REV: 1	As-Built	11/19/2007	JOB NO: P7425-7290
 AIR TEMP HEATING & AIR CONDITIONING, INC. A LINC SERVICE CONTRACTOR			CHECK BY: RSL
			DSCODE:
3 of 69			

Summary Bill of Materials


Summary Bill of Materials				
DID	DESCRIPTION	MANUFACTURER	PART NUMBER	QTY
AAR	ARCNET REPEATER	AUTOMATED LOGIC	AAR	1 ea
AQST	AQUASTAT	JOHNSON CONTROLS	A19DAC-1C	22 ea
CO	CARBON MONOXIDE SENSOR	BAPI	BA/420CO-3-ND-EUO-FM	2 ea
COA	ALARM BUZZER	MYN TAHL CORP	FM-24A-901A	2 ea
DAT	DA TEMP SENSOR	BAPI	BA/10K-2-D-12	20 ea
DATP	DISCHARGE AIR TEMP SENSOR	BAPI	BA/10K-2-RPP-8	105 ea
DHS	DUCT HUMIDITY SENSOR	BAPI	BA/H200-D	9 ea
DIAG	BIAS BOARD	AUTOMATED LOGIC	DIAG485	1 ea
DPT	DIFF PRESSURE TRANSMITTER-WET	SETRA	2301-025PD-2F-11-B	12 ea
ECON	DAMPER ACTUATOR	BELIMO	AF24-SR US	10 ea
EN-24	ENCLOSURE	DETROIT CONTROLS	DCP-24-T	2 ea
EOCV	CONTROL VALVE	BELIMO	SEE VALVE SCHEDULE	3 ea
F/BP	DAMPER ACTUATOR	BELIMO	LF24-SR US	3 ea
FLOW	FLOW SWITCH	INTEC	DBSF-1KPLN-4US	9 ea
HCV	HEATING CONTROL VALVE	BELIMO	SEE VALVE SCHEDULE	7 ea
HTL	HIGH TEMP SENSOR	SIEMENS	141-0530	4 ea
IMM	IMMERSION TEMP SENSOR	BAPI	BA/10K-2-I-4	16 ea
IMMS	IMMERSION TEMP SENSOR	BAPI	BA/10K-2-I-2	32 ea
LTD	LOW AIR TEMP SENSOR	SIEMENS	134-1510	10 ea
M8102	CONTROL MODULE	AUTOMATED LOGIC	M8102	2 ea
MAT	MIXED AIR TEMP SENSOR	BAPI	BA/10K-2-A-12	10 ea
MX4106	CONTROL MODULE	AUTOMATED LOGIC	MX4106	2 ea
MX880	CONTROL MODULE	AUTOMATED LOGIC	MX880	2 ea
OAD	DAMPER ACTUATOR	BELIMO	NF24-US	4 ea
PROT	SURGE PROTECTOR	AUTOMATED LOGIC	PROT485	1 ea
REP	SIGNAL REPEATER	AUTOMATED LOGIC	REP485	2 ea
RIB	RELAY	FUNCTIONAL DEVICES	RIBU1C	150 ea
RIBX	CURRENT SWITCH	FUNCTIONAL DEVICES	RIBXKF	139 ea
RIBXL	RELAY	FUNCTIONAL DEVICES	RIBXLCRF	24 ea
SE6104	CONTROL MODULE	AUTOMATED LOGIC	SE6104	16 ea
STAT	LV RA THERMOSTAT	SIEMENS	RAA20U	1 ea
TR-50	TRANSFORMER, 120/24VAC, 50VA	FUNCTIONAL DEVICES	TR50VA002	147 ea
WELL	IMMERSION TEMP SENSOR WELL	BAPI	BA/4	16 ea
WELS	IMMERSION TEMP SENSOR WELL	BAPI	BA/2	32 ea
ZN220	CONTROL MODULE	AUTOMATED LOGIC	ZN220	16 ea
ZN253	CONTROL MODULE	AUTOMATED LOGIC	ZN253	3 ea
ZN551	CONTROL MODULE	AUTOMATED LOGIC	ZN551	106 ea
ZNT	ZONE TEMPERATURE SENSOR	AUTOMATED LOGIC	RS PLUS	112 ea

DCMO BOCES - Phase 1&2 AS BUILT			
Norwich / Masonville, New York			
Air Temp Heating & Air Conditioning, Inc.			
Summary Bill of Materials			
REV: 1	As-Built	11/19/2007	JOB NO: P7425-7290
 AIR TEMP HEATING & AIR CONDITIONING, INC. <small>A LINC SERVICE © CONTRACTOR</small>			CHECK BY: RSL
			DSCODE:
4 of 69			

Riser Diagram

DCMO NORWICH CAMPUS

Bill of Materials				
DID	DESCRIPTION	MANUFACTURER	PART NUMBER	QTY
AAR	ARCNET REPEATER	AUTOMATED LOGIC	AAR	1 ea
DIAG	BIAS BOARD	AUTOMATED LOGIC	DIAG485	2 ea
EN-20	ENCLOSURE	DETROIT CONTROLS	DCP-20-T	1 ea
EN-24	ENCLOSURE	DETROIT CONTROLS	DCP-24-T	1 ea
PROT	SURGE PROTECTOR	AUTOMATED LOGIC	PROT485	2 ea
WC	WEBCTRL SOFTWARE	AUTOMATED LOGIC	WC	1 ea

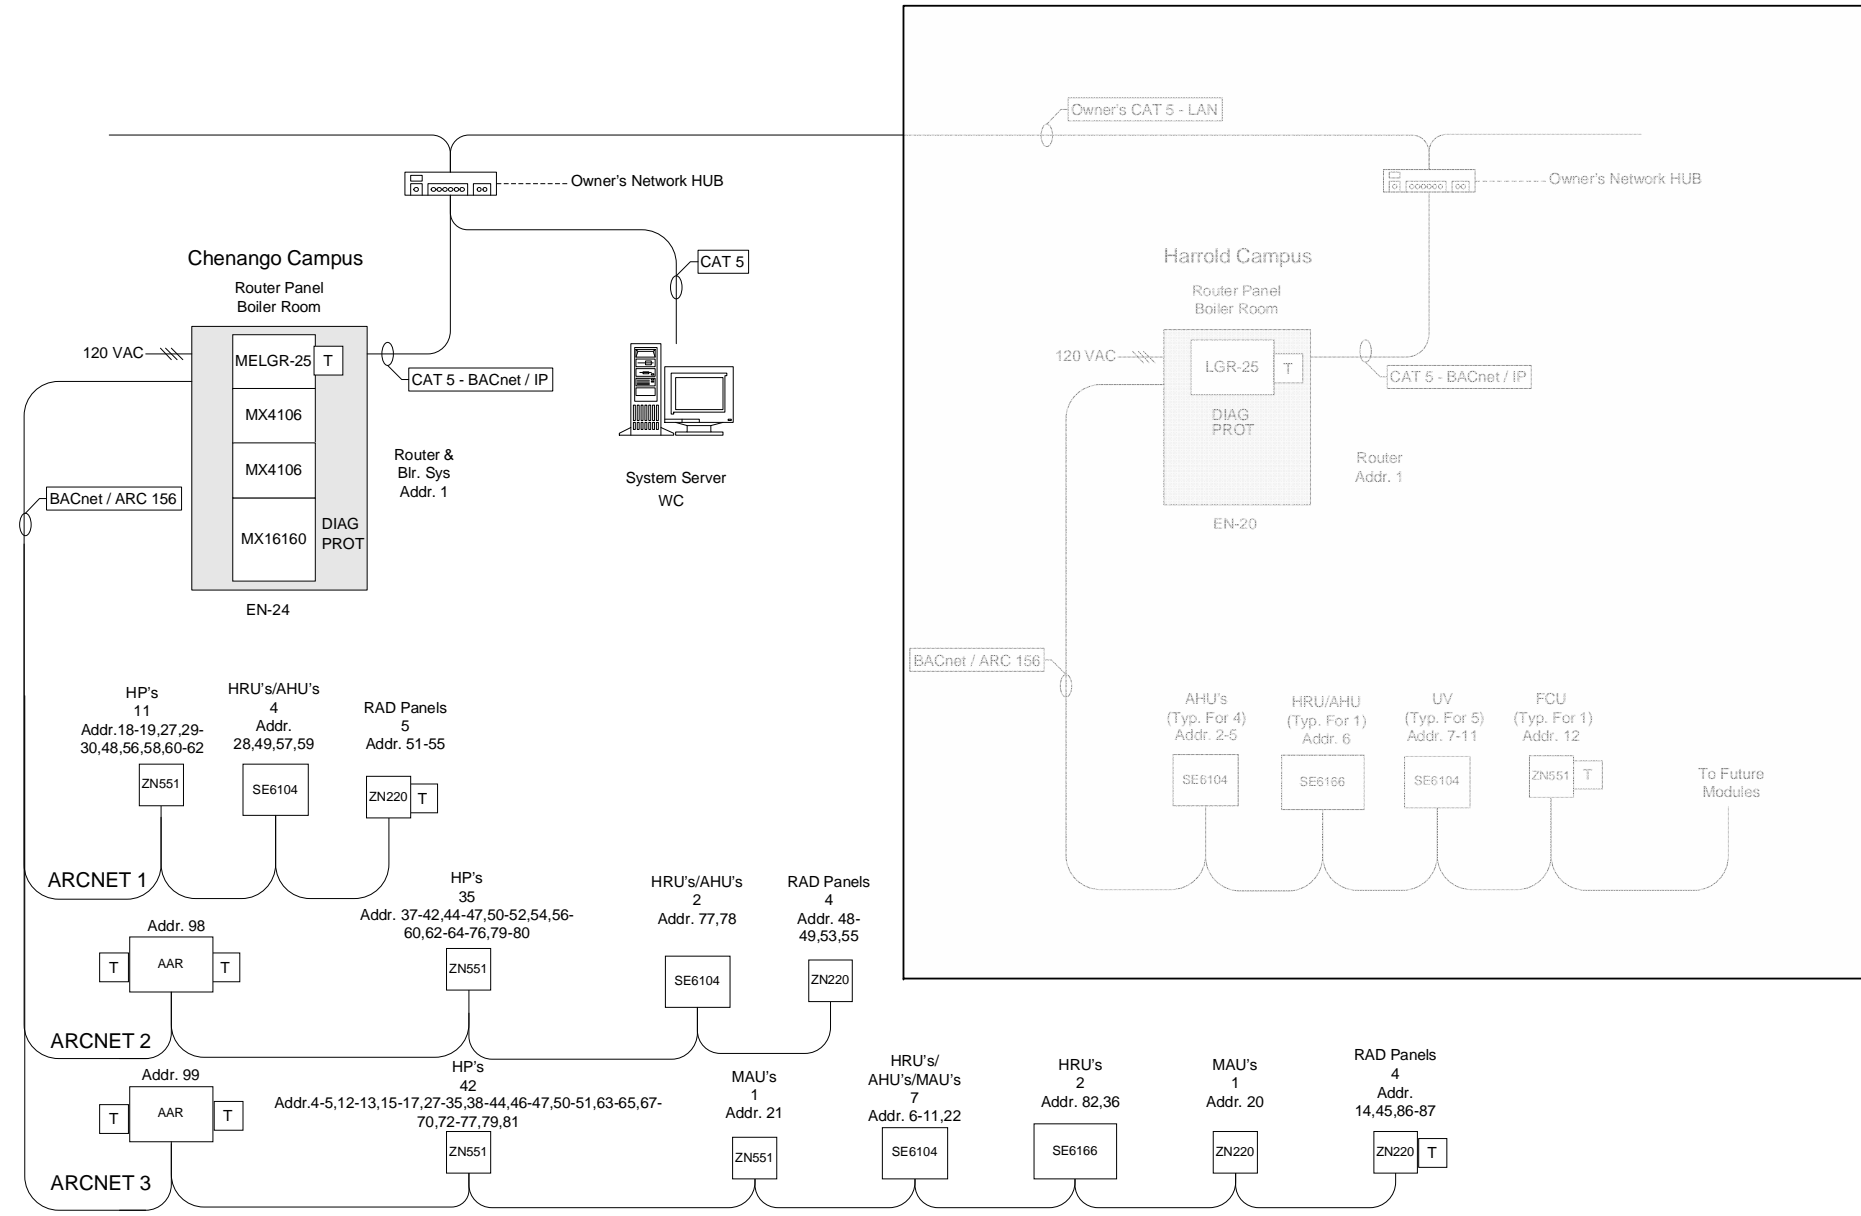

General Notes:
 All ARC156 wiring shall be 22AWG single twisted pair, low capacitance (12.5pF/ft), shielded, plenum rated cable. ALC recommends Magnum Cable Corporation Product number A3ARC156.

Each ARC156 segment must be wired in a daisy chain configuration. Branching requires the use of a REP485.


Each ARC156 segment should have one (1) PROT485 installed to provide protection from electrical surges.

Each ARC156 segment end must be terminated with a TERM485 (120 ohm) terminating resistor.

The ARC156 network segment must have at least one (1) DIAG485 installed to supply bias.

Do not strip back shielded cable sheath more than 1" in order to keep twisted pair from separating. Do not ground shield to the panel or chassis ground. The shield should only be connected to the "Optional Shield" connection at a module.


Routing of communications cabling and control module locations shall be field verified.

DCMO BOCES - Phase 1&2 AS BUILT			
Norwich / Masonville, New York			
Air Temp Heating & Air Conditioning, Inc.			
Riser Diagram			
REV: 1	As-Built	11/19/2007	JOB NO: P7425-7290
			CHECK BY: RSL
			DSCODE:
			5 of 69

Norwich Boiler Room

Chenango Campus

Panel continued from previous page

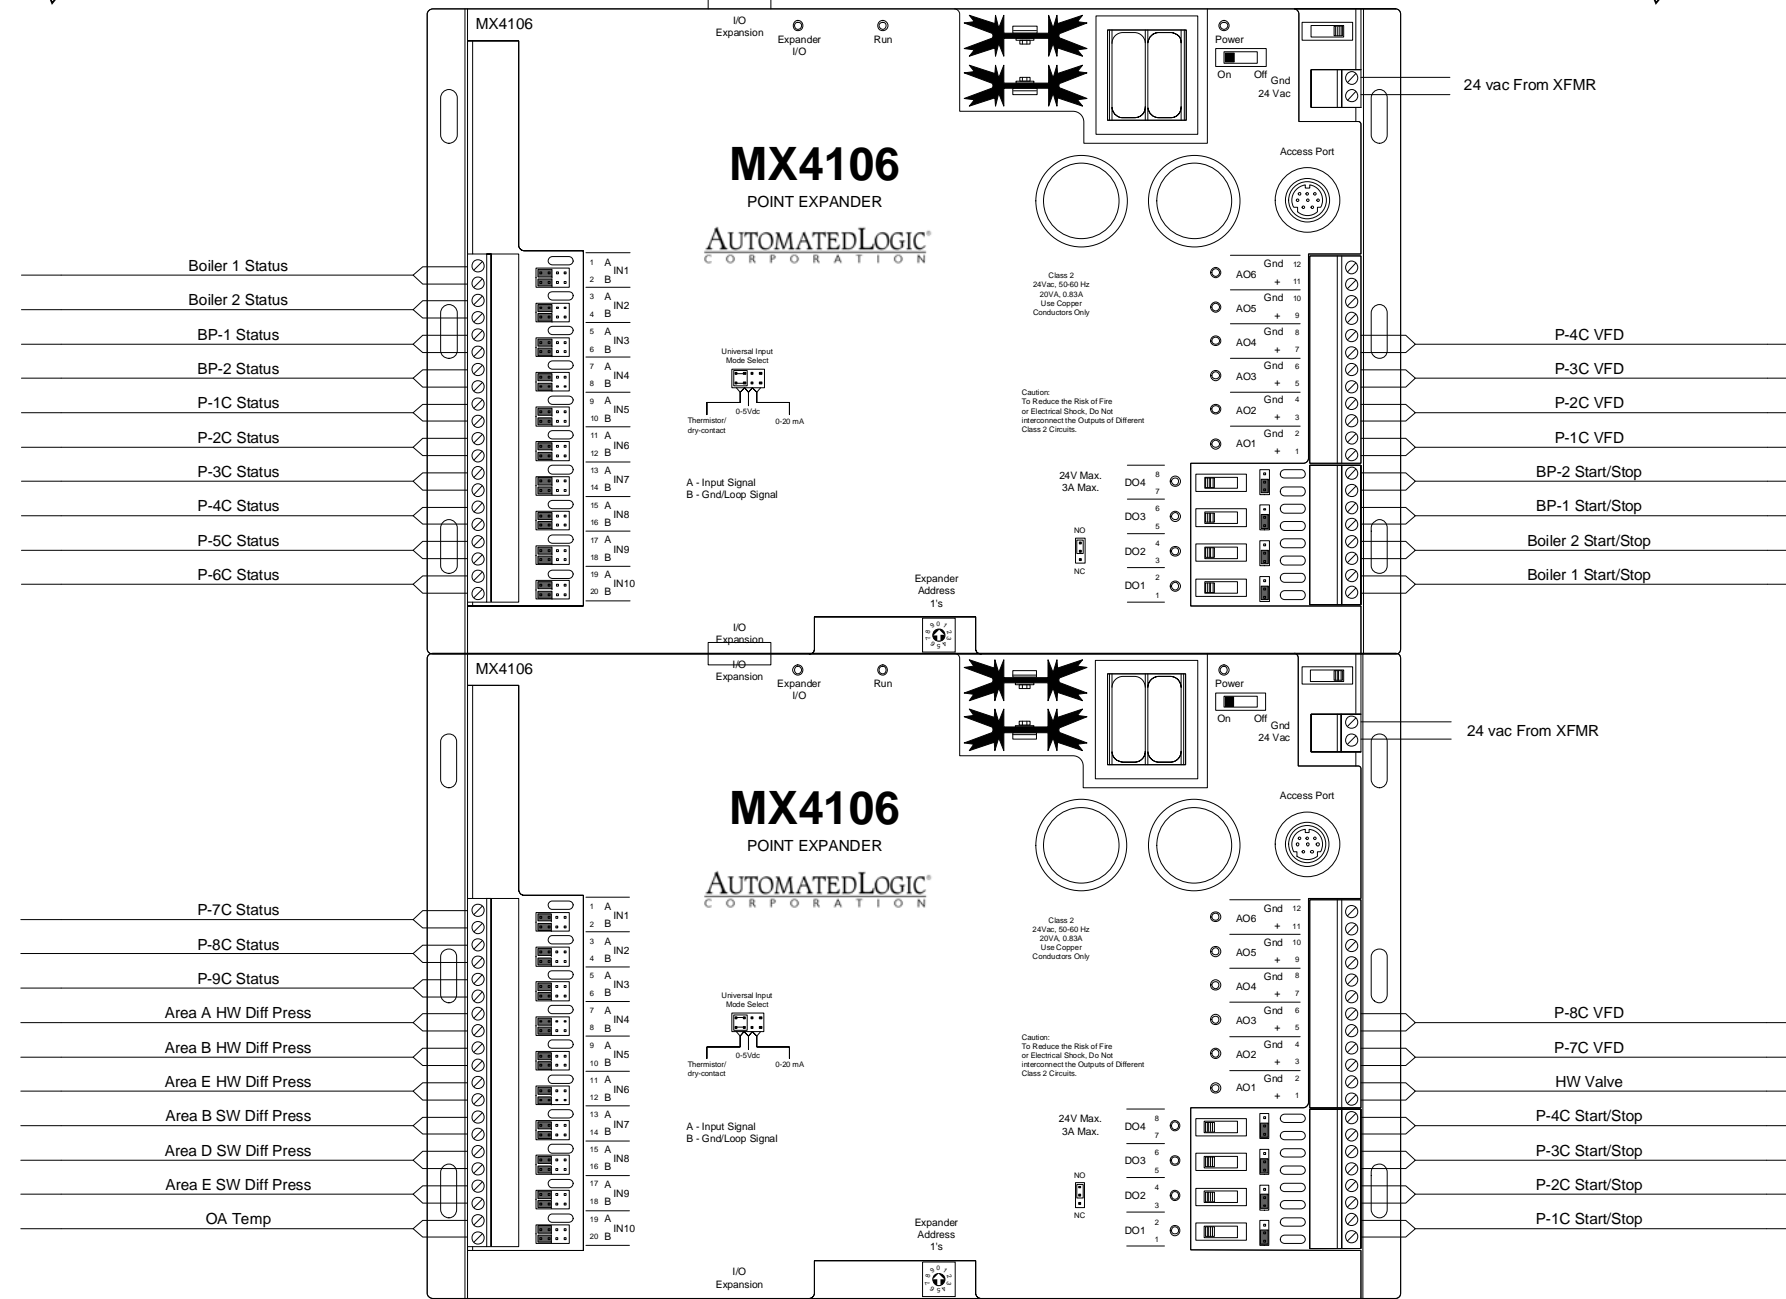

Panel continued on next page

General Notes:

All ARC156 wiring shall be 22AWG single twisted pair, low capacitance (12.5pF/ft), shielded, plenum rated cable. ALC recommends Magnum Cable Corporation Product number A3ARC156.

Each ARC156 segment must be wired in a daisy chain configuration. Branching requires the use of a REP485.

Each ARC156 segment should have one (1) PROT485 installed to provide protection from electrical surges.

Each ARC156 segment end must be terminated with a TERM485 (120 ohm) terminating resistor.

The ARC156 network segment must have at least one (1) DIAG485 installed to supply bias.

Do not strip back shielded cable sheath more than 1" in order to keep twisted pair from separating. Do not ground shield to the panel or chassis ground. The shield should only be connected to the "Optional Shield" connection at a module.

Routing of communications cabling and control module locations shall be field verified.

NORWICH

DCMO BOCES - Phase 1&2 AS BUILT

Norwich / Masonville, New York

Air Temp Heating & Air Conditioning, Inc.

Norwich Boiler Room

REV: 1	As-Built	11/19/2007	JOB NO: P7425-7290
--------	----------	------------	--------------------


CHECK BY: RSL		
---------------	--	--

DSCODE:		
---------	--	--

6 of 69



Panel continued from previous page

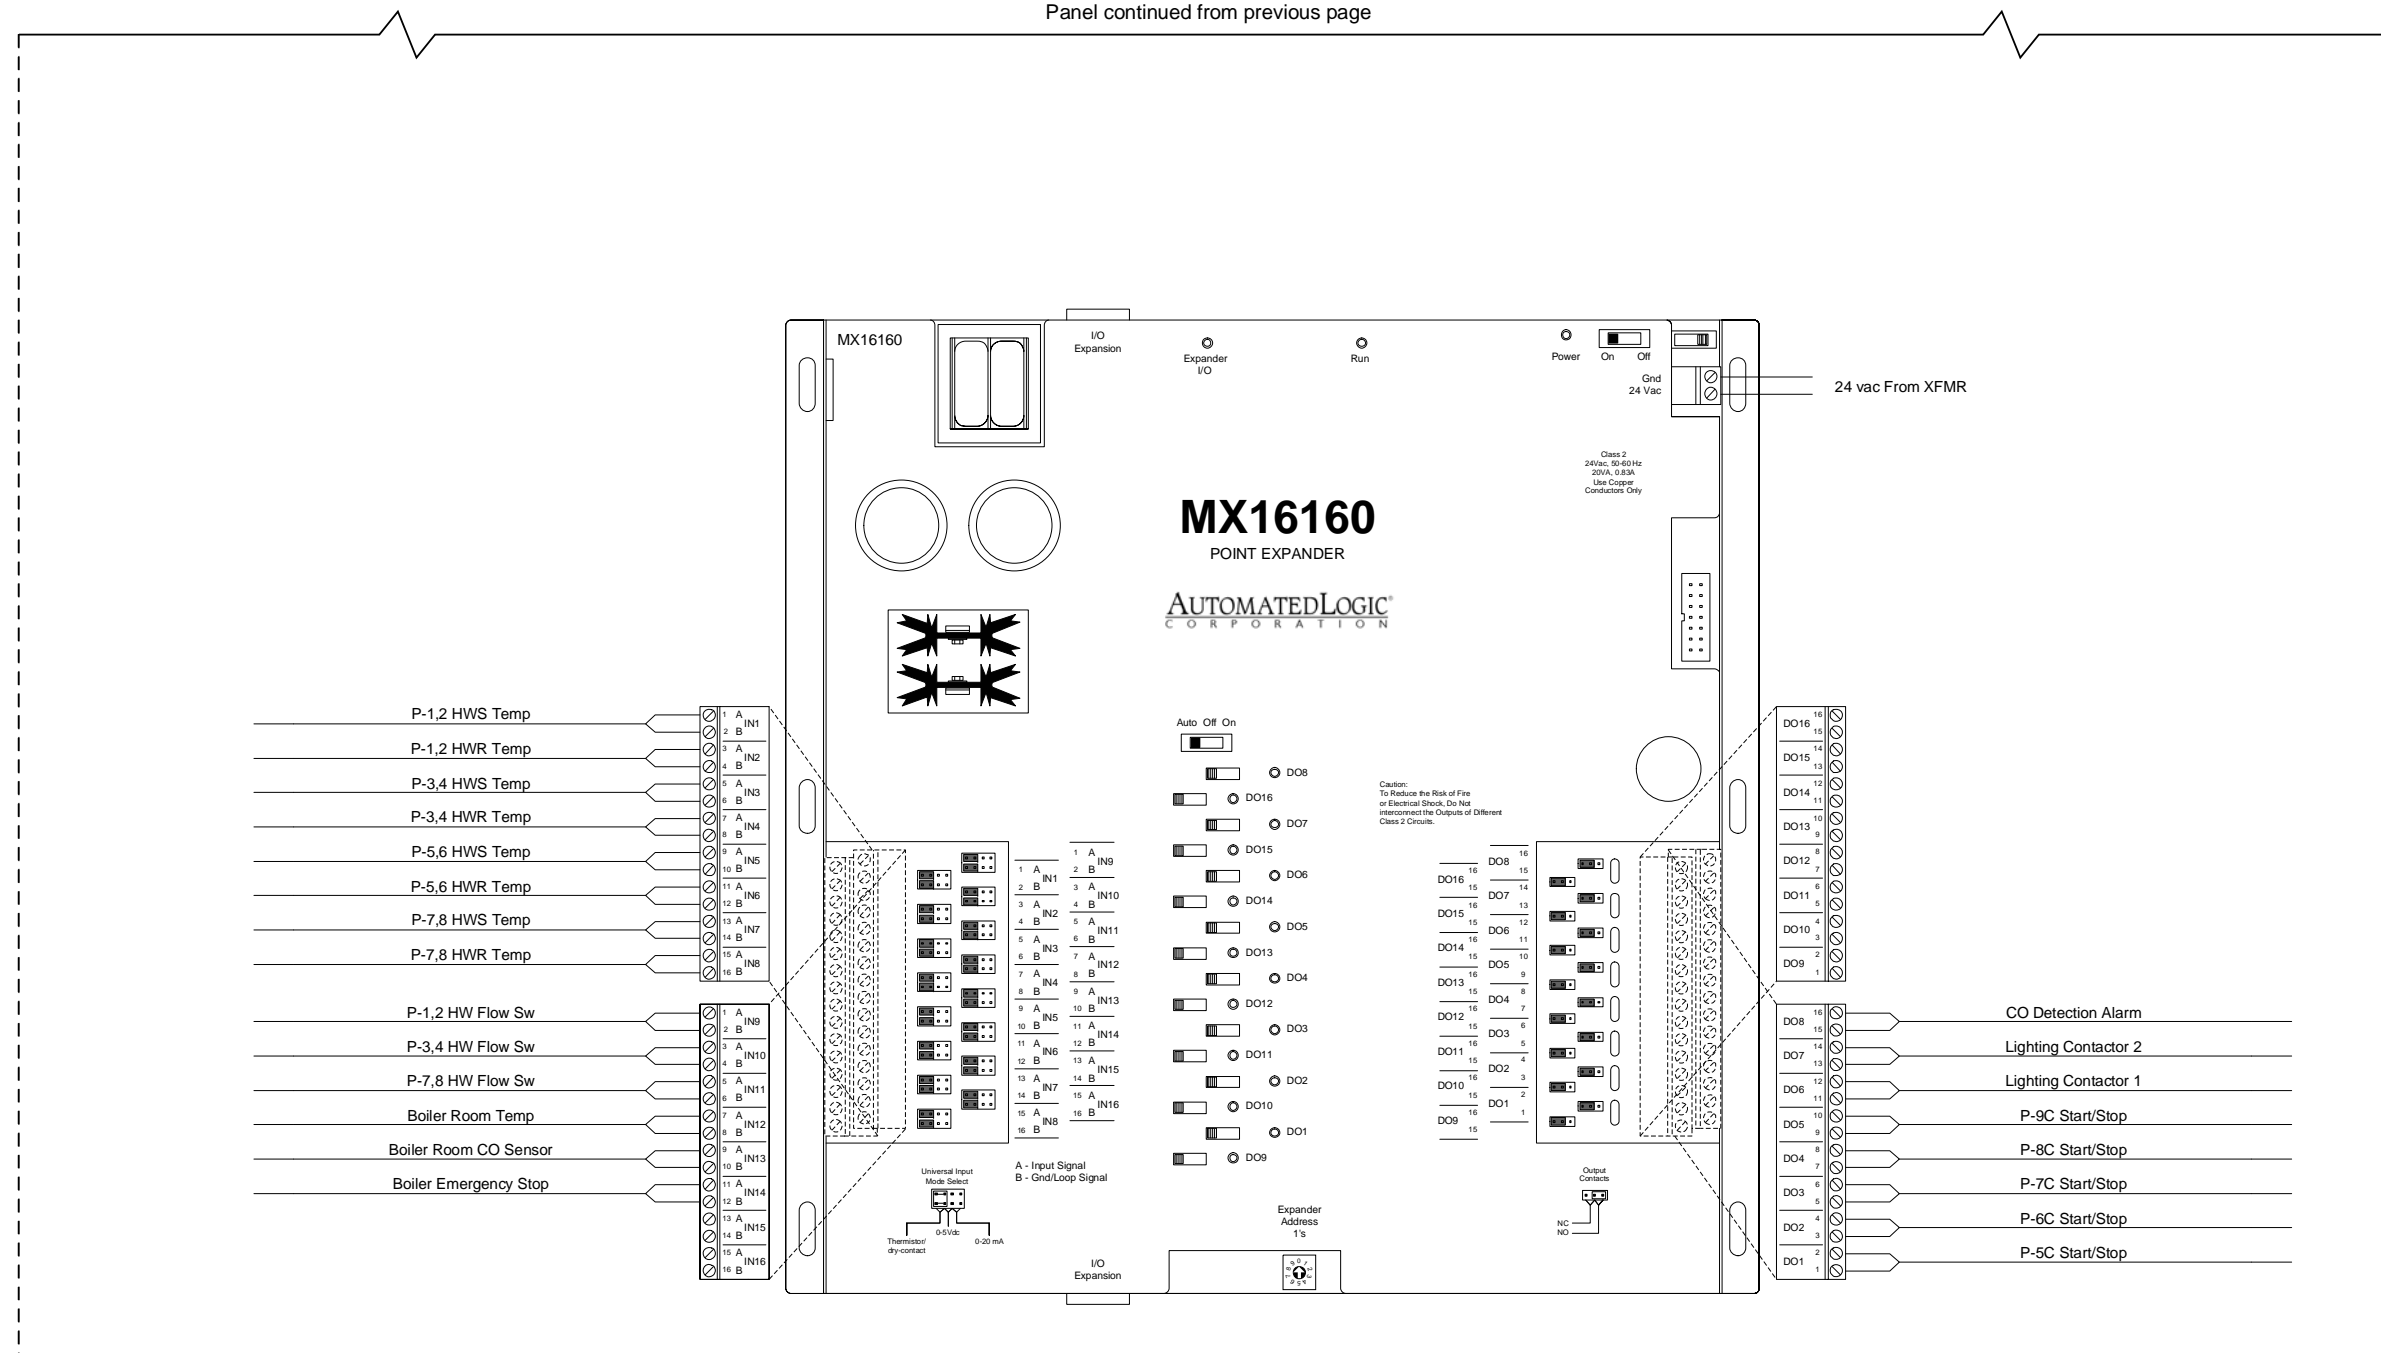

General Notes:

All ARC156 wiring shall be 22AWG single twisted pair, low capacitance (12.5pF/ft), shielded, plenum rated cable. ALC recommends Magnum Cable Corporation Product number A3ARC156.

Each ARC156 segment must be wired in a daisy chain configuration. Branching requires the use of a REP485.

Each ARC156 segment should have one (1) PROT485 installed to provide protection from electrical surges.

Each ARC156 segment end must be terminated with a TERM485 (120 ohm) terminating resistor.

The ARC156 network segment must have at least one (1) DIAG485 installed to supply bias.

Do not strip back shielded cable sheath more than 1" in order to keep twisted pair from separating. Do not ground shield to the panel or chassis ground. The shield should only be connected to the "Optional Shield" connection at a module.


Routing of communications cabling and control module locations shall be field verified.



DCMO BOCES - Phase 1&2 AS BUILT			
Norwich / Masonville, New York			
Air Temp Heating & Air Conditioning, Inc.			
Norwich Boiler Room 2			
REV: 1	As-Built	11/19/2007	JOB NO: P7425-7290
			CHECK BY: RSL
			DSCODE:
			7 of 69




HRU Indoor 1C

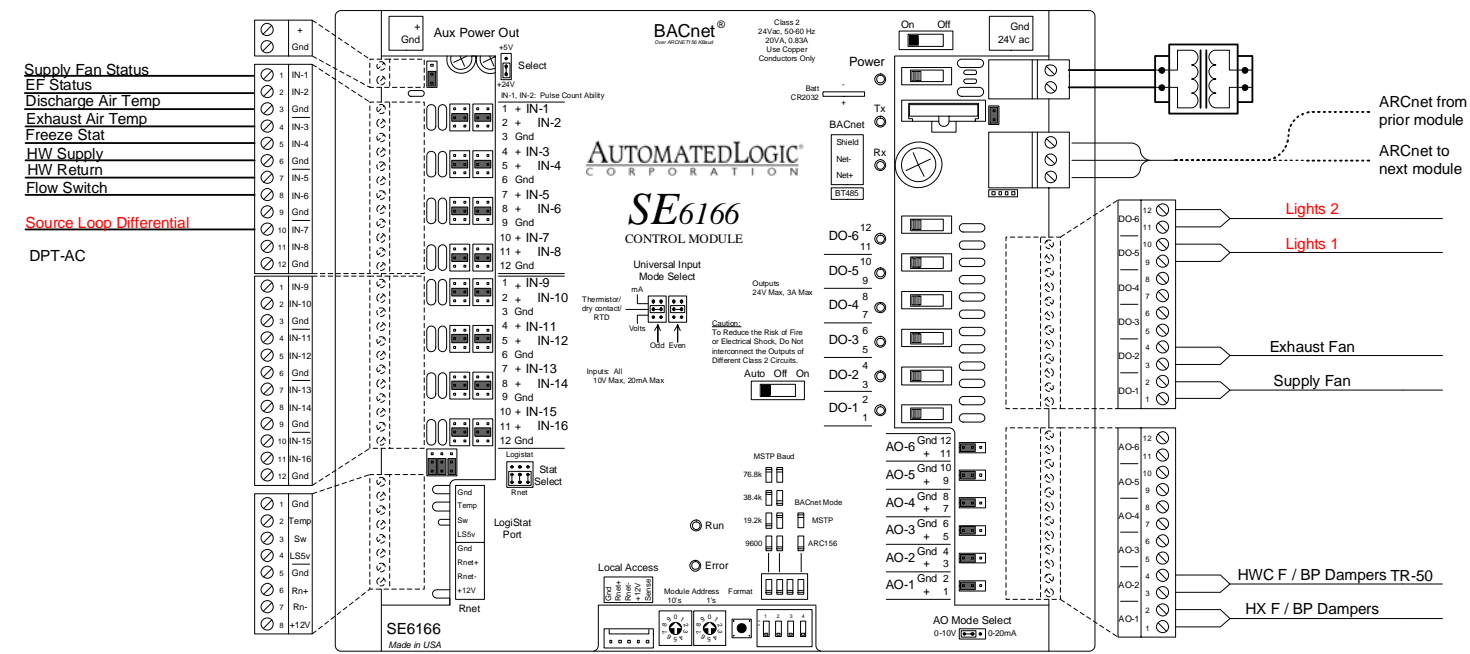

Bill of Materials				
DID	DESCRIPTION	MANUFACTURER	PART NUMBER	QTY
DA-B	SR PROPORTIONAL 133 IN-LB 2-10VDC	BELIMO	AF24-SR ALC	2 ea
DAT	DA TEMP SENSOR	BAPI	BA/10K-2-D-12	2 ea
DPT-AC	DUCT PRESSURE TRANSDUCER 0-5 IN. 4-20MA	MAMAC	PR-276-R10-MA	1 ea
FLOW	FLOW SWITCH	INTEC	DBSF-1KPLN-4US	1 ea
IMMS	IMMERSION TEMP SENSOR	BAPI	BA/10K-2-I-2	2 ea
RIB	RELAY	FUNCTIONAL DEVICES	RIBU1C	2 ea
RIBX	CURRENT SWITCH	FUNCTIONAL DEVICES	RIBXKF	2 ea
SE6166	SE6166	AUTOMATED LOGIC	SE6166	1 ea
TR-50	TRANSFORMER, 120/24VAC, 50VA	FUNCTIONAL DEVICES	TR50VA002	9 ea
WELS	IMMERSION TEMP SENSOR WELL	BAPI	BA/2	2 ea

HRU 1C Network 2 Address 77

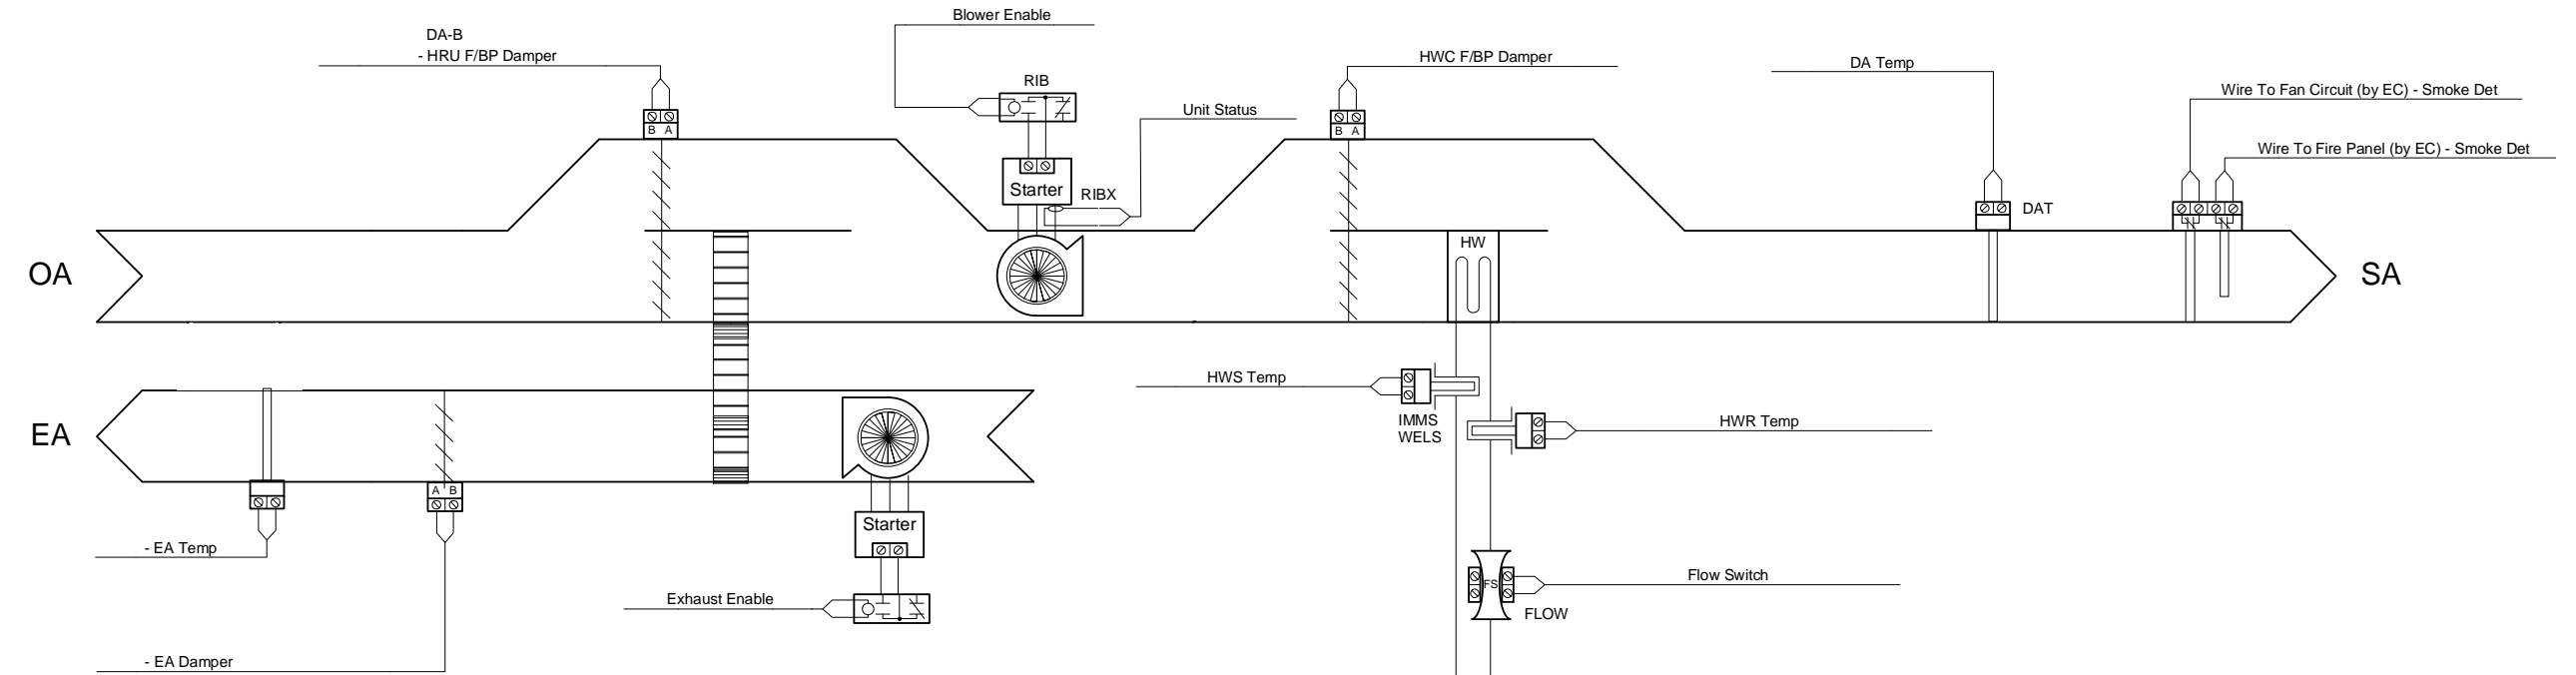

NORWICH

DCMO BOCES - Phase 1&2 AS BUILT
 Norwich / Masonville, New York

Air Temp Heating & Air Conditioning, Inc.


HRU Indoor 1C

REV: 1	As-Built	11/19/2007	JOB NO: P7425-7290
			CHECK BY: RSL
			DSCODE:

AIR TEMP HEATING & AIR CONDITIONING, INC.
 A LINC SERVICE CONTRACTOR


8 of 69

HRU Indoor 2C

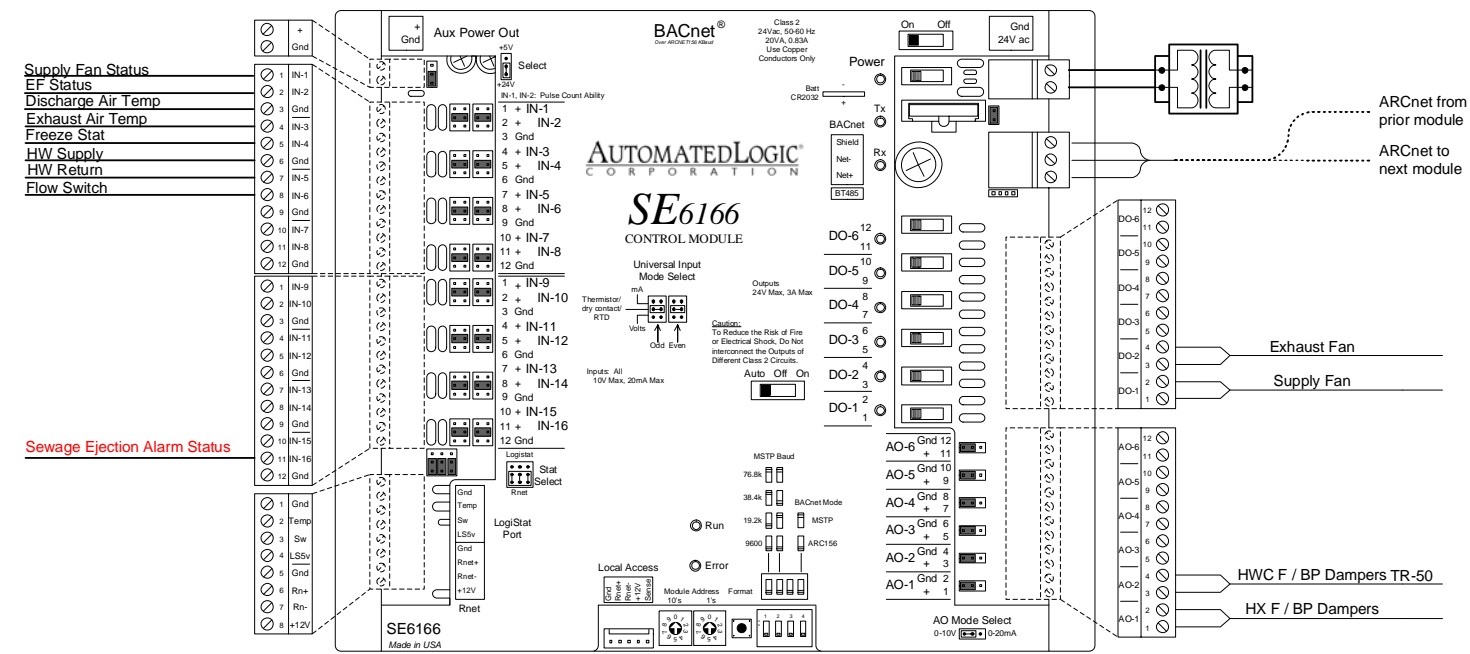

Bill of Materials				
DID	DESCRIPTION	MANUFACTURER	PART NUMBER	QTY
DA-B	SR PROPORTIONAL 133 IN-LB 2-10VDC	BELIMO	AF24-SR ALC	4 ea
DAT	DA TEMP SENSOR	BAPI	BA/10K-2-D-12	4 ea
FLOW	FLOW SWITCH	INTEC	DBSF-1KPLN-4US	2 ea
IMMS	IMMERSION TEMP SENSOR	BAPI	BA/10K-2-I-2	4 ea
RIB	RELAY	FUNCTIONAL DEVICES	RIBU1C	4 ea
RIBX	CURRENT SWITCH	FUNCTIONAL DEVICES	RIBXKF	4 ea
SE6166	SE6166	AUTOMATED LOGIC	SE6166	2 ea
TR-50	TRANSFORMER, 120/24VAC, 50VA	FUNCTIONAL DEVICES	TR50VA002	9 ea
WELS	IMMERSION TEMP SENSOR WELL	BAPI	BA/2	4 ea

HRU 2C Network 2 Address 78

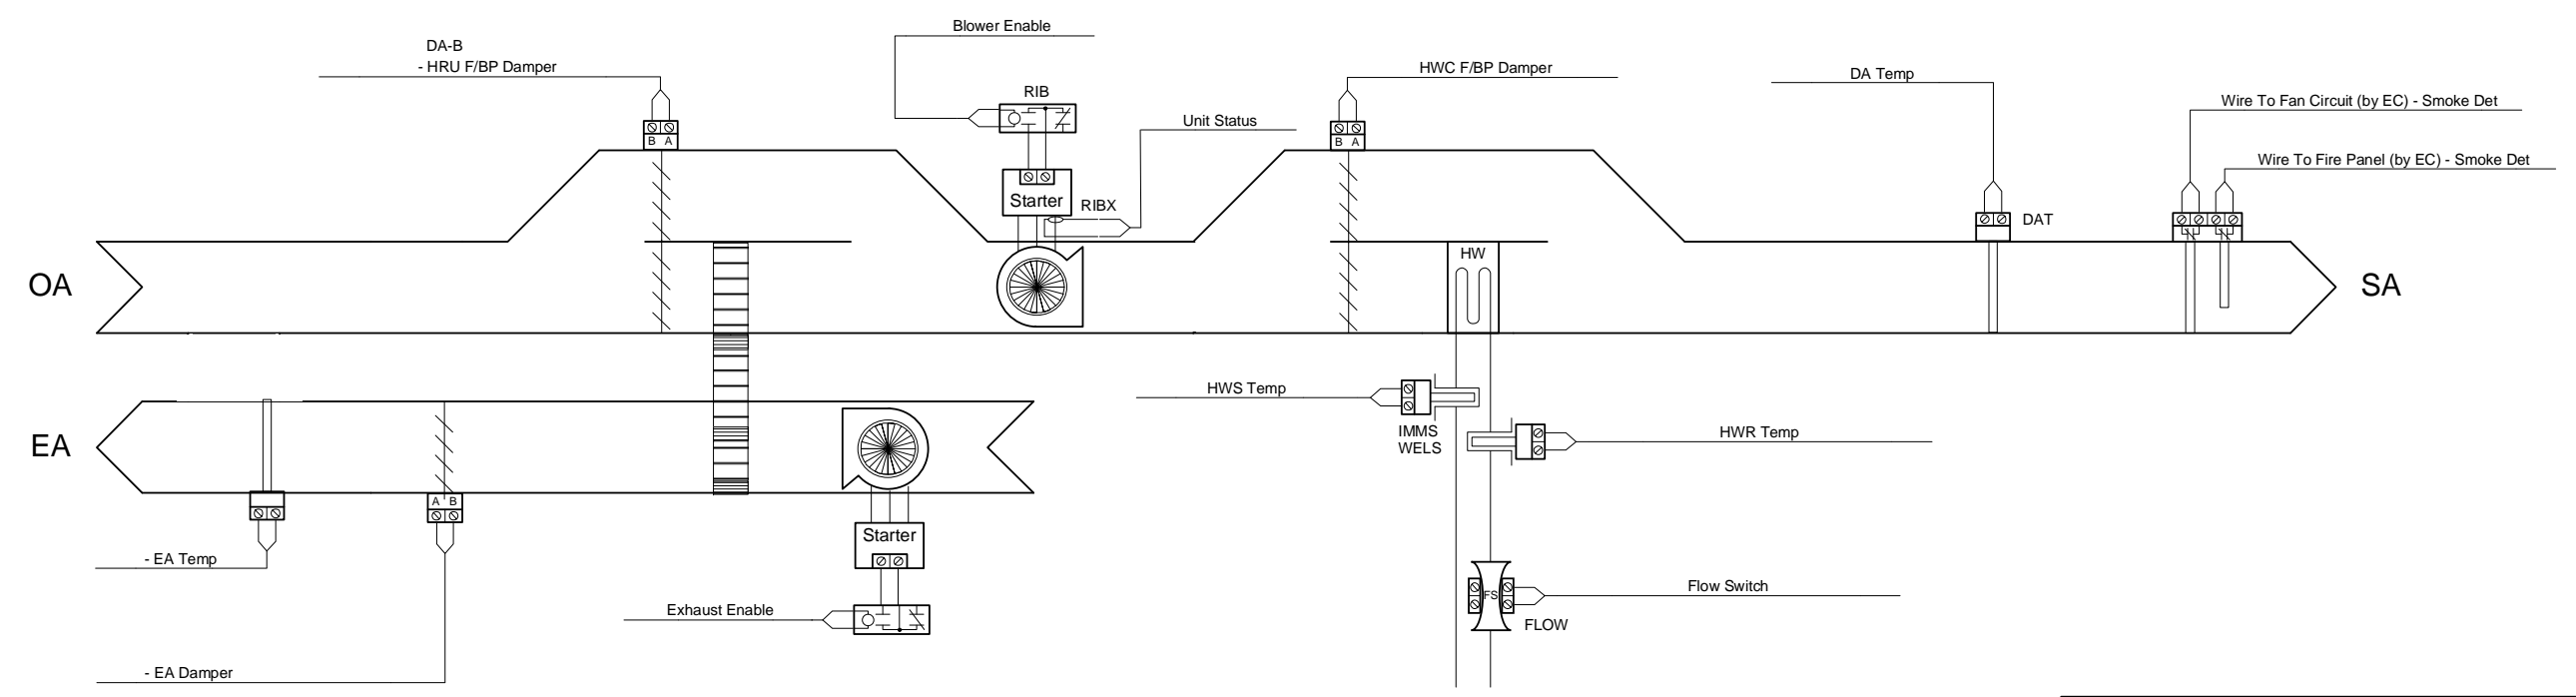


NORWICH


DCMO BOCES - Phase 1&2 AS BUILT			
Norwich / Masonville, New York			
Air Temp Heating & Air Conditioning, Inc.			
HRU Indoor 2C			
REV: 1	As-Built	11/19/2007	JOB NO: P7425-7290
CHECK BY: RSL			DSCODE:
			9 of 69

HRU INDOOR 3C, 4C

Bill of Materials				
DID	DESCRIPTION	MANUFACTURER	PART NUMBER	QTY
DA-B	SR PROPORTIONAL 133 IN-LB 2-10VDC	BELIMO	AF24-SR ALC	4 ea
DAT	DA TEMP SENSOR	BAPI	BA/10K-2-D-12	4 ea
FLOW	FLOW SWITCH	INTEC	DBSF-1KPLN-4US	2 ea
IMMS	IMMERSON TEMP SENSOR	BAPI	BA/10K-2-I-2	4 ea
RIB	RELAY	FUNCTIONAL DEVICES	RIBU1C	4 ea
RIBX	CURRENT SWITCH	FUNCTIONAL DEVICES	RIBXKF	4 ea
SE6166	SE6166	AUTOMATED LOGIC	SE6166	2 ea
TR-50	TRANSFORMER, 120/24VAC, 50VA	FUNCTIONAL DEVICES	TR50VA002	9 ea
WELS	IMMERSON TEMP SENSOR WELL	BAPI	BA/2	4 ea

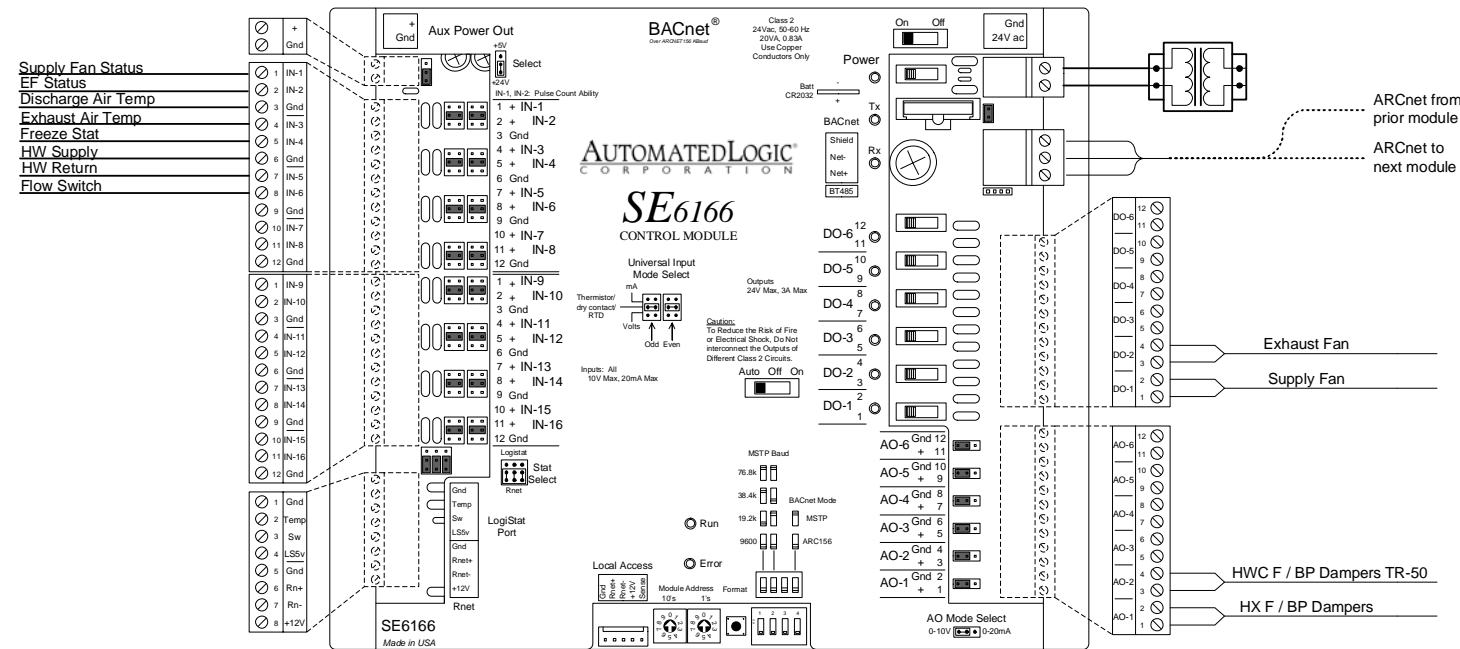

HRU 3C Network 1 Address 28
 HRU 4C Network 1 Address 59

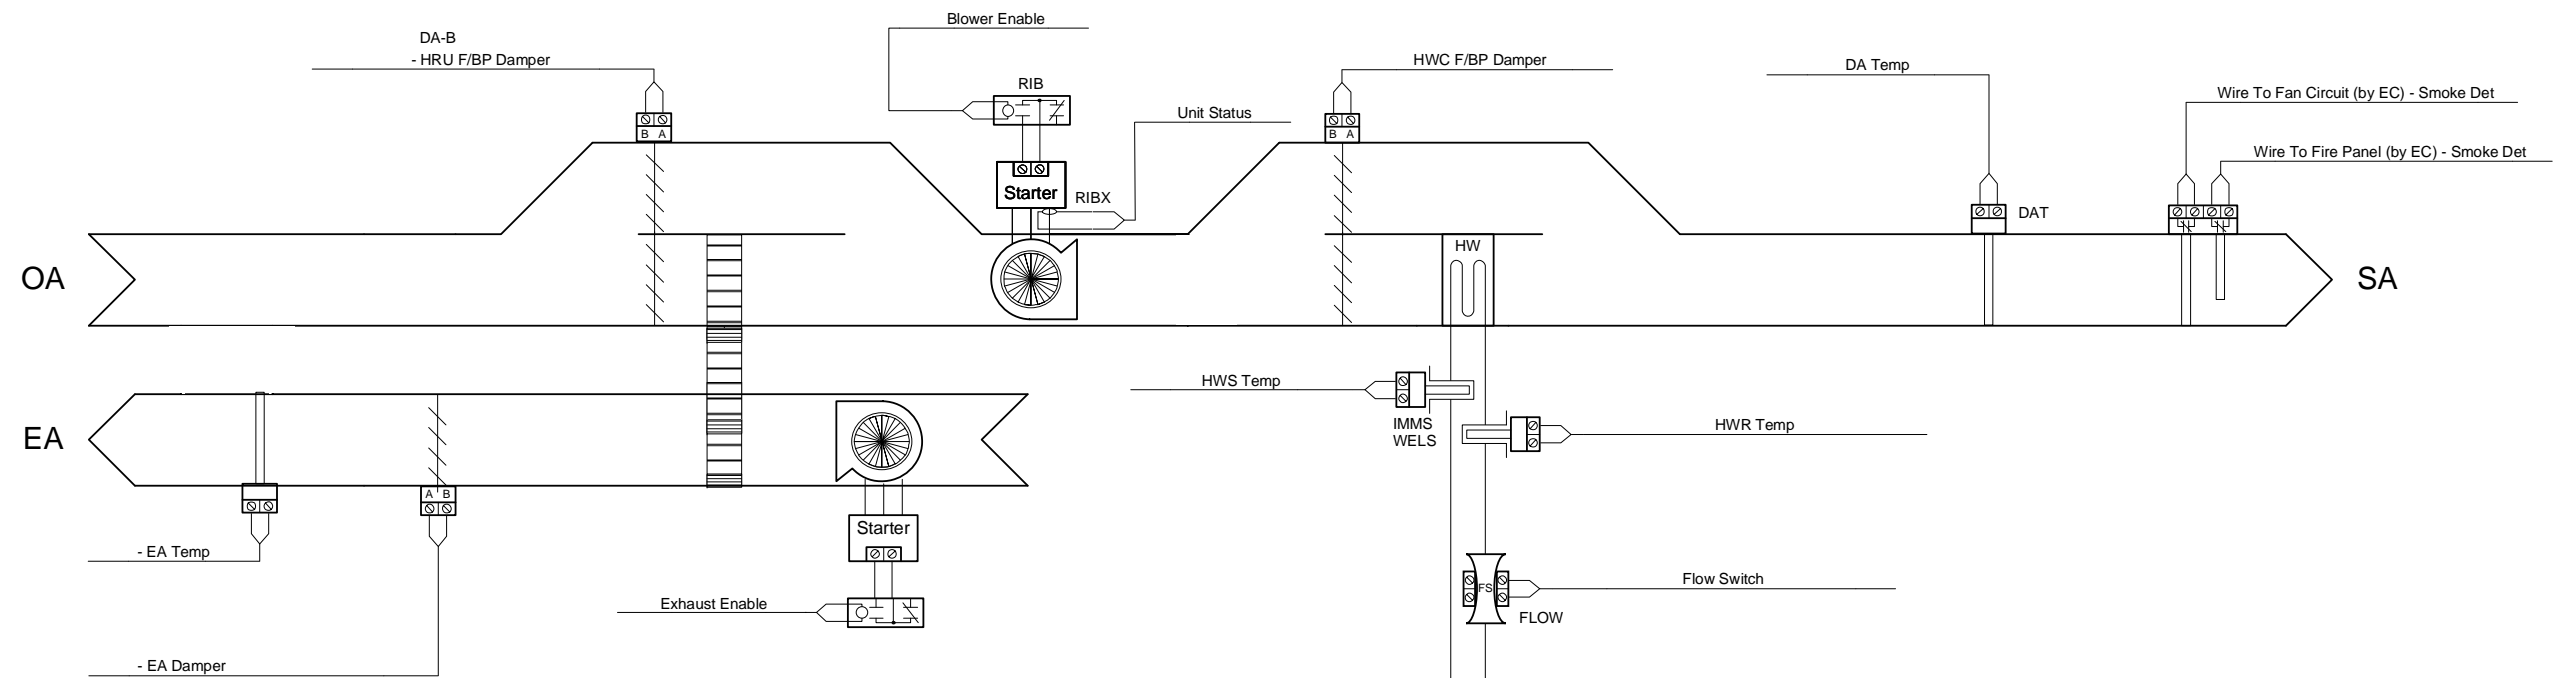


NORWICH

DCMO BOCES - Phase 1&2 AS BUILT			
Norwich / Masonville, New York			
Air Temp Heating & Air Conditioning, Inc.			
HRU INDOOR 3C, 4C			
REV: 1	As-Built	11/19/2007	JOB NO: P7425-7290
CHECK BY: RSL			DSCODE:
			10 of 69


HRU ROOF

Bill of Materials				
DID	DESCRIPTION	MANUFACTURER	PART NUMBER	QTY
DAT	DA TEMP SENSOR	BAPI	BA/10K-2-D-12	4 ea
FLOW	FLOW SWITCH	INTEC	DBSF-1KPLN-4US	4 ea
IMMS	IMMERSION TEMP SENSOR	BAPI	BA/10K-2-I-2	8 ea
RIB	RELAY	FUNCTIONAL DEVICES	RIBU1C	4 ea
RIBX	CURRENT SWITCH	FUNCTIONAL DEVICES	RIBXKF	4 ea
SE6104	CONTROL MODULE	AUTOMATED LOGIC	SE6104	4 ea
TR-50	TRANSFORMER, 120/24VAC, 50VA	FUNCTIONAL DEVICES	TR50VA002	4 ea
WELS	IMMERSION TEMP SENSOR WELL	BAPI	BA/2	8 ea

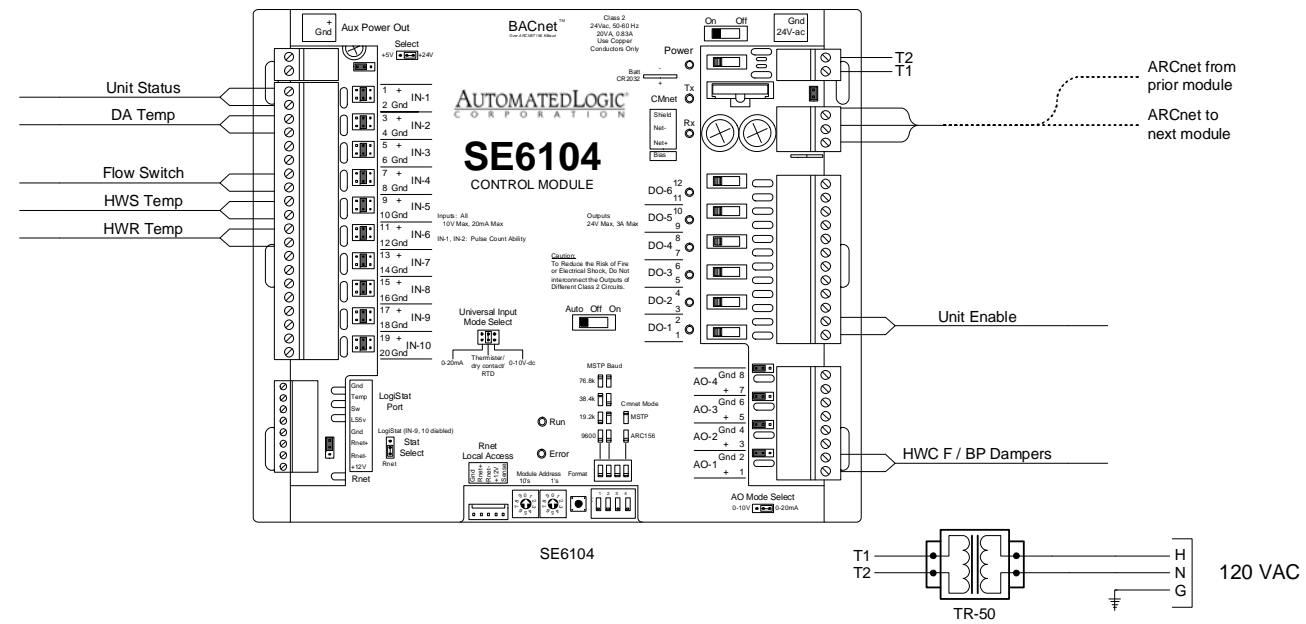


HRU 1C COSMO
 HRU 7C COSMO
 HRU 6C
 HRU 5C


Network 3 Address 66
 Network 3 Address 22
 Network 3 Address 82
 Network 3 Address 36

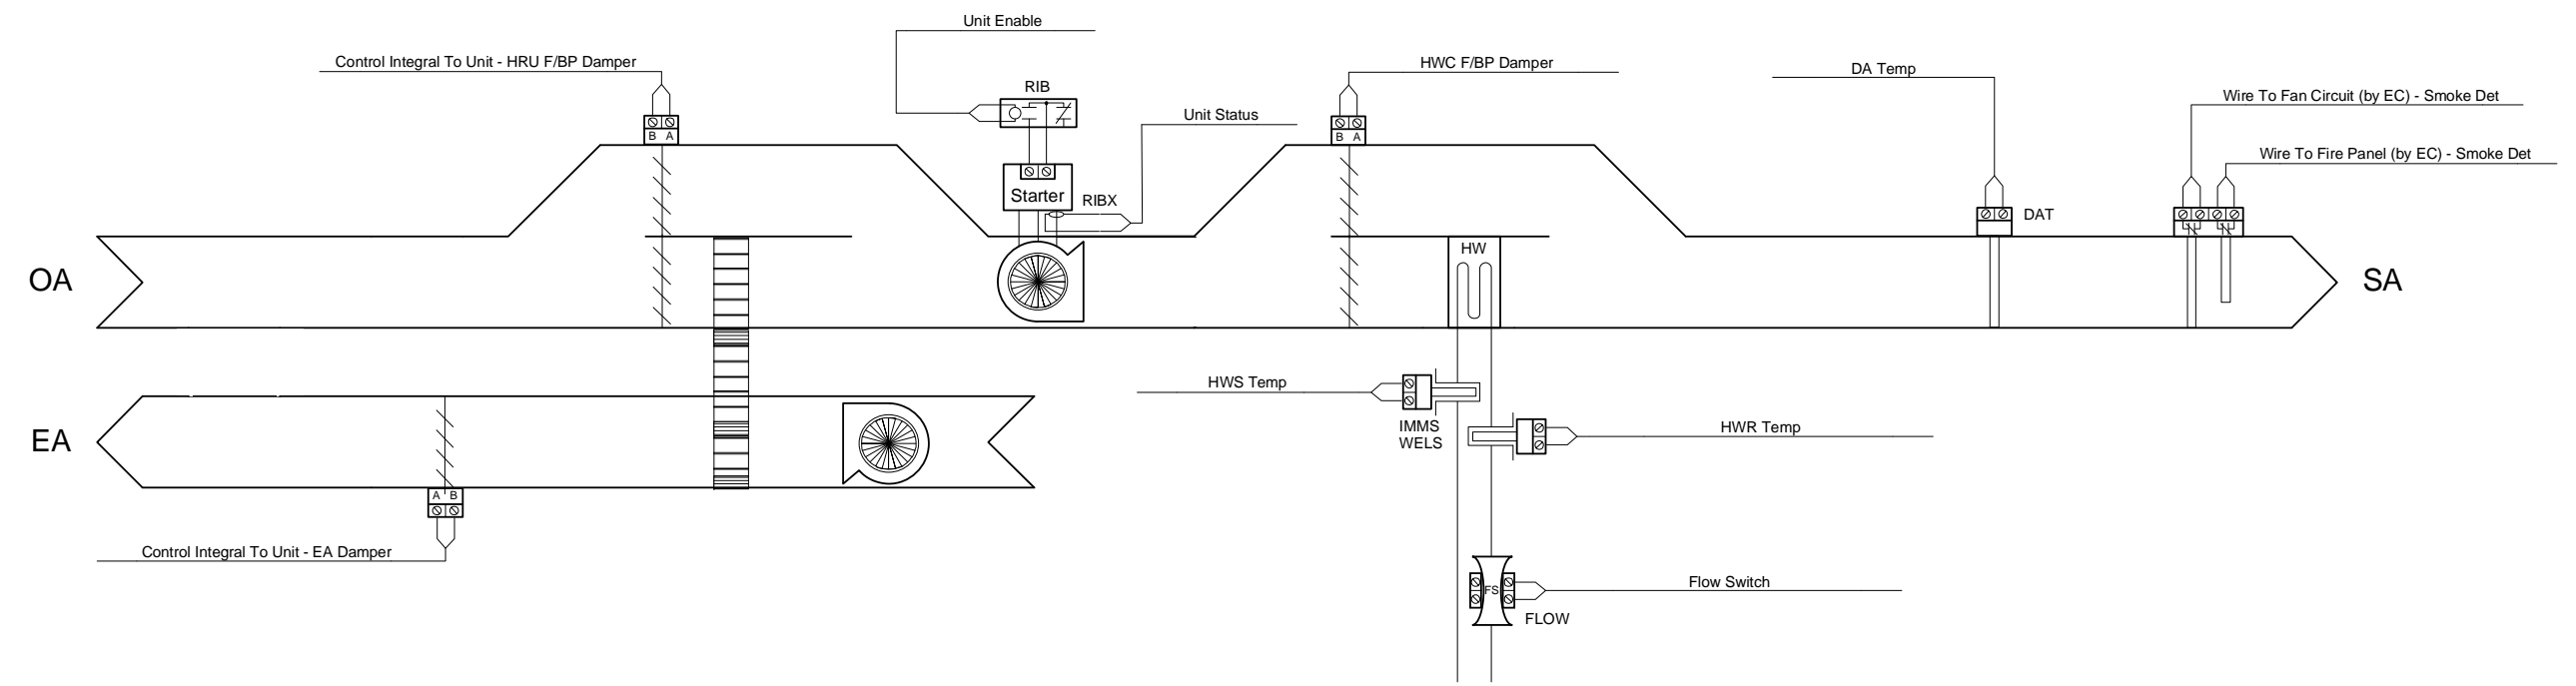

NORWICH


DCMO BOCES - Phase 1&2 AS BUILT			
Norwich / Masonville, New York			
Air Temp Heating & Air Conditioning, Inc.			
HRU ROOF			
REV: 1	As-Built	11/19/2007	JOB NO: P7425-7290
			CHECK BY: RSL
			DSCODE:
11 of 69			

AHU 1C

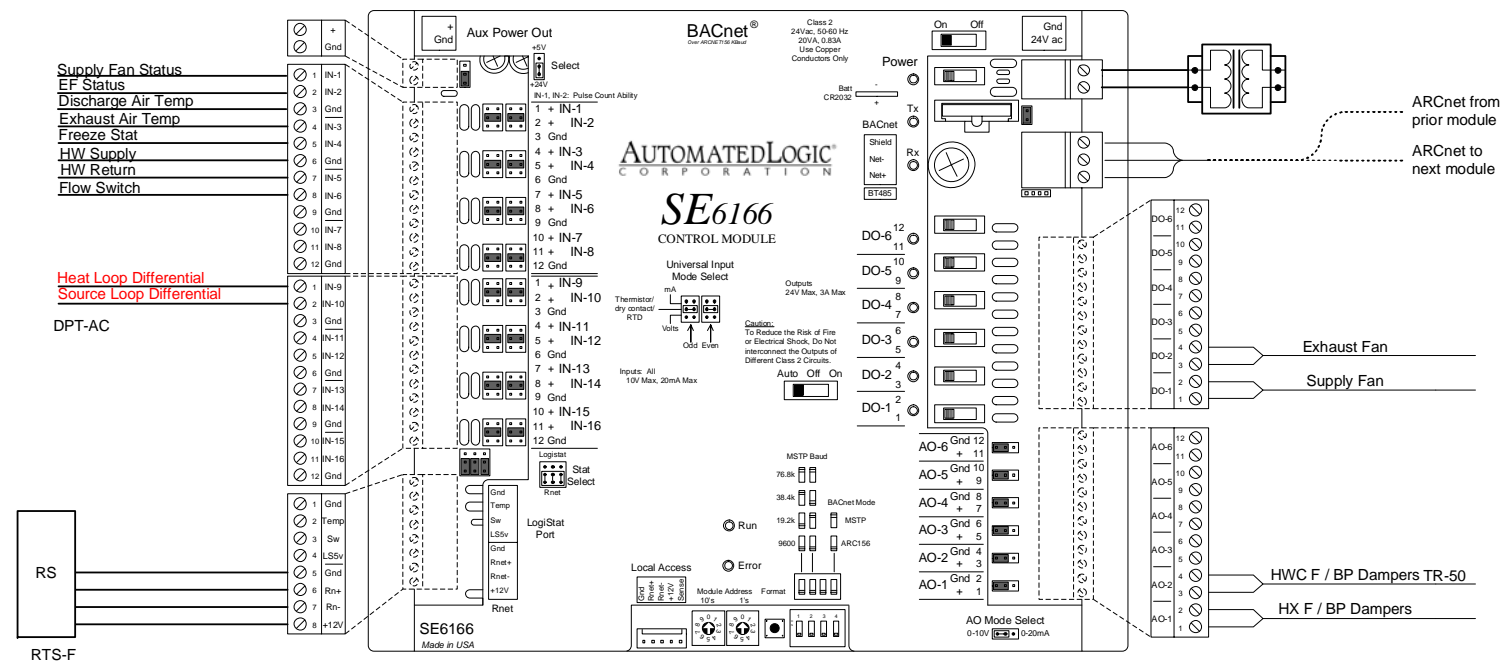

Bill of Materials				
DID	DESCRIPTION	MANUFACTURER	PART NUMBER	QTY
DA-B	SR PROPORTIONAL 133 IN-LB 2-10VDC	BELIMO	AF24-SR ALC	2 ea
DAT	DA TEMP SENSOR	BAPI	BA/10K-2-D-12	2 ea
DPT-AC	DUCT PRESSURE TRANSDUCER 0-5 IN. 4-20MA	MAMAC	PR-276-R10-MA	2 ea
FLOW	FLOW SWITCH	INTEC	DBSF-1KPLN-4US	1 ea
IMMS	IMMERSION TEMP SENSOR	BAPI	BA/10K-2-I-2	2 ea
RIB	RELAY	FUNCTIONAL DEVICES	RIBU1C	2 ea
RIBX	CURRENT SWITCH	FUNCTIONAL DEVICES	RIBXKF	2 ea
RTS-F	10K ROOM THERMISTOR RS	BAPI	ALC/10K-2-RS	1 ea
SE6166	SE6166	AUTOMATED LOGIC	SE6166	1 ea
TR-50	TRANSFORMER, 120/24VAC, 50VA	FUNCTIONAL DEVICES	TR50VA002	9 ea
WELS	IMMERSION TEMP SENSOR WELL	BAPI	BA/2	2 ea

HRU 1C Gym Network 1 Address 49

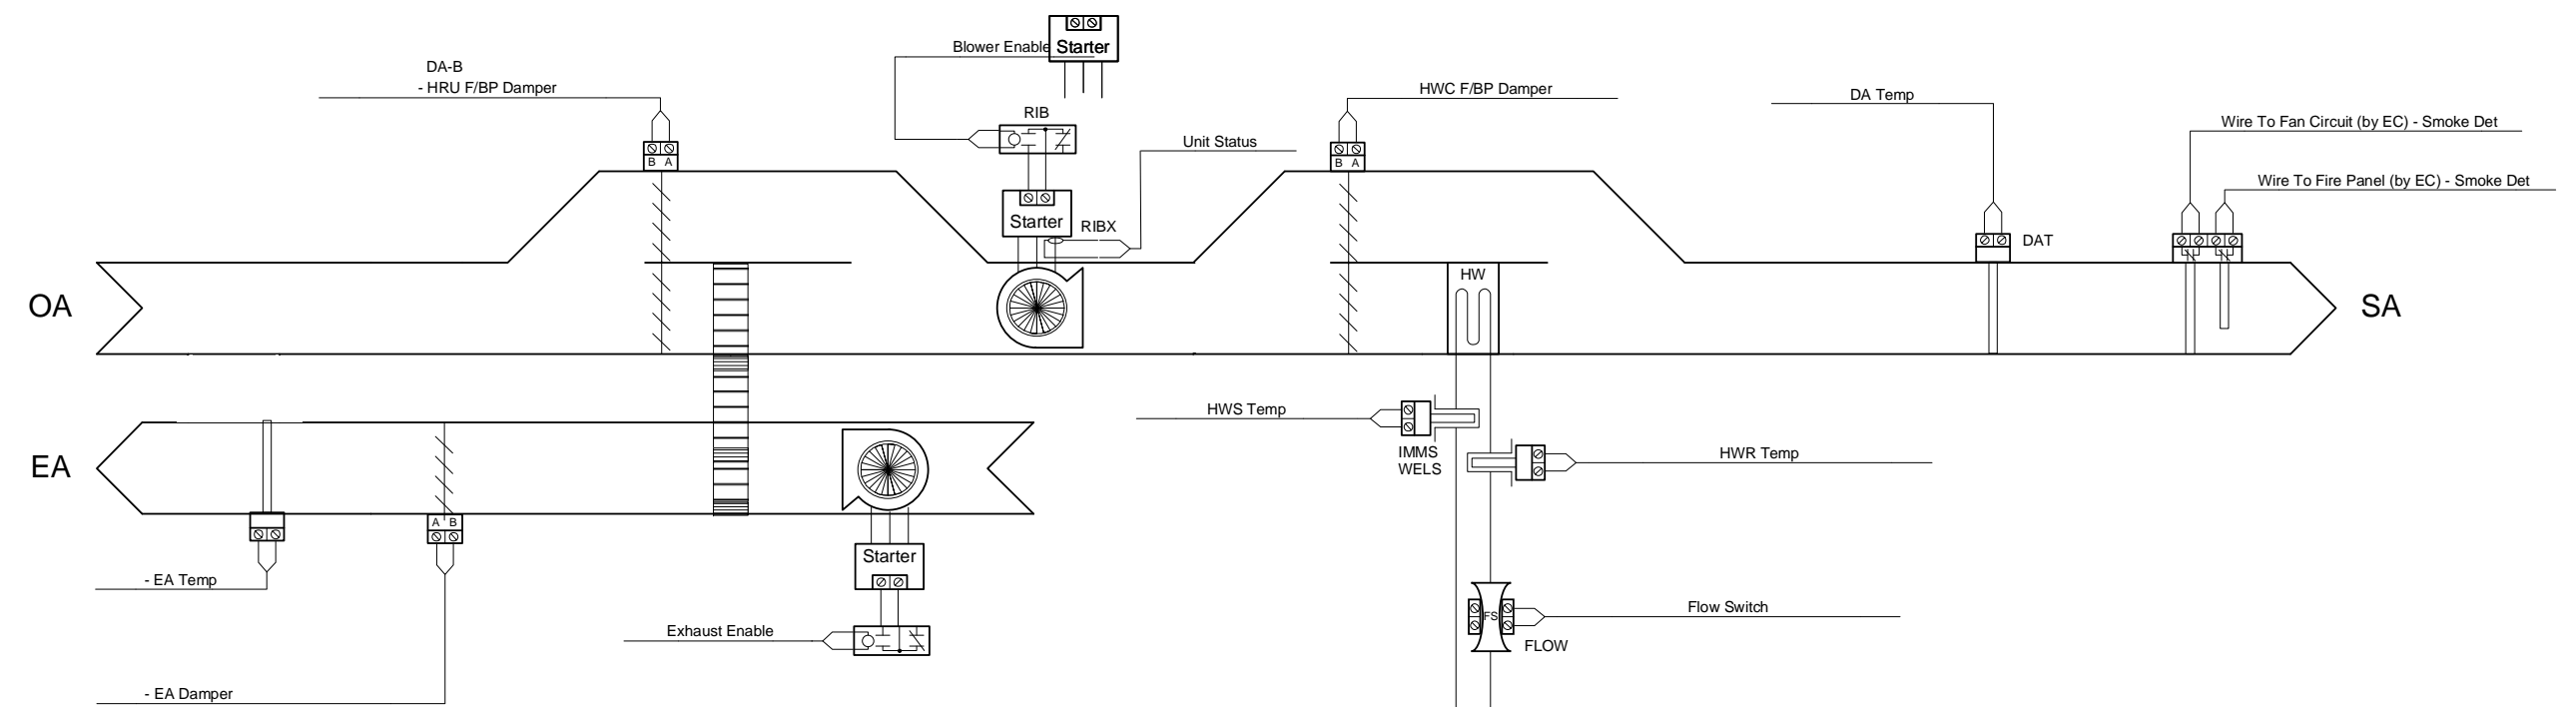

NORWICH

DCMO BOCES - Phase 1&2 AS BUILT
 Norwich / Masonville, New York

Air Temp Heating & Air Conditioning, Inc.


AHU 1C

REV: 1	As-Built	11/19/2007	JOB NO: P7425-7290
CHECK BY: RSL			DSCODE:

AIR TEMP HEATING & AIR CONDITIONING, INC.
 A LINC SERVICE CONTRACTOR


12 of 69

AHU 2C

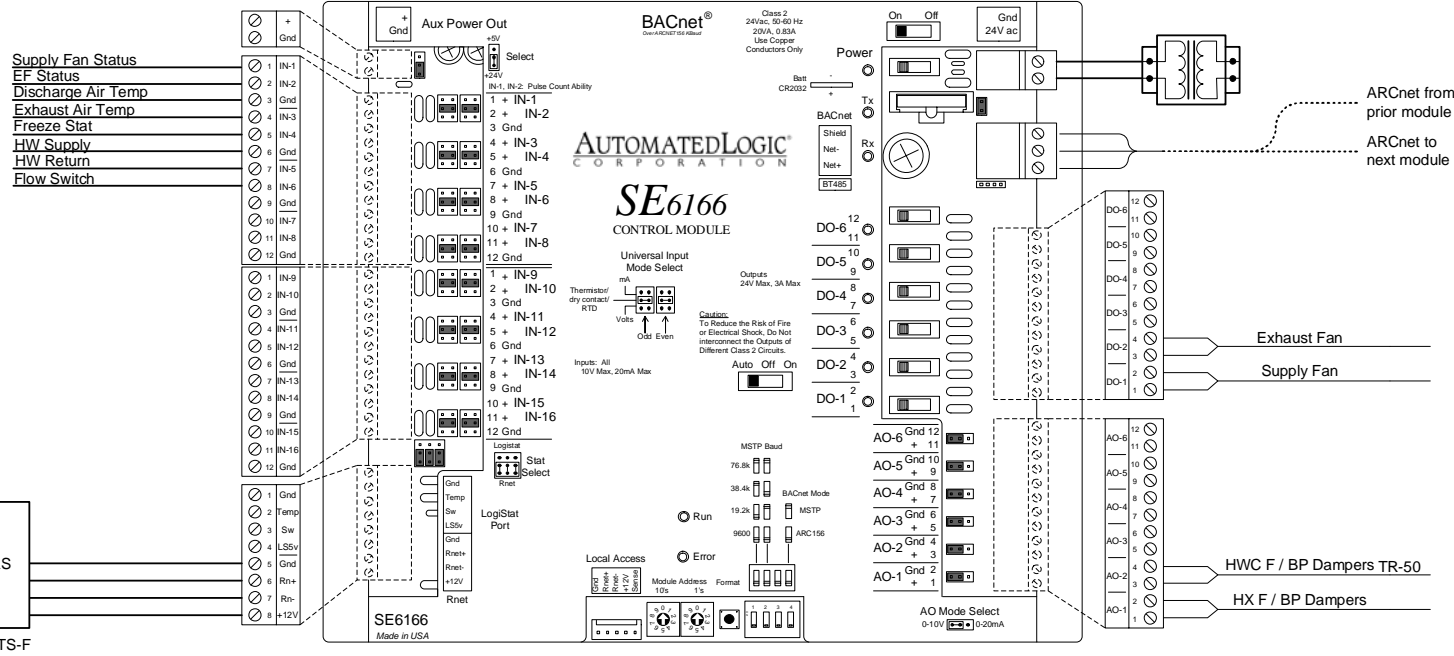

Bill of Materials				
DID	DESCRIPTION	MANUFACTURER	PART NUMBER	QTY
DA-B	SR PROPORTIONAL 133 IN-LB 2-10VDC	BELIMO	AF24-SR ALC	4 ea
DAT	DA TEMP SENSOR	BAPI	BA/10K-2-D-12	4 ea
FLOW	FLOW SWITCH	INTEC	DBSF-1KPLN-4US	2 ea
IMMS	IMMERSION TEMP SENSOR	BAPI	BA/10K-2-I-2	4 ea
RIB	RELAY	FUNCTIONAL DEVICES	RIBU1C	4 ea
RIBX	CURRENT SWITCH	FUNCTIONAL DEVICES	RIBXKF	4 ea
RTS-F	10K ROOM THERMISTOR RS	BAPI	ALC/10K-2-RS	1 ea
SE6166	SE6166	AUTOMATED LOGIC	SE6166	2 ea
TR-50	TRANSFORMER, 120/24VAC, 50VA	FUNCTIONAL DEVICES	TR50VA002	9 ea
WELS	IMMERSION TEMP SENSOR WELL	BAPI	BA/2	4 ea

HRU 2C Gym Network 1 Address 57

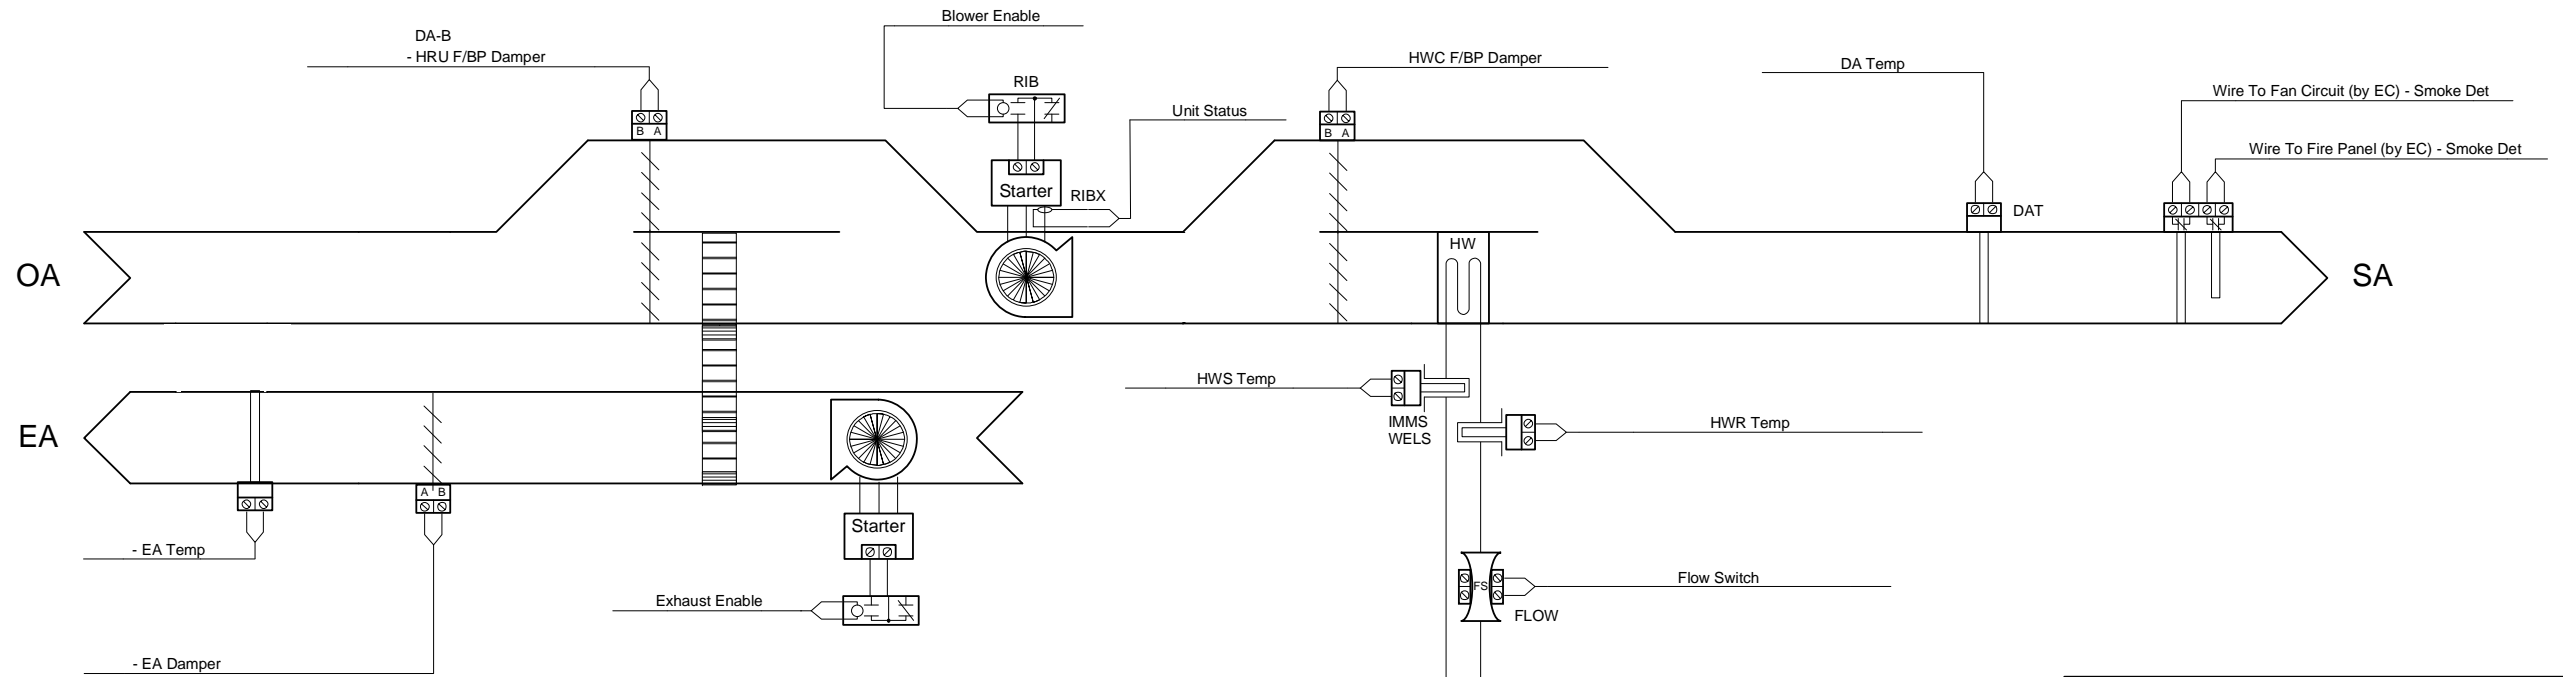

NORWICH

DCMO BOCES - Phase 1&2 AS BUILT
 Norwich / Masonville, New York

Air Temp Heating & Air Conditioning, Inc.


AHU 2C

REV: 1	As-Built	11/19/2007	JOB NO: P7425-7290
CHECK BY: RSL			DSCODE:



AIR TEMP HEATING & AIR CONDITIONING, INC.
 A LINC SERVICE © CONTRACTOR

13 of 69

AHU - 7, 8, 9

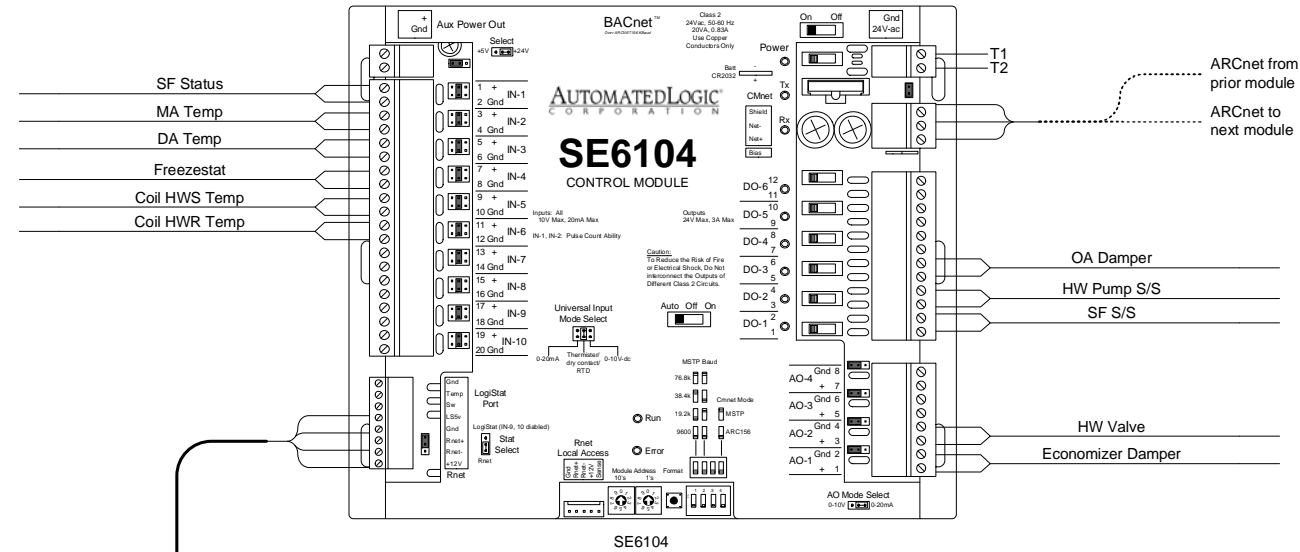

AHU 7 Network 3 Address 7 Autobody
 AHU 8 Network 3 Address 8 Auto Tech
 AHU 9 Network 3 Address 9 Auto Tech

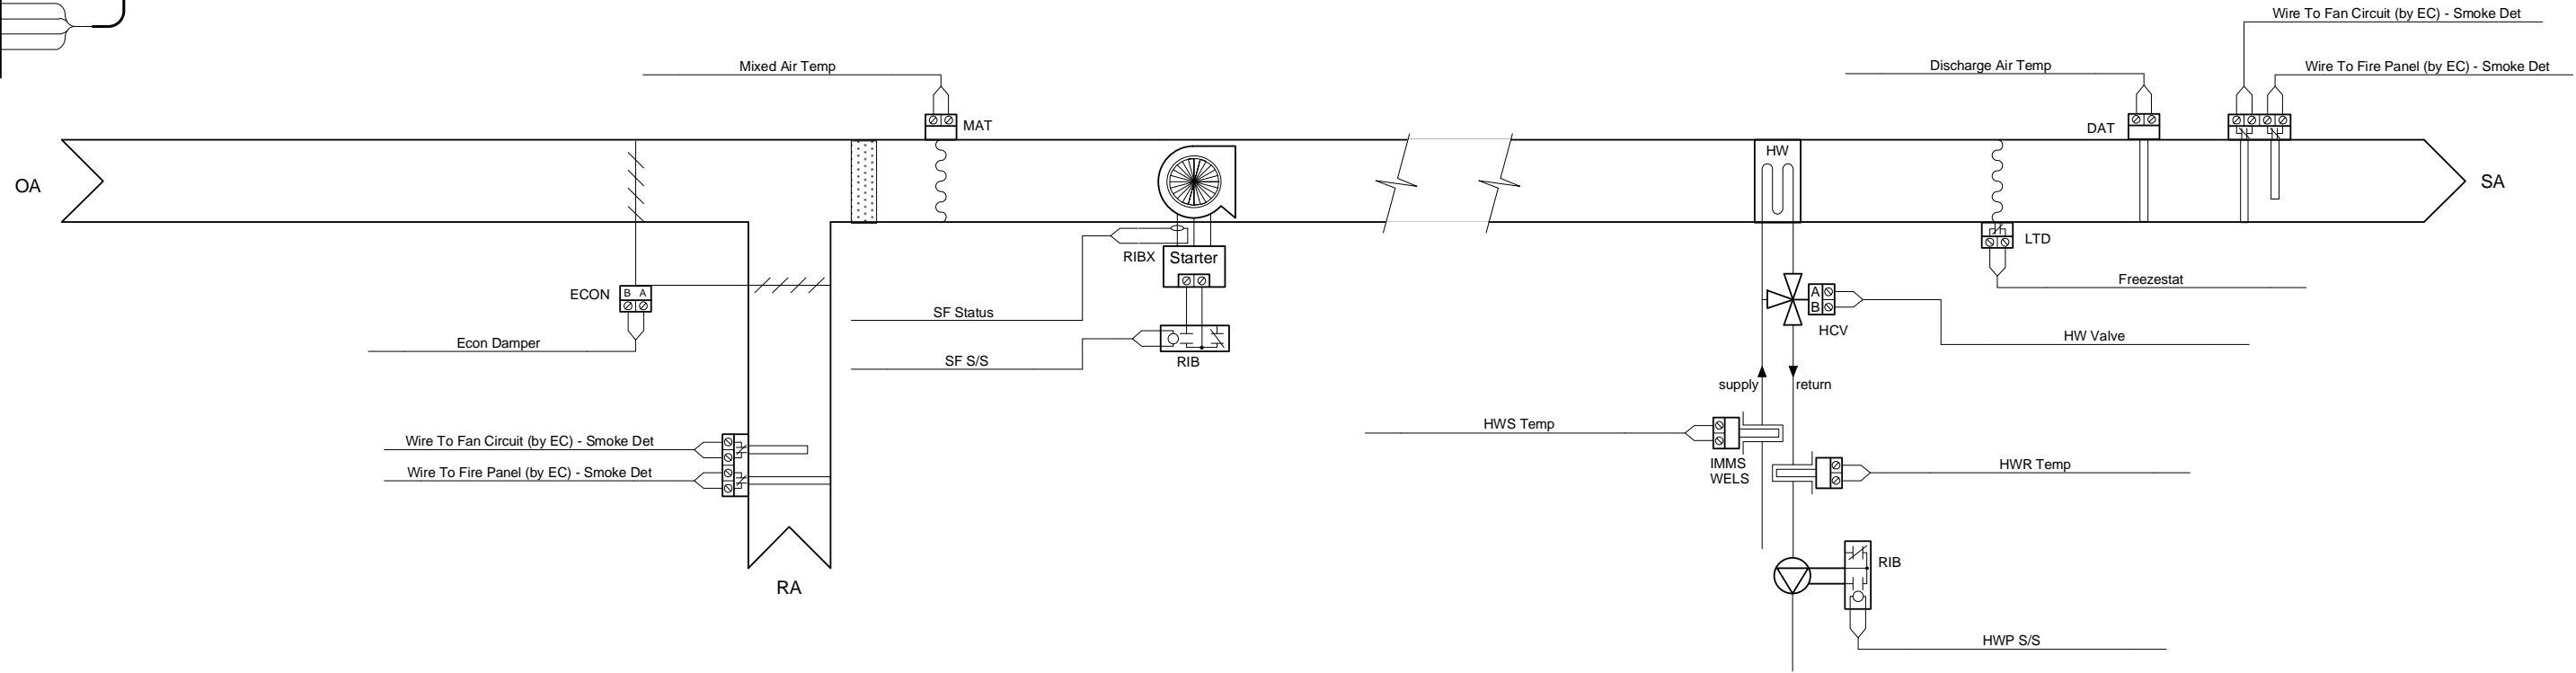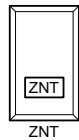

Bill of Materials

DID	DESCRIPTION	MANUFACTURER	PART NUMBER	QTY
DAT	DISCHARGE AIR TEMP SENSOR	BAPI	BA/10K-2-D-12	3 ea
ECON	DAMPER ACTUATOR	BELIMO	AF24-SR US	7 ea
HCV	HEATING CONTROL VALVE	BELIMO	SEE VALVE SCHEDULE	7 ea
IMMS	IMMERSSION TEMP SENSOR	BAPI	BA/10K-2-I-2	14 ea
LTD	LOW AIR TEMP SENSOR	SIEMENS	134-1510	3 ea
MAT	MIXED AIR TEMP SENSOR	BAPI	BA/10K-2-A-12	3 ea
RIB	RELAY	FUNCTIONAL DEVICES	RIBU1C	13 ea
RIBX	CURRENT SWITCH	FUNCTIONAL DEVICES	RIBXKF	6 ea
SE6104	CONTROL MODULE	AUTOMATED LOGIC	SE6104	3 ea
WELS	IMMERSSION TEMP SENSOR WELL	BAPI	BA/2	14 ea
ZNT	ZONE TEMPERATURE SENSOR	AUTOMATED LOGIC	RS PLUS	3 ea

NORWICH

DCMO BOCES - Phase 1&2 AS BUILT

Norwich / Masonville, New York

Air Temp Heating & Air Conditioning, Inc.

AHU - 7, 8, 9

REV: 1 As-Built 11/19/2007 JOB NO: P7425-7290


CHECK BY: RSL

DSCODE:


14 of 69



AHU 10, 11

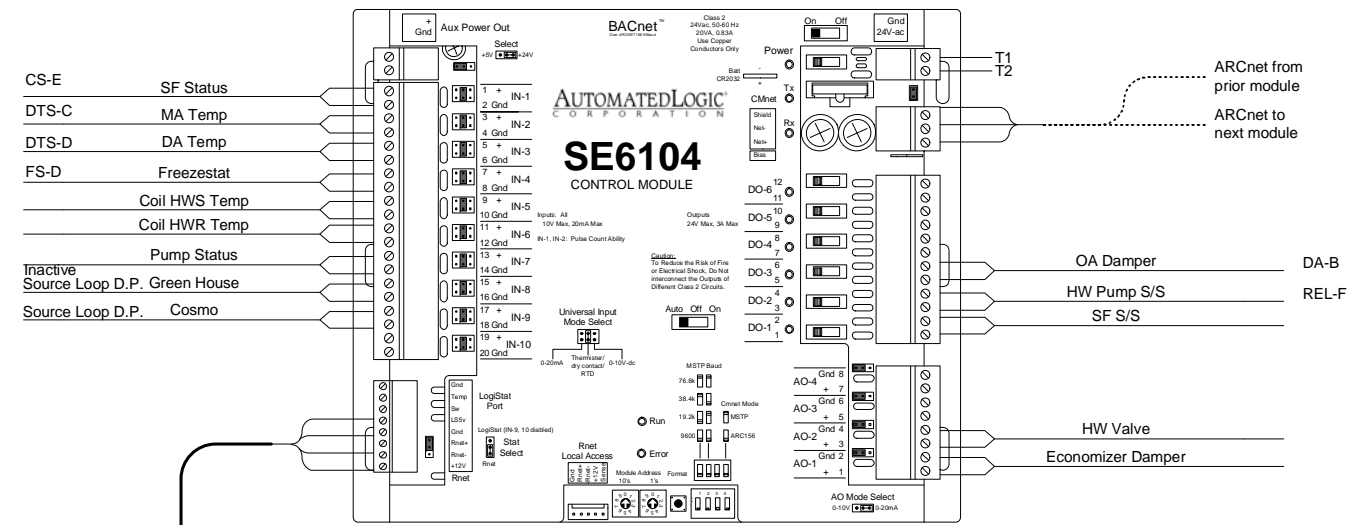

AHU 10 Network 3 Address 10 Equipment Technology
 AHU 11 Network 3 Address 11 Equipment Technology

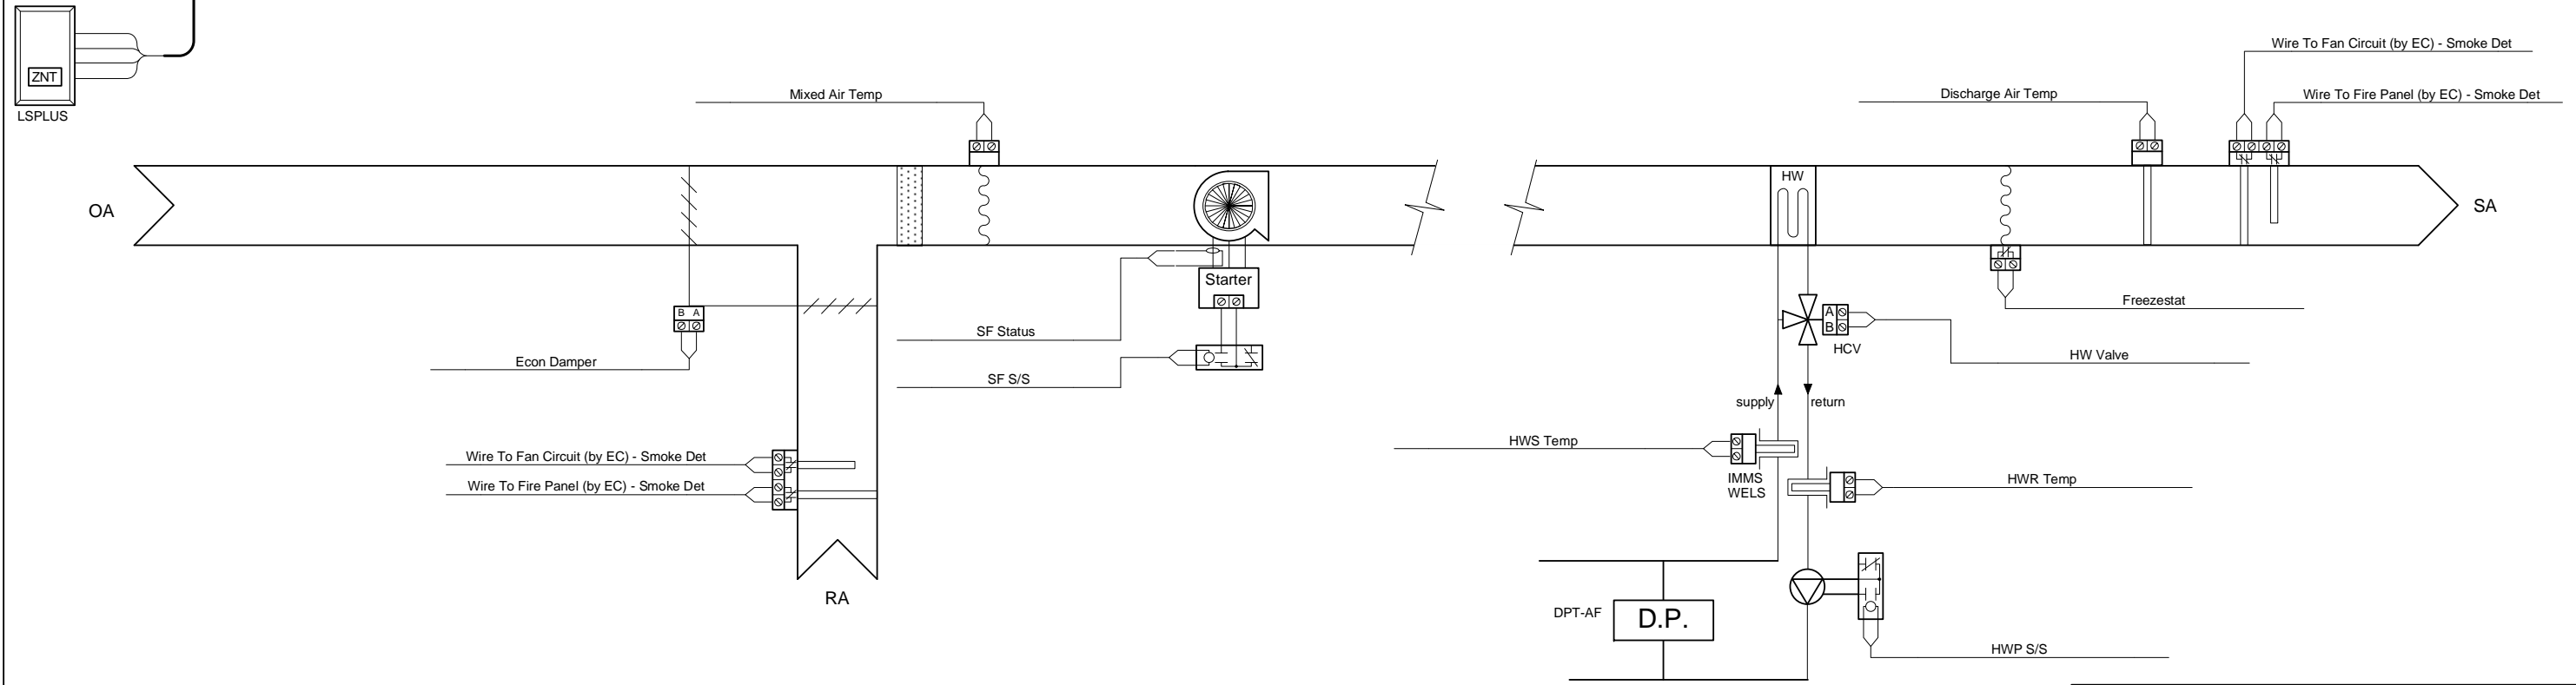

NORWICH

Bill of Materials

DID	DESCRIPTION	MANUFACTURER	PART NUMBER	QTY
CS-E	CURRENT SWITCH .5-200 AMP SOLID CORE GO/NO GO	VERUS IND.	H-800	2 ea
DA-B	SR PROPORTIONAL 133 IN-LB 2-10VDC	BELIMO	AF24-SR ALC	1 ea
DPT-AF	DIFF PRESS TRANSDUCER -.15/+ .15 IN.	MODUS	T030-003B	2 ea
DTS-C	DUCT 10K THERMISTOR AVERAGING 24 FT.	BAPI	ALC/10K-2-A-24	2 ea
DTS-D	DUCT 10K THERMISTOR PROBE 8 IN.	BAPI	ALC/10K-2-D-8	2 ea
FS-D	TEMP LOW LIMIT MAN. RESET DPDT	LANDIS STEAFA	1341504	2 ea
HCV	HEATING CONTROL VALVE	BELIMO	SEE VALVE SCHEDULE	7 ea
IMMS	IMMERSION TEMP SENSOR	BAPI	BA/10K-2-I-2	14 ea
LSPLUS	LOGISTAT 10K ROOM SENSOR W/ SETP ADJ. TLO, COMM	BAPI	LSPLUS	2 ea
REL-F	RIB PILOT RELAY SPDT 10AMP	KELE & ASSOC.	RIBU1C	2 ea
WELS	IMMERSION TEMP SENSOR WELL	BAPI	BA/2	14 ea

DCMO BOCES - Phase 1&2 AS BUILT
 Norwich / Masonville, New York

Air Temp Heating & Air Conditioning, Inc.


AHU 10, 11

REV: 1	As-Built	11/19/2007	JOB NO: P7425-7290
CHECK BY: RSL			DSCODE:

AIR TEMP HEATING & AIR CONDITIONING, INC.
 A LINC SERVICE © CONTRACTOR



15 of 69

MUA Paint Booth

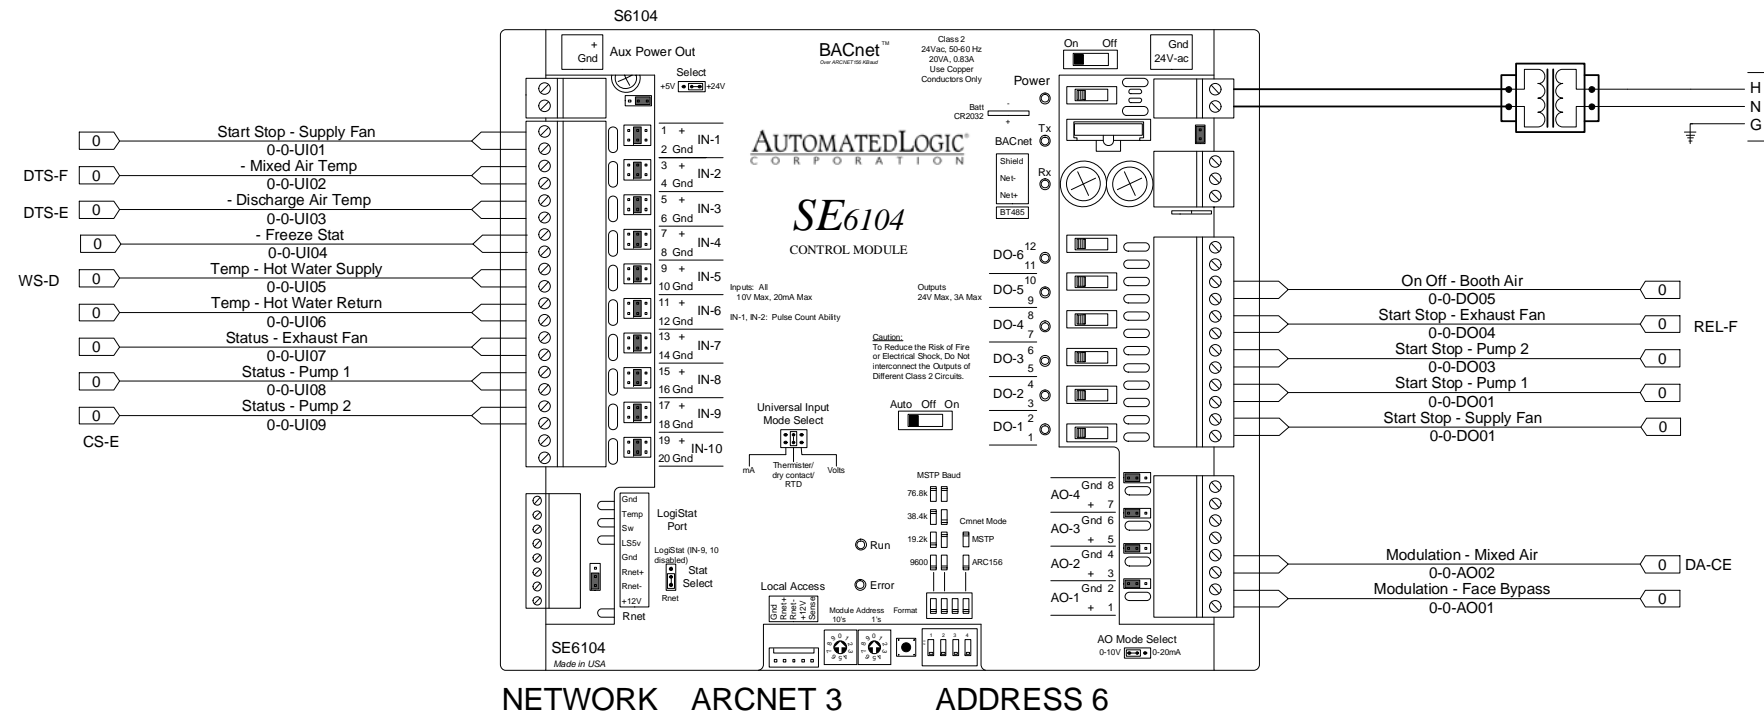

Bill of Materials				
DID	DESCRIPTION	MANUFACTURER	PART NUMBER	QTY
CS-E	CURRENT SWITCH .5-200 AMP SOLID CORE GO/NO GO	VERUS IND.	H-800	4 ea
DA-CE	SR 0-10VDC 35 IN-LB 24 V	BELIMO	LF24-SR ALC	2 ea
DTS-E	DUCT 10K THERMISTOR PROBE 18 IN.	BAPI	ALC/10K-2-D-18	1 ea
DTS-F	DUCT 10K THERMISTOR AVERAGING 8 FT.	BAPI	ALC/10K-2-A-8	1 ea
REL-F	RIB PILOT RELAY SPDT 10AMP	KELE & ASSOC.	RIBU1C	4 ea
S6104	S6104	AUTOMATED LOGIC	S6104	1 ea
WS-D	10K IMMERSION THERMISTOR	BAPI	ALC/10K-2-I-22 1/2IN.	2 ea


Exhaust Fan Interlock

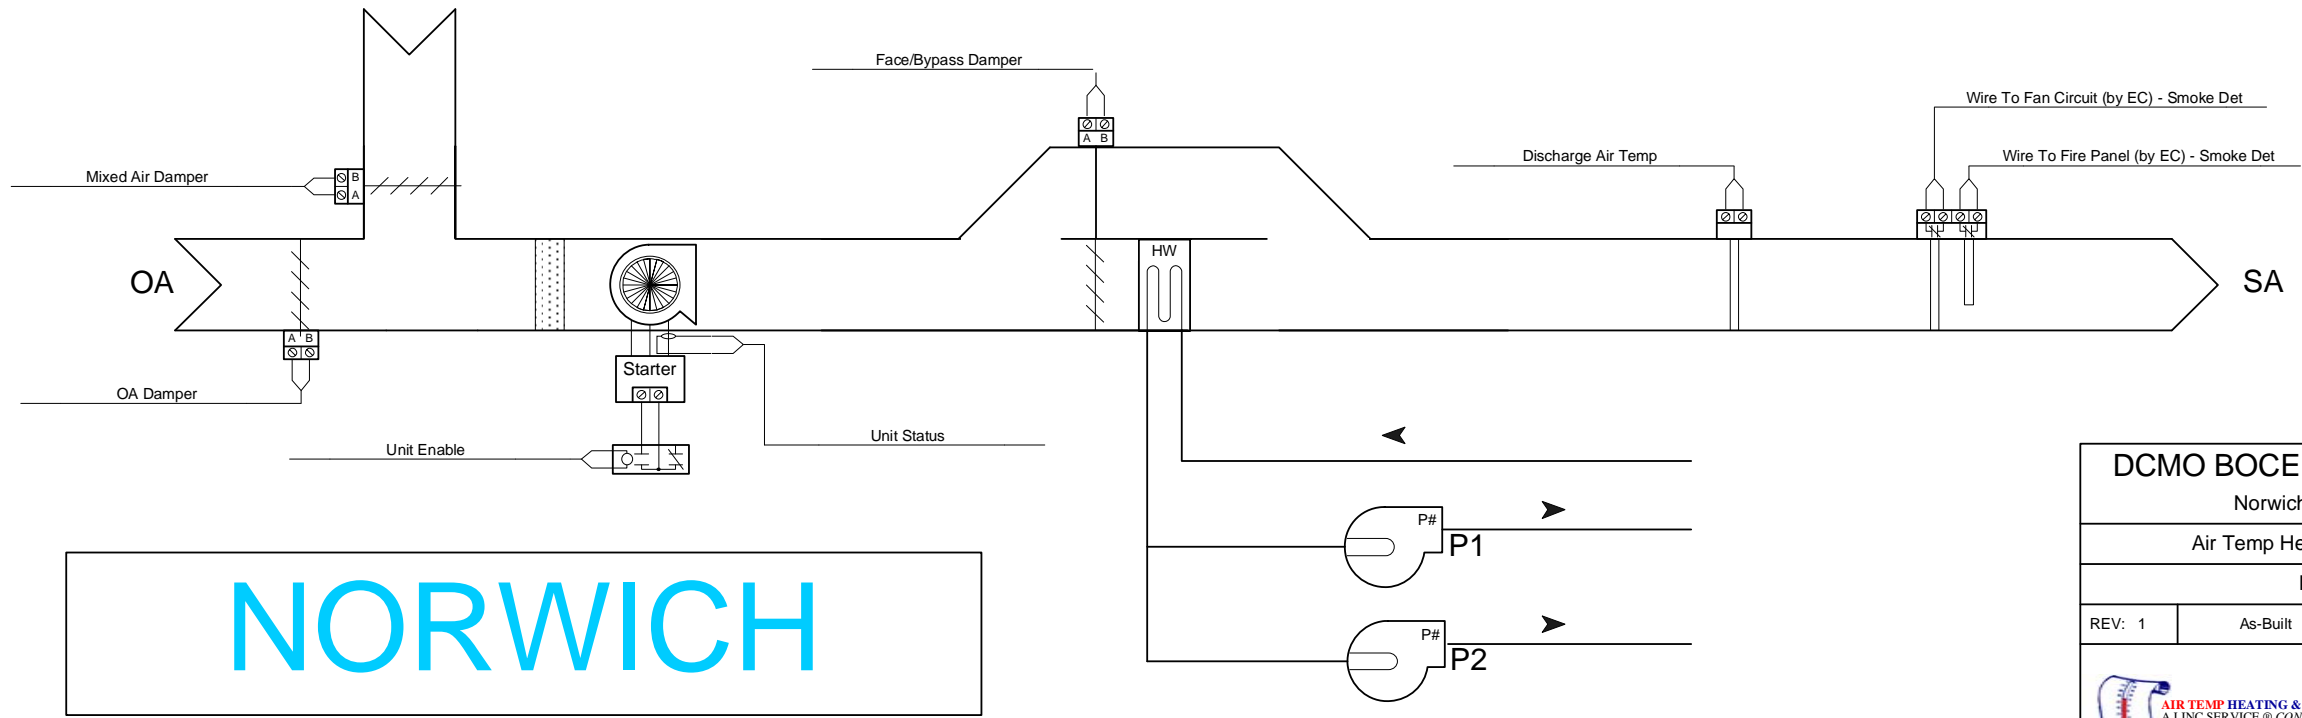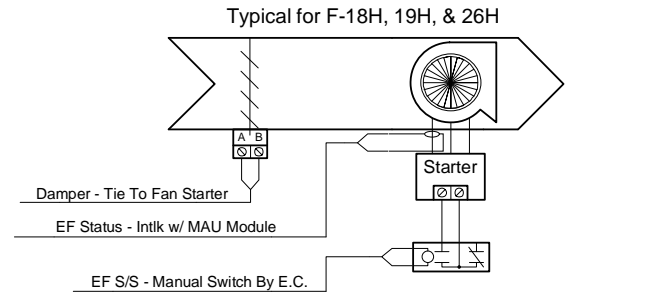


NORWICH

DCMO BOCES - Phase 1&2 AS BUILT			
Norwich / Masonville, New York			
Air Temp Heating & Air Conditioning, Inc.			
MUA Paint Booth			
REV: 1	As-Built	11/19/2007	JOB NO: P7425-7290
CHECK BY: RSL			DSCODE:
			16 of 69

MUA Prep Booth

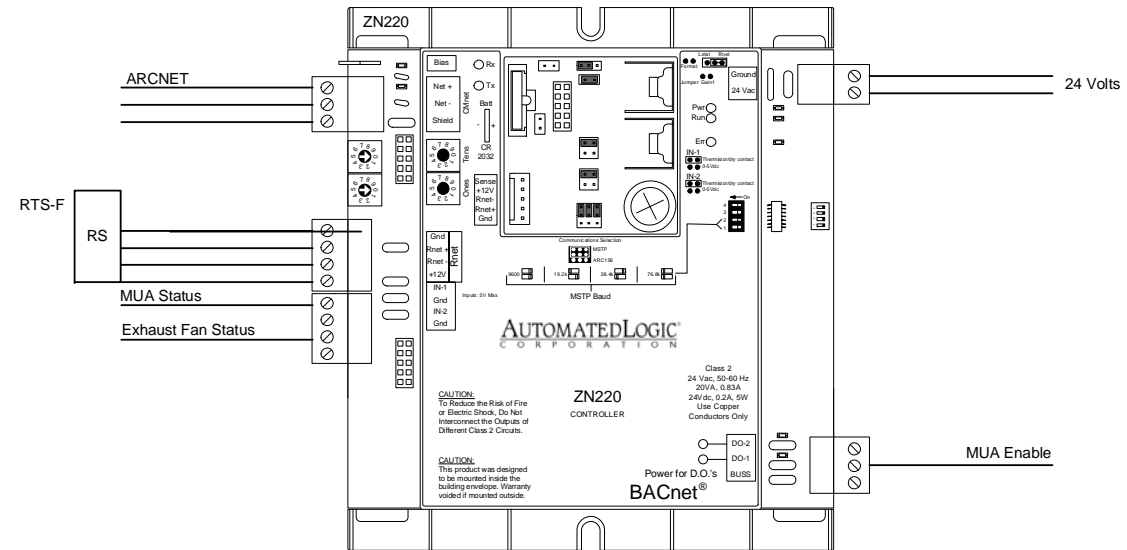

NETWORK 3
Address 20

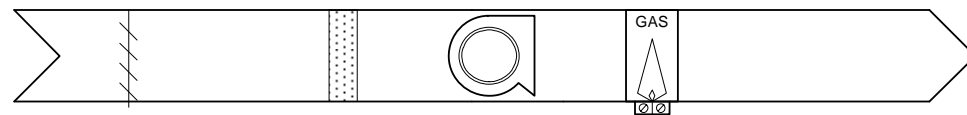


Enabled By Automated Logic
Unit Runs on Factory Controls

NORWICH

Bill of Materials

DID	DESCRIPTION	MANUFACTURER	PART NUMBER	QTY
CS-E	CURRENT SWITCH .5-200 AMP SOLID CORE GO/NO GO	VERUS IND.	H-800	1 ea
RTS-F	10K ROOM THERMISTOR RS	BAPI	ALC/10K-2-RS	1 ea
ZN220	ZN220	AUTOMATED LOGIC	ZN220	1 ea

Fan Is Started By Manual Switch

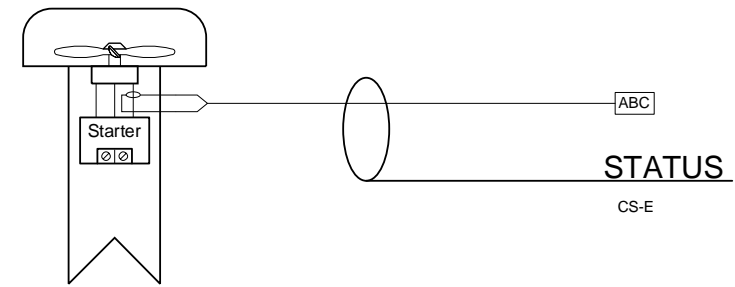

DCMO BOCES - Phase 1&2 AS BUILT

Norwich / Masonville, New York

Air Temp Heating & Air Conditioning, Inc.

MUA Prep Booth


REV: 1	As-Built	11/19/2007	JOB NO: P7425-7290
--------	----------	------------	--------------------

CHECK BY: RSL






DSCODE:

MUA Autobody

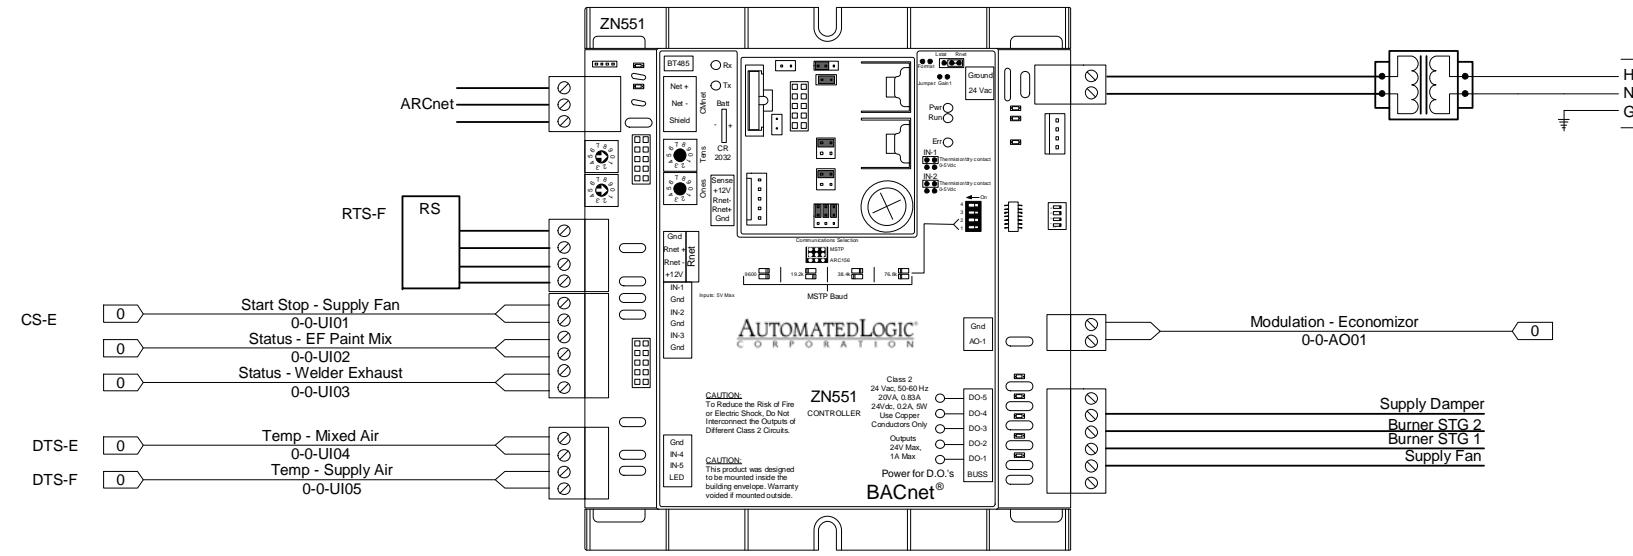

NETWORK ARCNET 3 ADDRESS 21

Bill of Materials				
DID	DESCRIPTION	MANUFACTURER	PART NUMBER	QTY
CS-E	CURRENT SWITCH .5-200 AMP SOLID CORE GO/NO GO	VERUS IND.	H-800	3 ea
DTS-E	DUCT 10K THERMISTOR PROBE 18 IN.	BAPI	ALC/10K-2-D-18	1 ea
DTS-F	DUCT 10K THERMISTOR AVERAGING 8 FT.	BAPI	ALC/10K-2-A-8	1 ea
RTS-F	10K ROOM THERMISTOR RS	BAPI	ALC/10K-2-RS	1 ea
ZN551	ZN551	AUTOMATED LOGIC	ZN551	1 ea

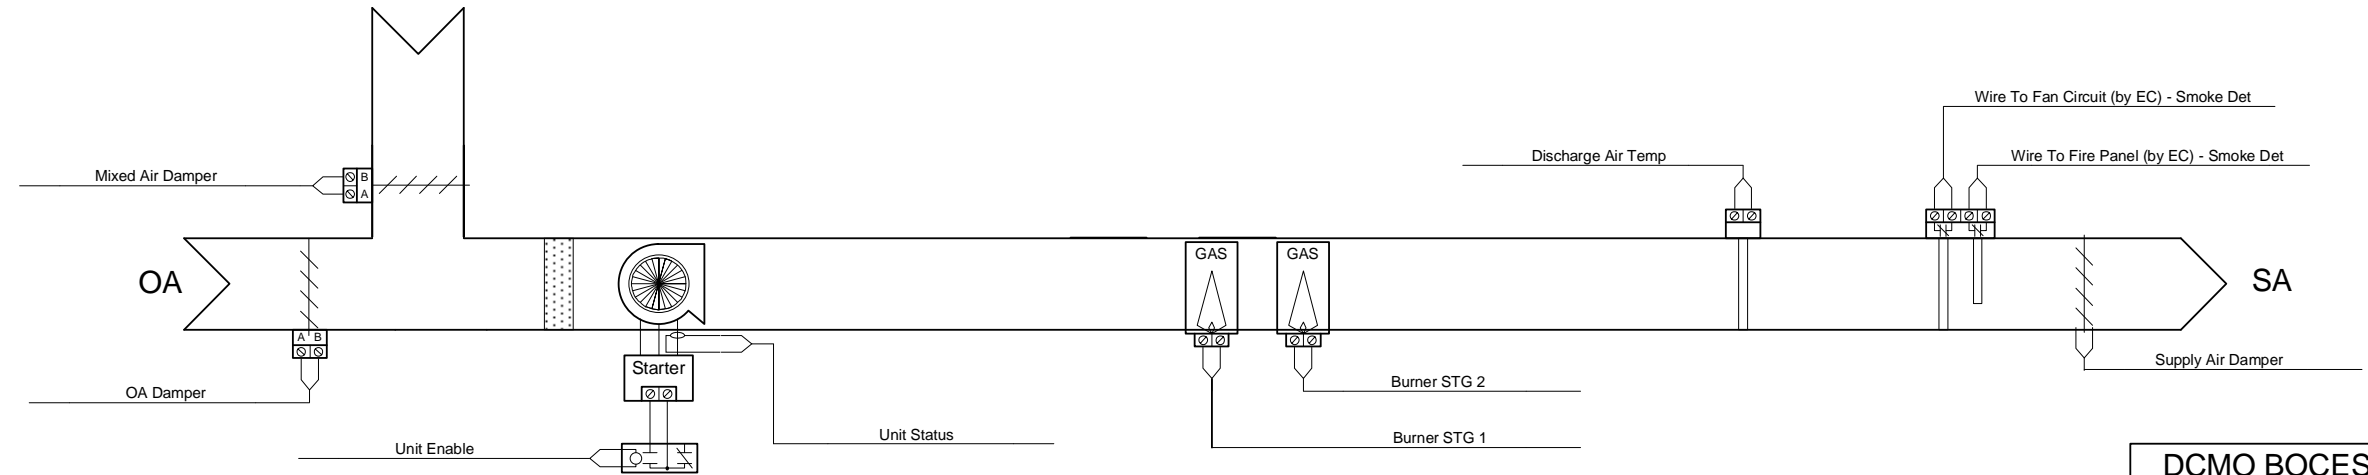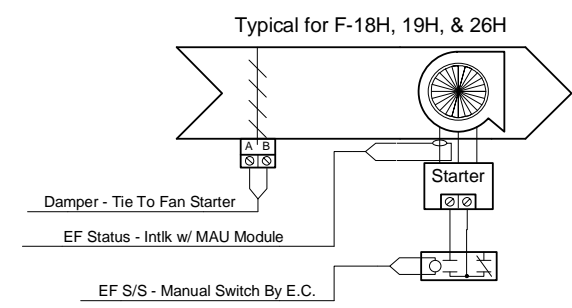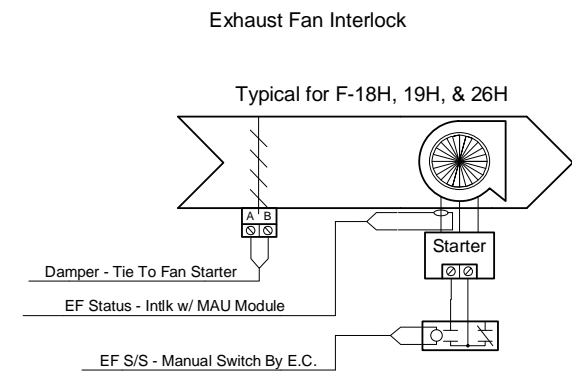

NORWICH

DCMO BOCES - Phase 1&2 AS BUILT
 Norwich / Masonville, New York

Air Temp Heating & Air Conditioning, Inc.


MUA Autobody

REV: 1	As-Built	11/19/2007	JOB NO: P7425-7290
			CHECK BY: RSL
			DSCODE:

AIR TEMP HEATING & AIR CONDITIONING, INC.
 A LINC SERVICE © CONTRACTOR


18 of 69

Radiant Panels

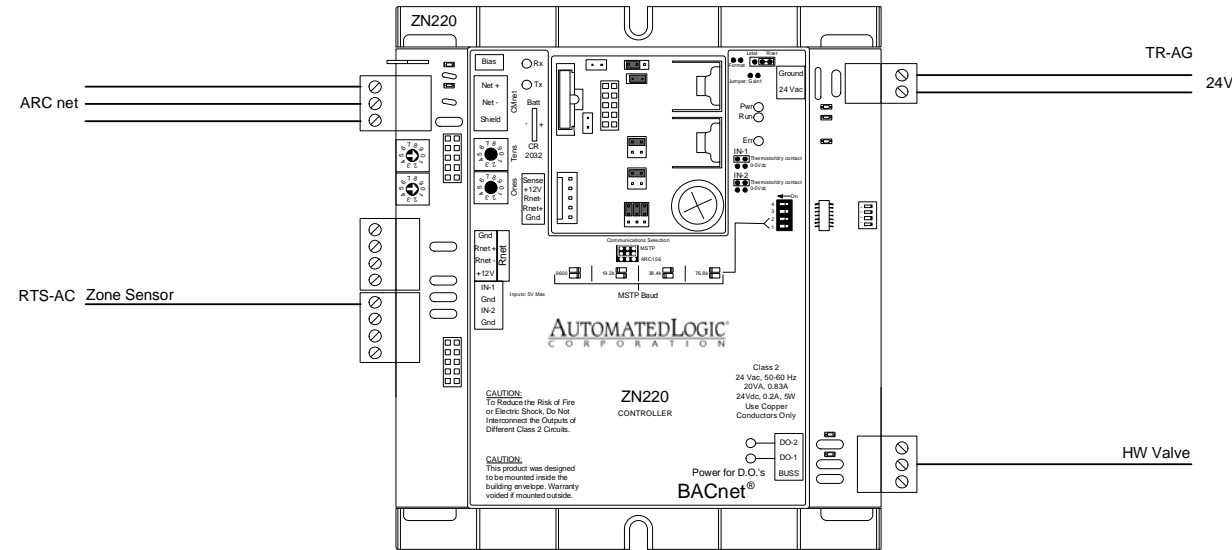


Bill of Materials				
DID	DESCRIPTION	MANUFACTURER	PART NUMBER	QTY
RTS-AC	10K ROOM THERMISTOR SS WALL PLATE	BAPI	BA/10K-2-93-631	9 ea
TR-AG	TRANSFORMER, 120/24VAC 150VA W/CCT BREAKER	CORE COMPONENTS	LE-124	1 ea
ZN220	ZN220	AUTOMATED LOGIC	ZN220	9 ea

- Radiant C105.5
 - Radiant C1-5.1
 - Radiant C1-5.1 Boys Locker
 - Radiant C133.1 Girls Locker
 - Radiant C135 Aerobics
 - Radiant C136 Boys bathroom
 - Radiant C134 Girls bathroom
 - Radiant C110 Hall
 - Radiant Bathroom E Upper East
- Network 3 Address 14
 - Network 3 Address 87
 - Network 1 Address 51
 - Network 1 Address 52
 - Network 1 Address 53
 - Network 1 Address 54
 - Network 1 Address 55
 - Network 1 Address 50
 - Network 2 Address 48

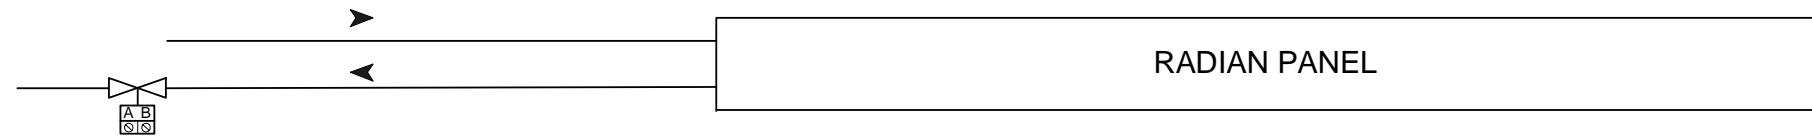


NORWICH

DCMO BOCES - Phase 1&2 AS BUILT			
Norwich / Masonville, New York			
Air Temp Heating & Air Conditioning, Inc.			
Radiant Panels			
REV: 1	As-Built	11/19/2007	JOB NO: P7425-7290
			CHECK BY: RSL
			DSCODE:
19 of 69			

Radiant Panel rev2


Bill of Materials				
DID	DESCRIPTION	MANUFACTURER	PART NUMBER	QTY
RTS-AC	10K ROOM THERMISTOR SS WALL PLATE	BAPI	BA/10K-2-93-631	9 ea
TR-AG	TRANSFORMER, 120/24VAC 150VA W/CCT BREAKER	CORE COMPONENTS	LE-124	1 ea
ZN220	ZN220	AUTOMATED LOGIC	ZN220	9 ea

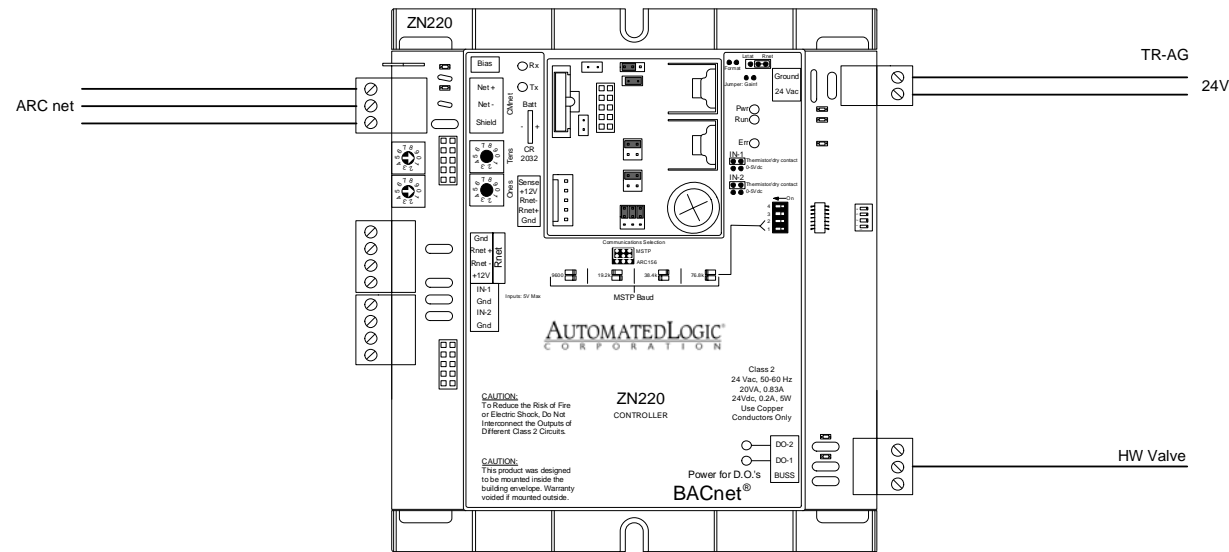

Radiant Bathroom North level 2 E

Network 2 Address 53

Space Temp Sensor is Networked From from Network 2-56 RNET

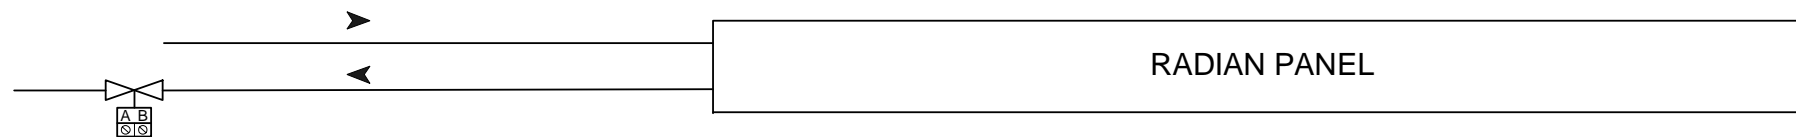


NORWICH

DCMO BOCES - Phase 1&2 AS BUILT			
Norwich / Masonville, New York			
Air Temp Heating & Air Conditioning, Inc.			
Radiant Panel rev2			
REV: 1	As-Built	11/19/2007	JOB NO: P7425-7290
			CHECK BY: RSL
			DSCODE:
			20 of 69


Fin Tube

Bill of Materials				
DID	DESCRIPTION	MANUFACTURER	PART NUMBER	QTY
RTS-AC	10K ROOM THERMISTOR SS WALL PLATE	BAPI	BA/10K-2-93-631	1 ea
TR-AG	TRANSFORMER, 120/24VAC 150VA W/CCT BREAKER	CORE COMPONENTS	LE-124	1 ea
ZN220	ZN220	AUTOMATED LOGIC	ZN220	1 ea

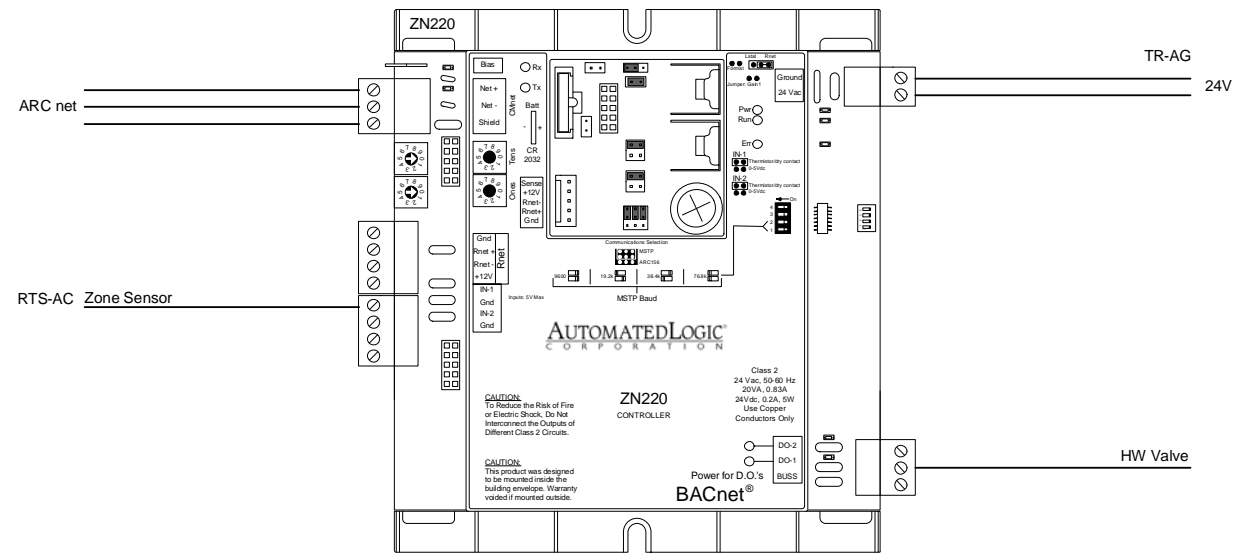


Radiant C160.1 Bathroom

Network 2 Address 55

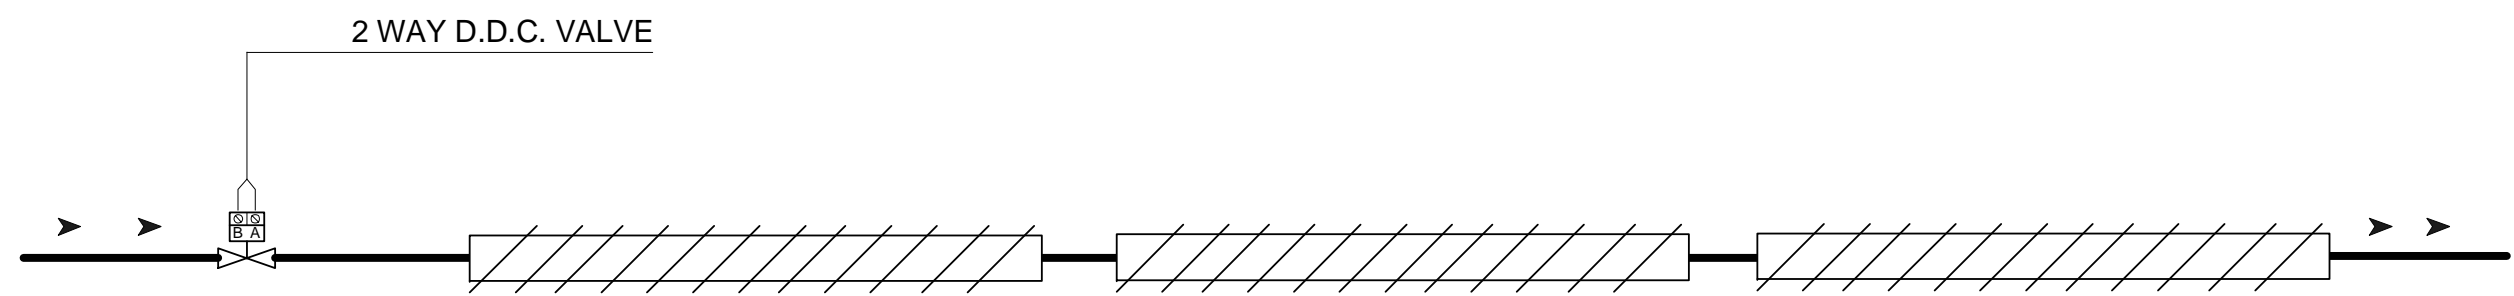


NORWICH

DCMO BOCES - Phase 1&2 AS BUILT			
Norwich / Masonville, New York			
Air Temp Heating & Air Conditioning, Inc.			
Fin Tube			
REV: 1	As-Built	11/19/2007	JOB NO: P7425-7290
 AIR TEMP HEATING & AIR CONDITIONING, INC. A LINC SERVICE © CONTRACTOR			CHECK BY: RSL
			DSCODE:
			21 of 69


Fin Tube Greenhouse

Bill of Materials				
DID	DESCRIPTION	MANUFACTURER	PART NUMBER	QTY
RTS-AC	10K ROOM THERMISTOR SS WALL PLATE	BAPI	BA/10K-2-93-631	1 ea
TR-AG	TRANSFORMER, 120/24VAC 150VA W/CCT BREAKER	CORE COMPONENTS	LE-124	1 ea
ZN551	ZN551	AUTOMATED LOGIC	ZN551	3 ea

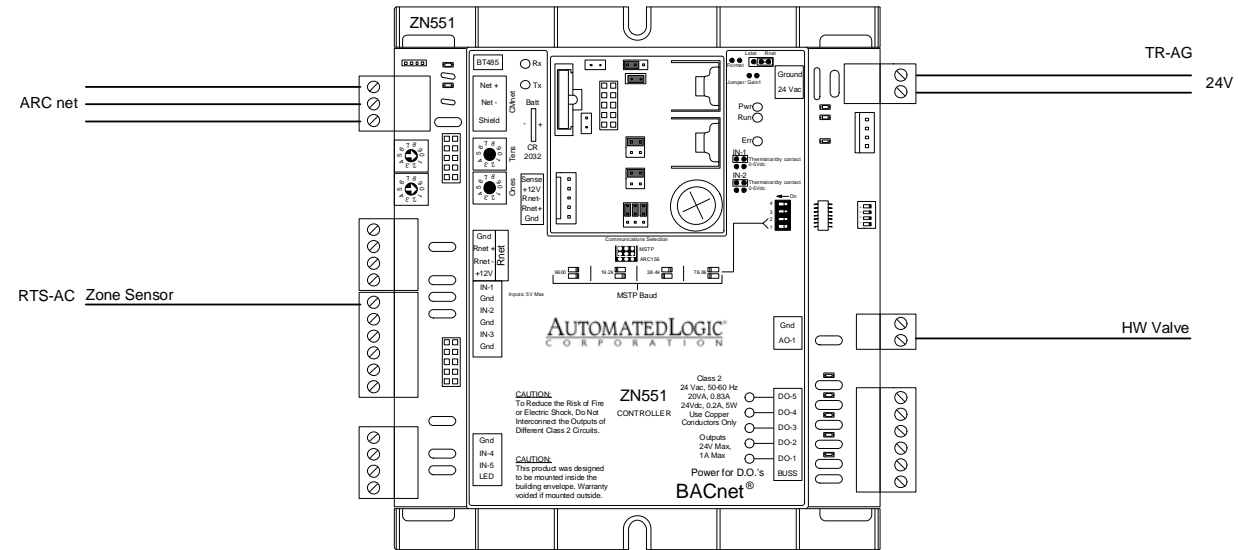

- FINTUBE ROOM NORTH Network 3 Address 24
- FINTUBE ROOM MIDDLE Network 3 Address 25
- FINTUBE ROOM SOUTH Network 3 Address 26



NORWICH

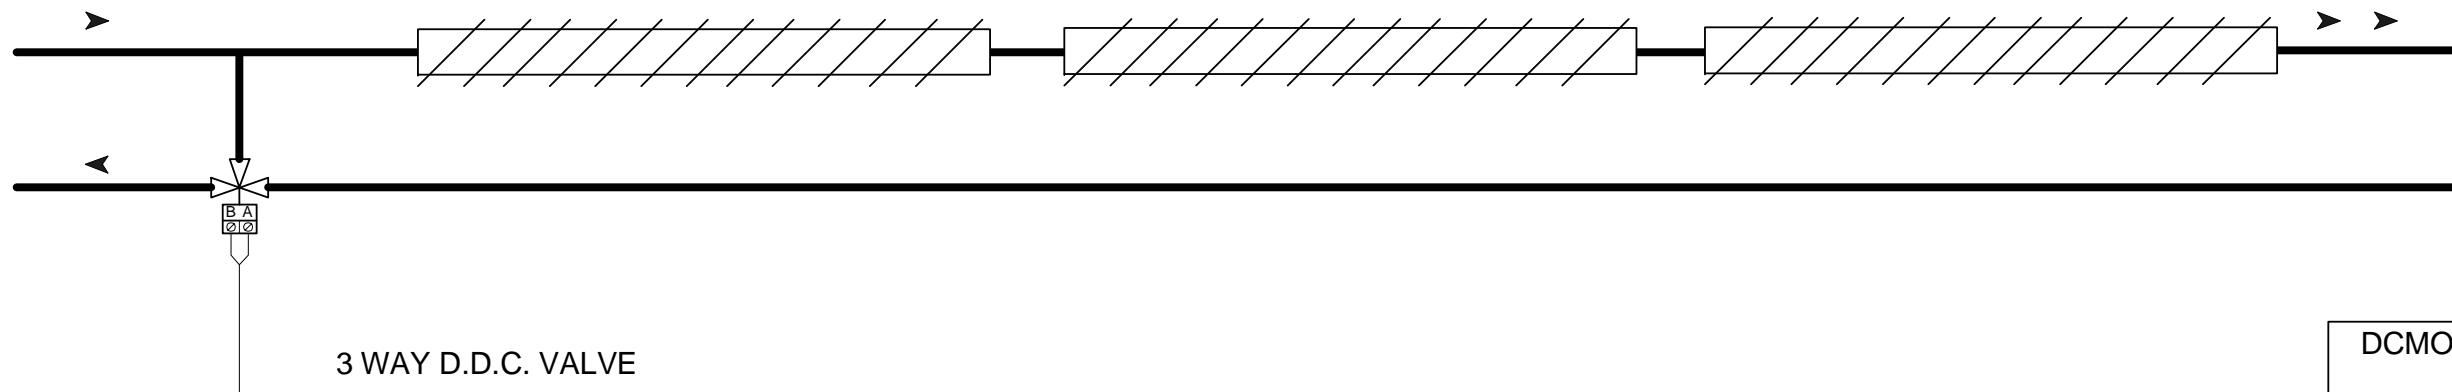


DCMO BOCES - Phase 1&2 AS BUILT			
Norwich / Masonville, New York			
Air Temp Heating & Air Conditioning, Inc.			
Fin Tube Greenhouse			
REV: 1	As-Built	11/19/2007	JOB NO: P7425-7290
			CHECK BY: RSL
			DSCODE:
22 of 69			

Greenhouse Hydronics


Bill of Materials				
DID	DESCRIPTION	MANUFACTURER	PART NUMBER	QTY
CS-E	CURRENT SWITCH .5-200 AMP SOLID CORE GO/NO GO	VERUS IND.	H-800	2 ea
REL-F	RIB PILOT RELAY SPDT 10AMP	KELE & ASSOC.	RIBU1C	2 ea
TR-AF	TRANSFORMER, 120-24VAC W/BREAKER	KELE & ASSOC.	691-K0A	1 ea
W-A	TWP PART SS WELL 4IN.	BAPI	BA/4IN.	2 ea
WS-D	10K IMMERSION THERMISTOR	BAPI	ALC/10K-2-I-22 1/2IN.	2 ea
ZN551	ZN551	AUTOMATED LOGIC	ZN551	1 ea

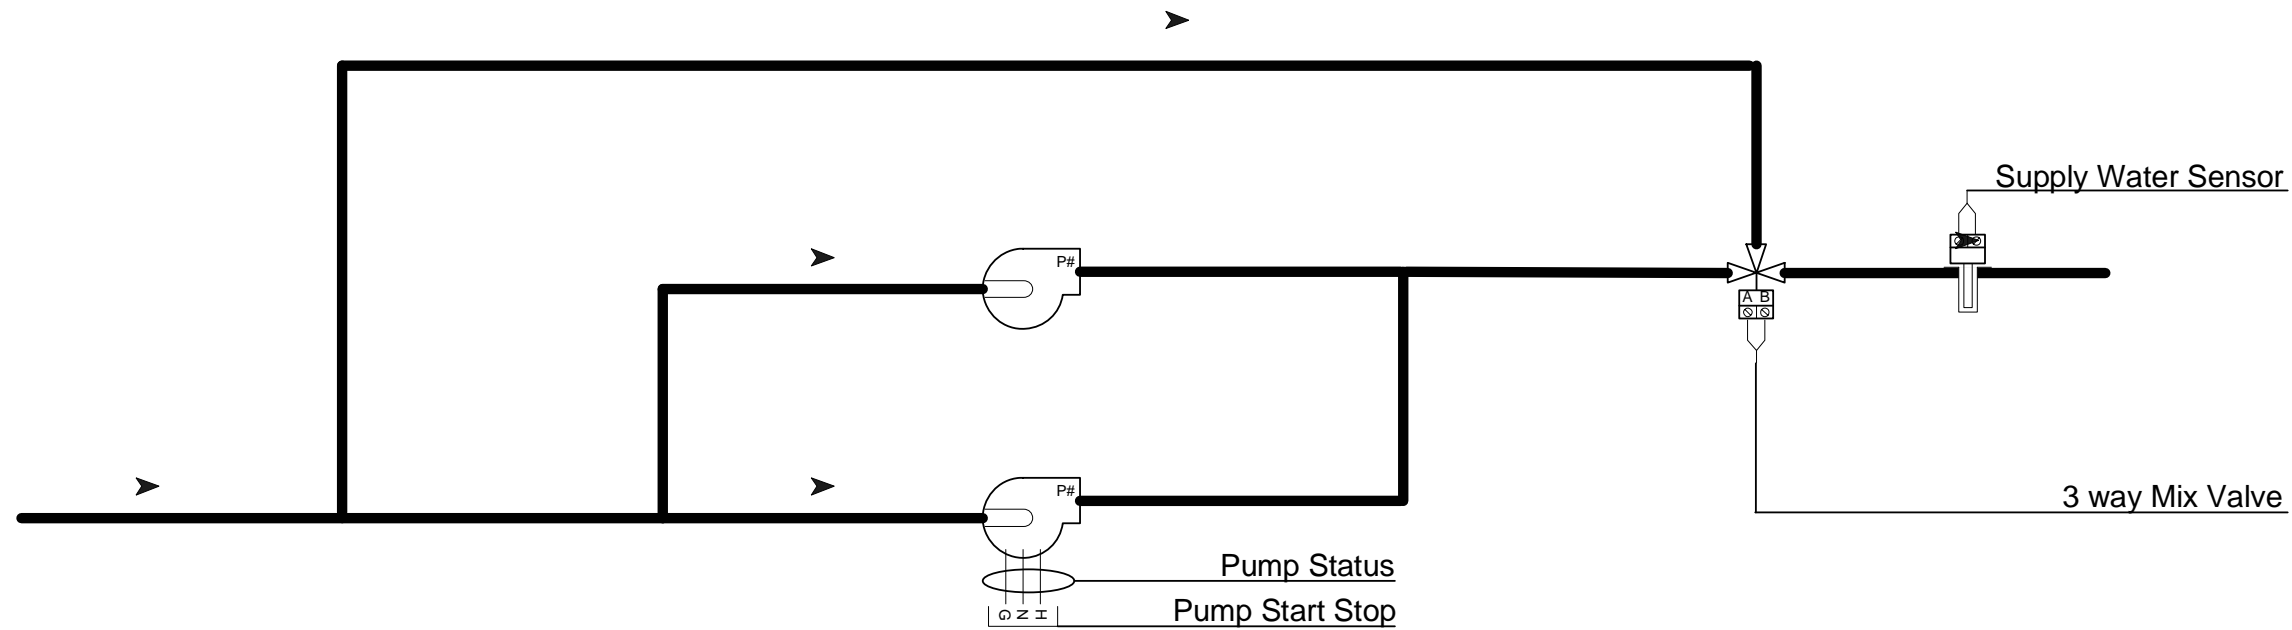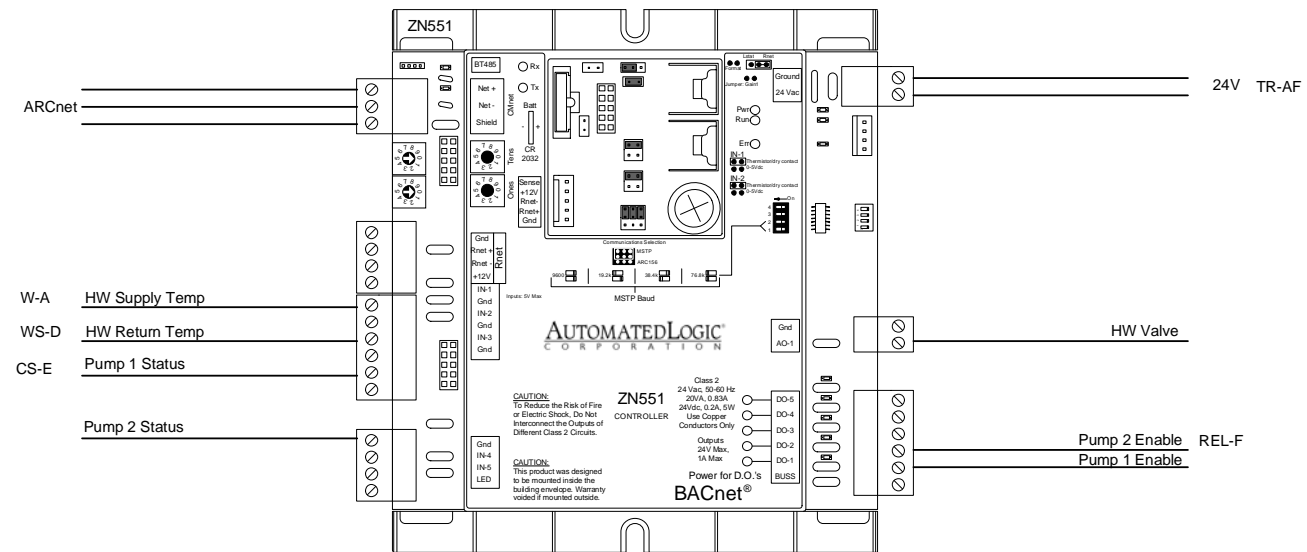

NORWICH


DCMO BOCES - Phase 1&2 AS BUILT			
Norwich / Masonville, New York			
Air Temp Heating & Air Conditioning, Inc.			
Greenhouse Hydronics			
REV: 1	As-Built	11/19/2007	JOB NO: P7425-7290
			CHECK BY: RSL
 AIR TEMP HEATING & AIR CONDITIONING, INC. <small>A LINC SERVICE © CONTRACTOR</small>			DSCODE:
23 of 69			

Heat Pump - HC & CC TYPICAL

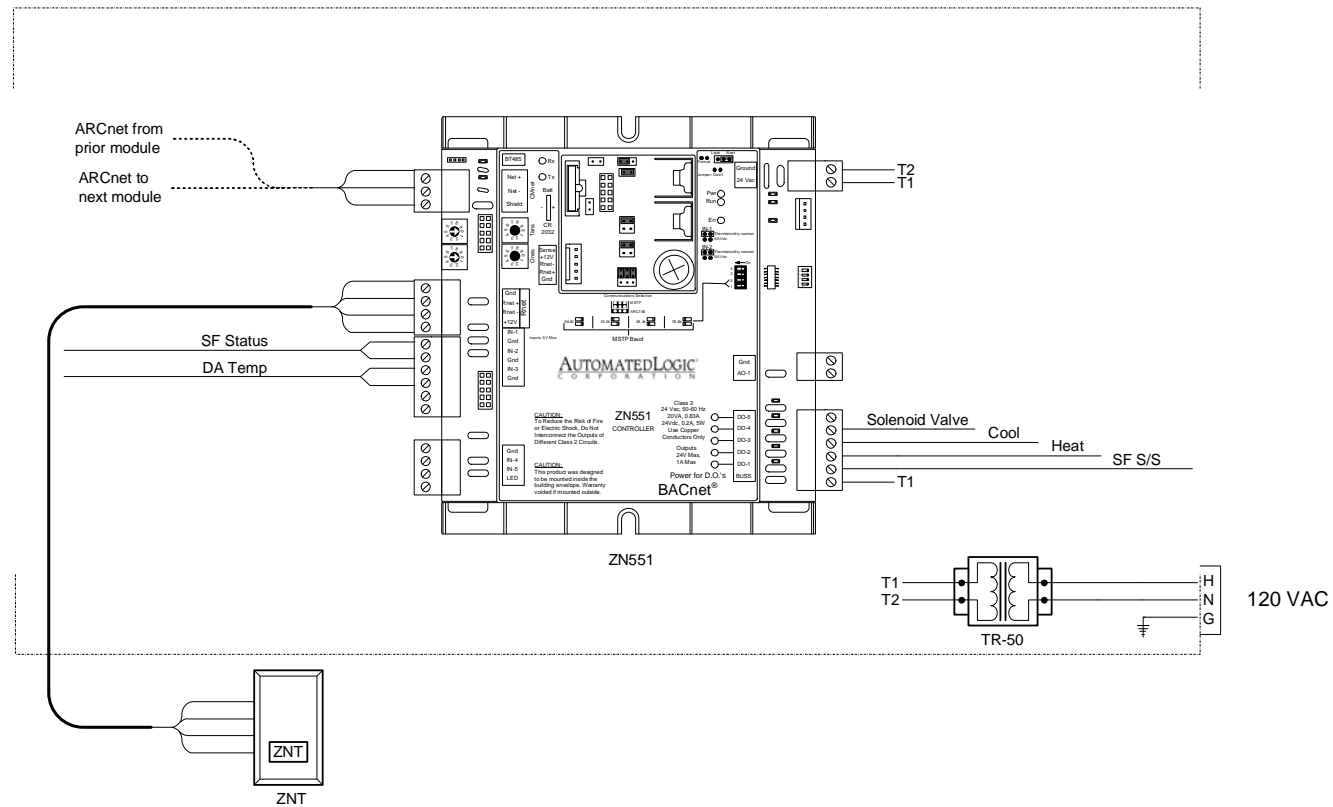

NORWICH
MASONVILLE

Bill of Materials				
DID	DESCRIPTION	MANUFACTURER	PART NUMBER	QTY
DATP	DISCHARGE AIR TEMP SENSOR	BAPI	BA/10K-2-RPP-8	102 ea
RIB	RELAY	FUNCTIONAL DEVICES	RIBU1C	102 ea
RIBX	CURRENT SWITCH	FUNCTIONAL DEVICES	RIBXKF	102 ea
TR-50	TRANSFORMER, 120/24VAC, 50VA	FUNCTIONAL DEVICES	TR50VA002	102 ea
ZN551	CONTROL MODULE	AUTOMATED LOGIC	ZN551	102 ea
ZNT	ZONE TEMPERATURE SENSOR	AUTOMATED LOGIC	RS PLUS	102 ea

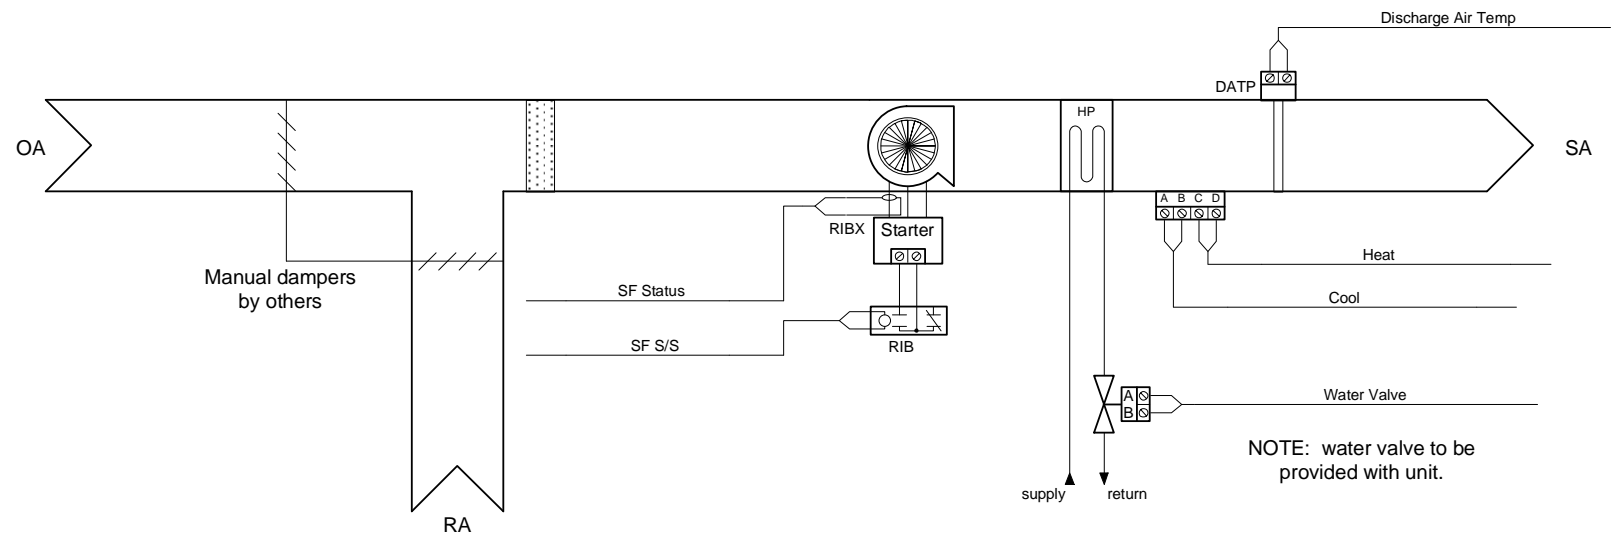

General Notes:

All ARC156 wiring shall be 22AWG single twisted pair, low capacitance (12.5pF/ft), shielded, plenum rated cable. ALC recommends Magnum Cable Corporation Product number A3ARC156.

Each ARC156 segment must be wired in a daisy chain configuration. Branching requires the use of a REP485.


Each ARC156 segment should have one (1) PROT485 installed to provide protection from electrical surges.

Each ARC156 segment end must be terminated with a TERM485 (120 ohm) terminating resistor.

The ARC156 network segment must have at least one (1) DIAG485 installed to supply bias.



Do not strip back shielded cable sheath more than 1" in order to keep twisted pair from separating. Do not ground shield to the panel or chassis ground. The shield should only be connected to the "Optional Shield" connection at a module.

Routing of communications cabling and control module locations shall be field verified.

DCMO BOCES - Phase 1&2 AS BUILT			
Norwich / Masonville, New York			
Air Temp Heating & Air Conditioning, Inc.			
Heat Pump - HC & CC TYPICAL			
REV: 1	As-Built	11/19/2007	JOB NO: P7425-7290
 AIR TEMP HEATING & AIR CONDITIONING, INC. A LINC SERVICE © CONTRACTOR			CHECK BY: RSL
			DSCODE:
			24 of 69

HPNorwich C172 Special Ed

Bill of Materials				
DID	DESCRIPTION	MANUFACTURER	PART NUMBER	QTY
DATP	DISCHARGE AIR TEMP SENSOR	BAPI	BA/10K-2-RPP-8	102 ea
RIB	RELAY	FUNCTIONAL DEVICES	RIBU1C	102 ea
RIBX	CURRENT SWITCH	FUNCTIONAL DEVICES	RIBXKF	102 ea
TR-50	TRANSFORMER, 120/24VAC, 50VA	FUNCTIONAL DEVICES	TR50VA002	102 ea
ZN551	CONTROL MODULE	AUTOMATED LOGIC	ZN551	102 ea
ZNT	ZONE TEMPERATURE SENSOR	AUTOMATED LOGIC	RS PLUS	102 ea

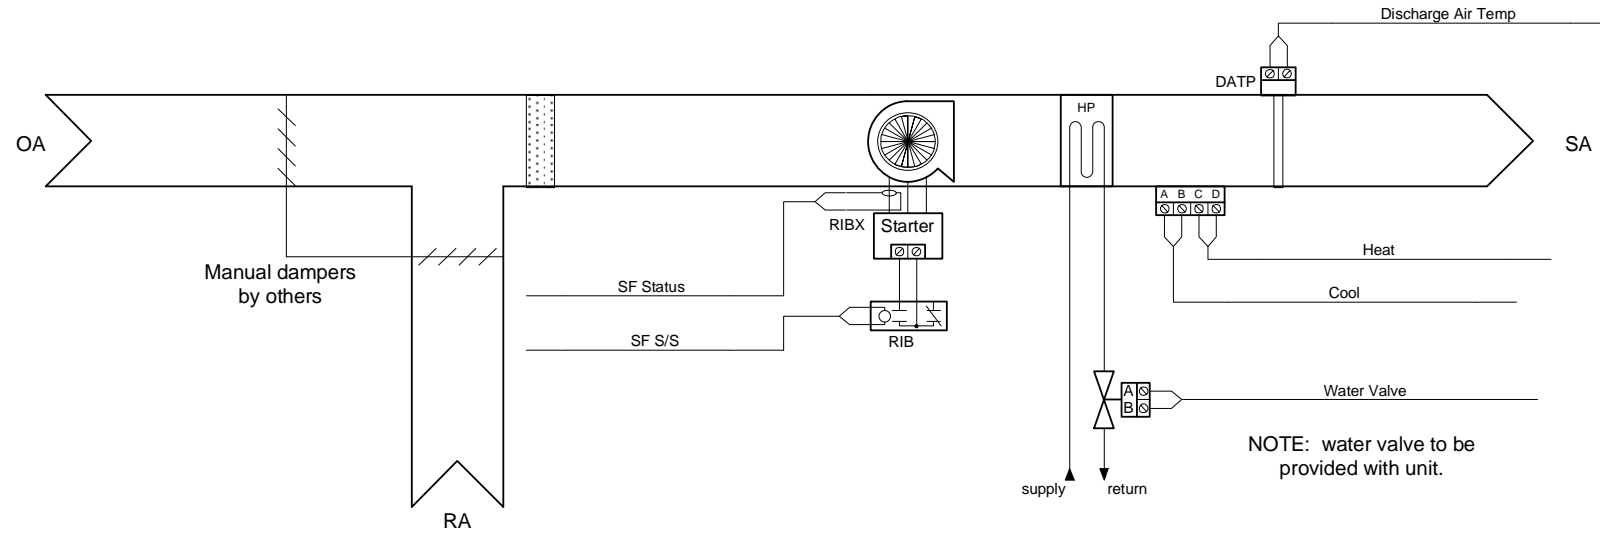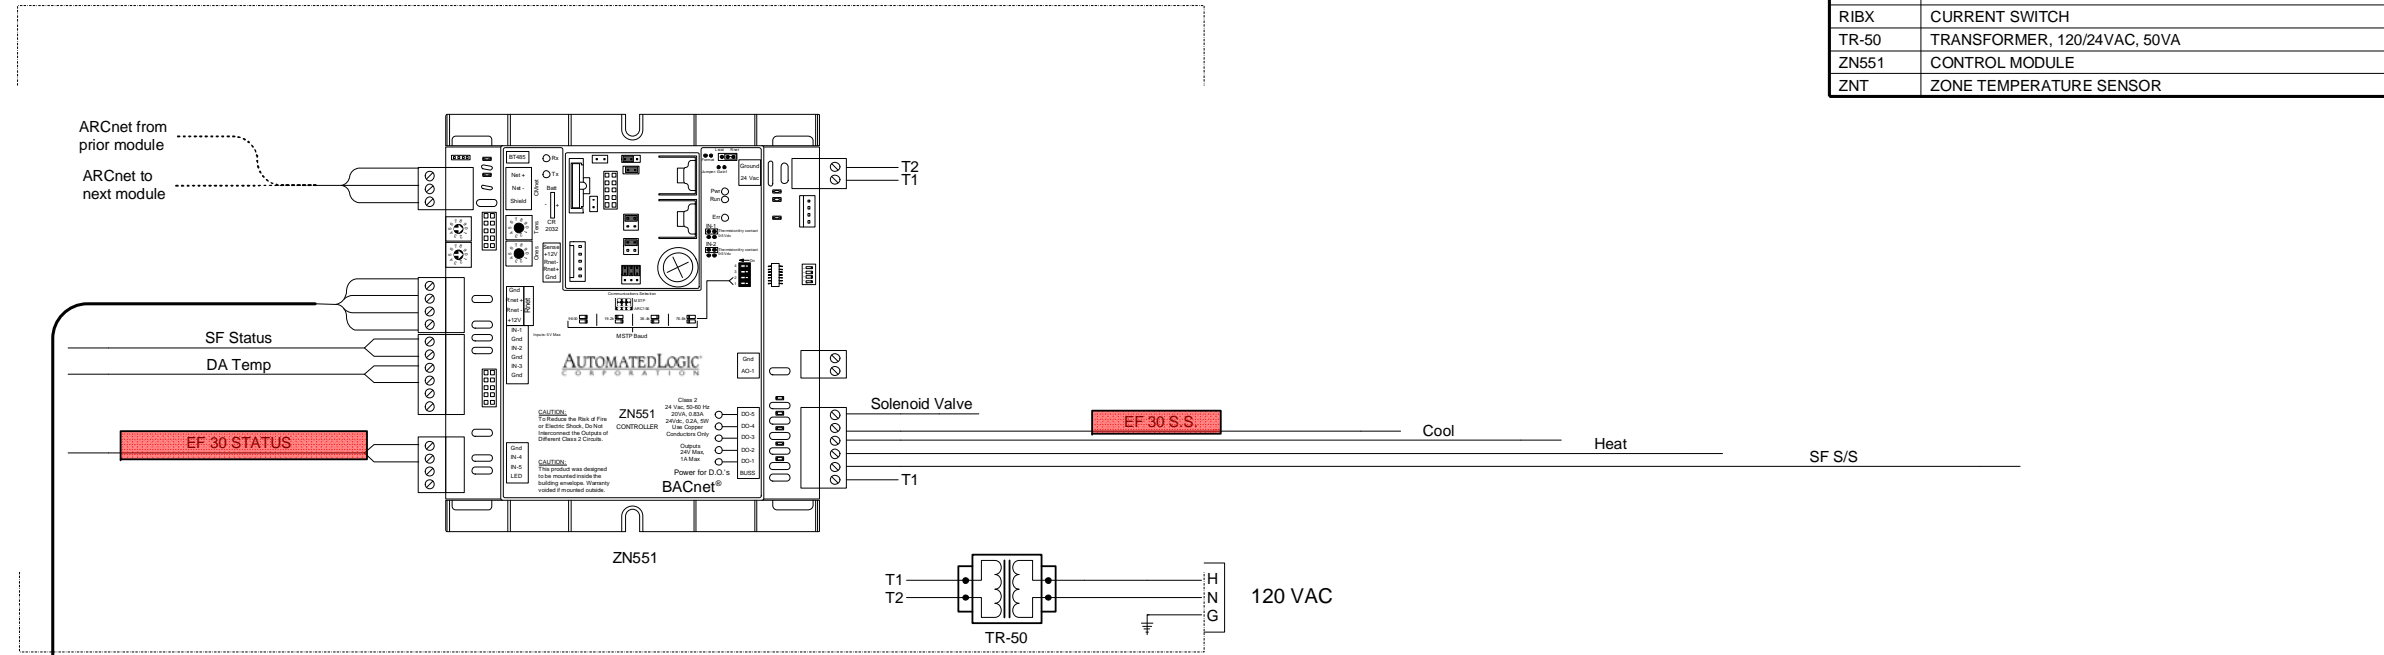

General Notes:
 All ARC156 wiring shall be 22AWG single twisted pair, low capacitance (12.5pF/ft), shielded, plenum rated cable. ALC recommends Magnum Cable Corporation Product number A3ARC156.

Each ARC156 segment must be wired in a daisy chain configuration. Branching requires the use of a REP485.

Each ARC156 segment should have one (1) PROT485 installed to provide protection from electrical surges.


Each ARC156 segment end must be terminated with a TERM485 (120 ohm) terminating resistor.

The ARC156 network segment must have at least one (1) DIAG485 installed to supply bias.

Do not strip back shielded cable sheath more than 1" in order to keep twisted pair from separating. Do not ground shield to the panel or chassis ground. The shield should only be connected to the "Optional Shield" connection at a module.



Routing of communications cabling and control module locations shall be field verified.



DCMO BOCES - Phase 1&2 AS BUILT			
Norwich / Masonville, New York			
Air Temp Heating & Air Conditioning, Inc.			
HPNorwich C172 Special Ed			
REV: 1	As-Built	11/19/2007	JOB NO: P7425-7290
			CHECK BY: RSL
			DSCODE:
25 of 69			

HPNorwich C157 Offices

Bill of Materials				
DID	DESCRIPTION	MANUFACTURER	PART NUMBER	QTY
DATP	DISCHARGE AIR TEMP SENSOR	BAPI	BA/10K-2-RPP-8	102 ea
RIB	RELAY	FUNCTIONAL DEVICES	RIBU1C	102 ea
RIBX	CURRENT SWITCH	FUNCTIONAL DEVICES	RIBXKF	102 ea
TR-50	TRANSFORMER, 120/24VAC, 50VA	FUNCTIONAL DEVICES	TR50VA002	102 ea
ZN551	CONTROL MODULE	AUTOMATED LOGIC	ZN551	102 ea
ZNT	ZONE TEMPERATURE SENSOR	AUTOMATED LOGIC	RS PLUS	102 ea

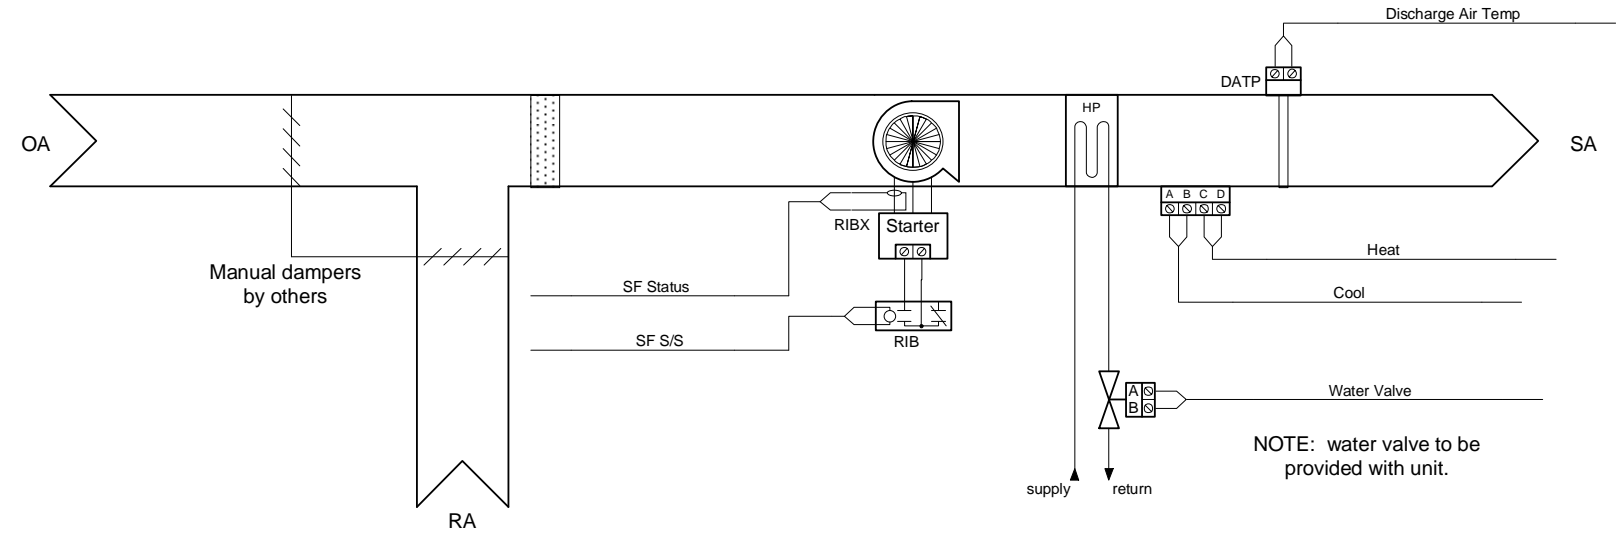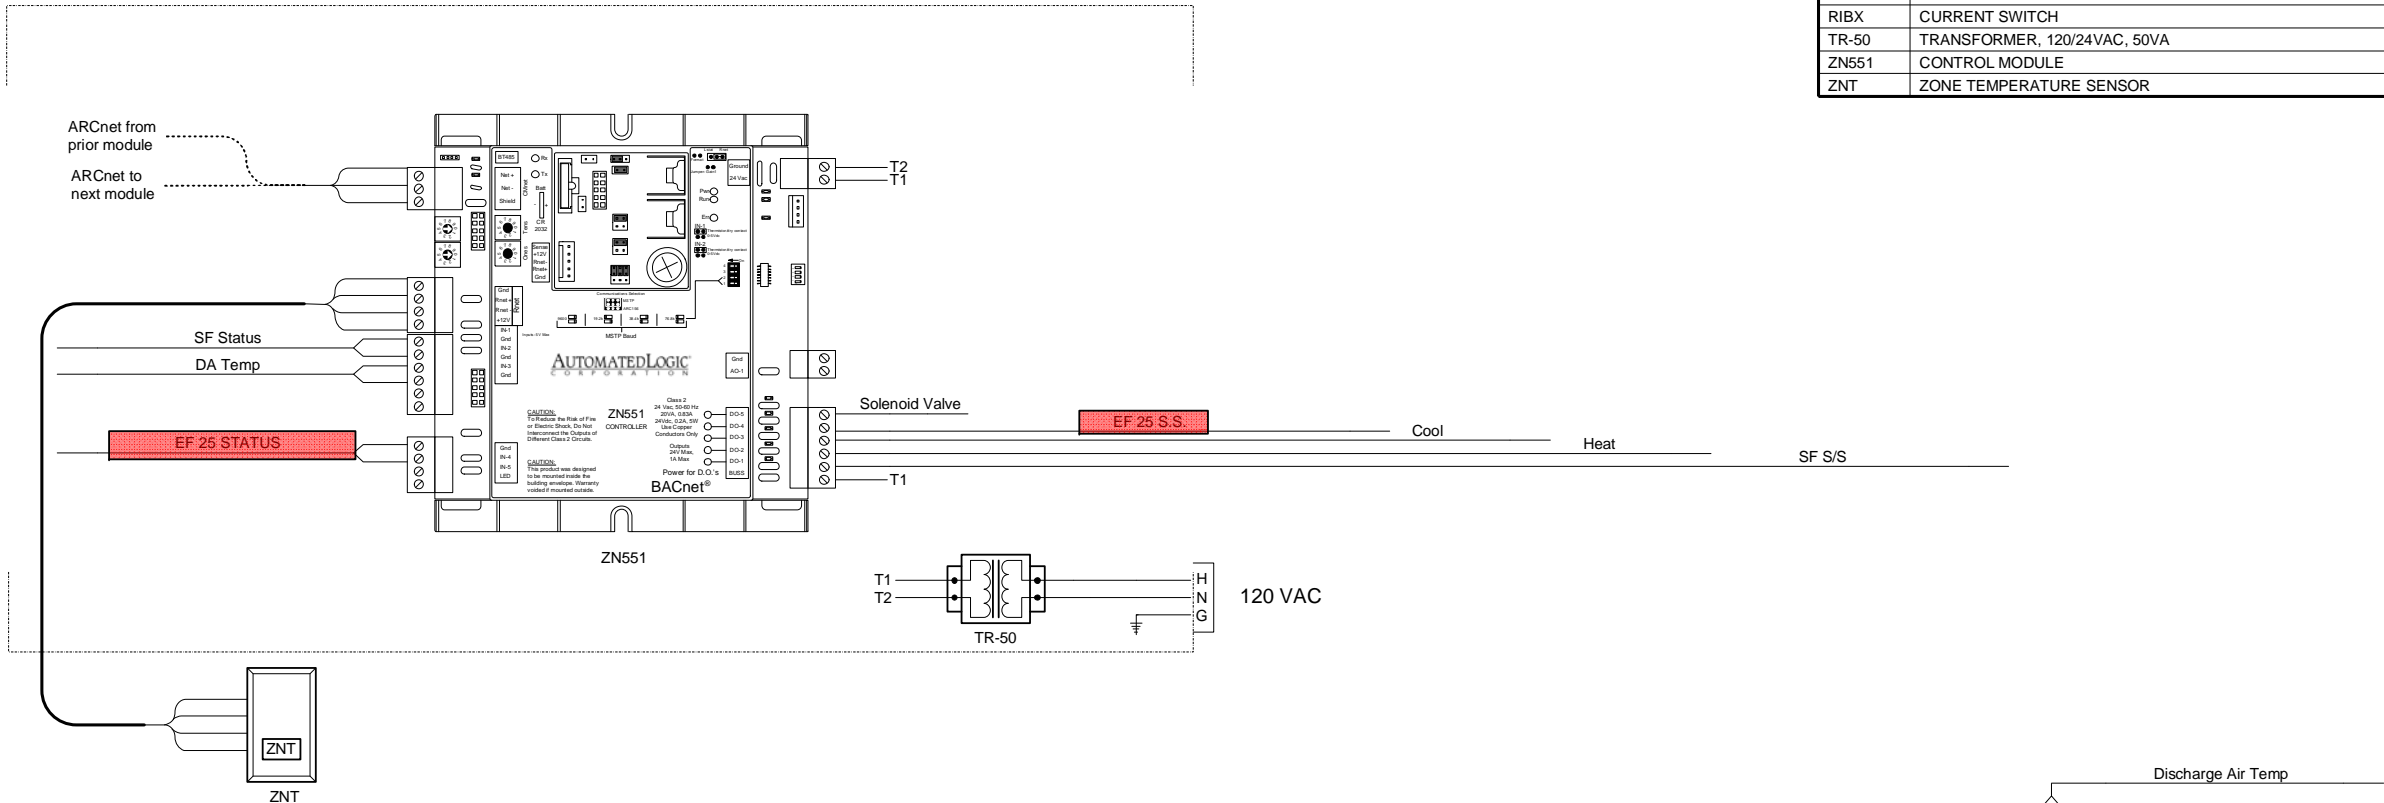

General Notes:
 All ARC156 wiring shall be 22AWG single twisted pair, low capacitance (12.5pF/ft), shielded, plenum rated cable. ALC recommends Magnum Cable Corporation Product number A3ARC156.

Each ARC156 segment must be wired in a daisy chain configuration. Branching requires the use of a REP485.

Each ARC156 segment should have one (1) PROT485 installed to provide protection from electrical surges.


Each ARC156 segment end must be terminated with a TERM485 (120 ohm) terminating resistor.

The ARC156 network segment must have at least one (1) DIAG485 installed to supply bias.

Do not strip back shielded cable sheath more than 1" in order to keep twisted pair from separating. Do not ground shield to the panel or chassis ground. The shield should only be connected to the "Optional Shield" connection at a module.



Routing of communications cabling and control module locations shall be field verified.



DCMO BOCES - Phase 1&2 AS BUILT			
Norwich / Masonville, New York			
Air Temp Heating & Air Conditioning, Inc.			
HPNorwich C157 Offices			
REV: 1	As-Built	11/19/2007	JOB NO: P7425-7290
			CHECK BY: RSL
			DSCODE:
26 of 69			

HPNorwich C161 Special Ed

Bill of Materials				
DID	DESCRIPTION	MANUFACTURER	PART NUMBER	QTY
DATP	DISCHARGE AIR TEMP SENSOR	BAPI	BA/10K-2-RPP-8	102 ea
RIB	RELAY	FUNCTIONAL DEVICES	RIBU1C	102 ea
RIBX	CURRENT SWITCH	FUNCTIONAL DEVICES	RIBXKF	102 ea
TR-50	TRANSFORMER, 120/24VAC, 50VA	FUNCTIONAL DEVICES	TR50VA002	102 ea
ZN551	CONTROL MODULE	AUTOMATED LOGIC	ZN551	102 ea
ZNT	ZONE TEMPERATURE SENSOR	AUTOMATED LOGIC	RS PLUS	102 ea

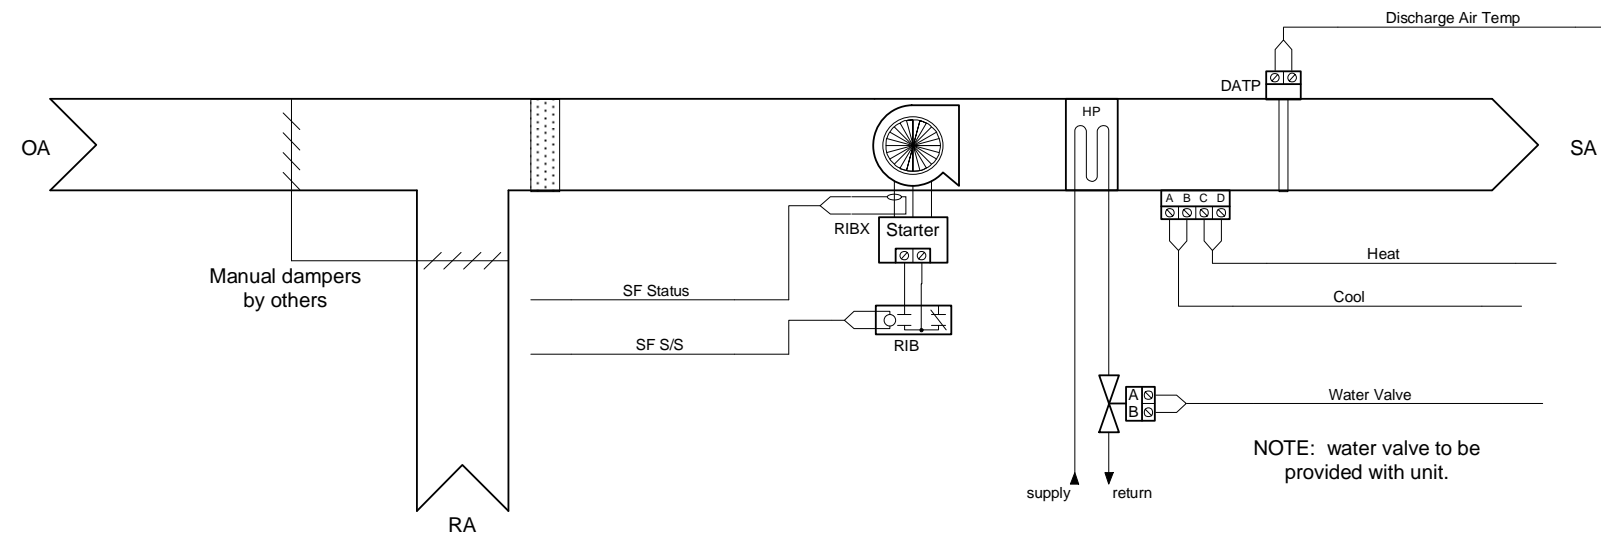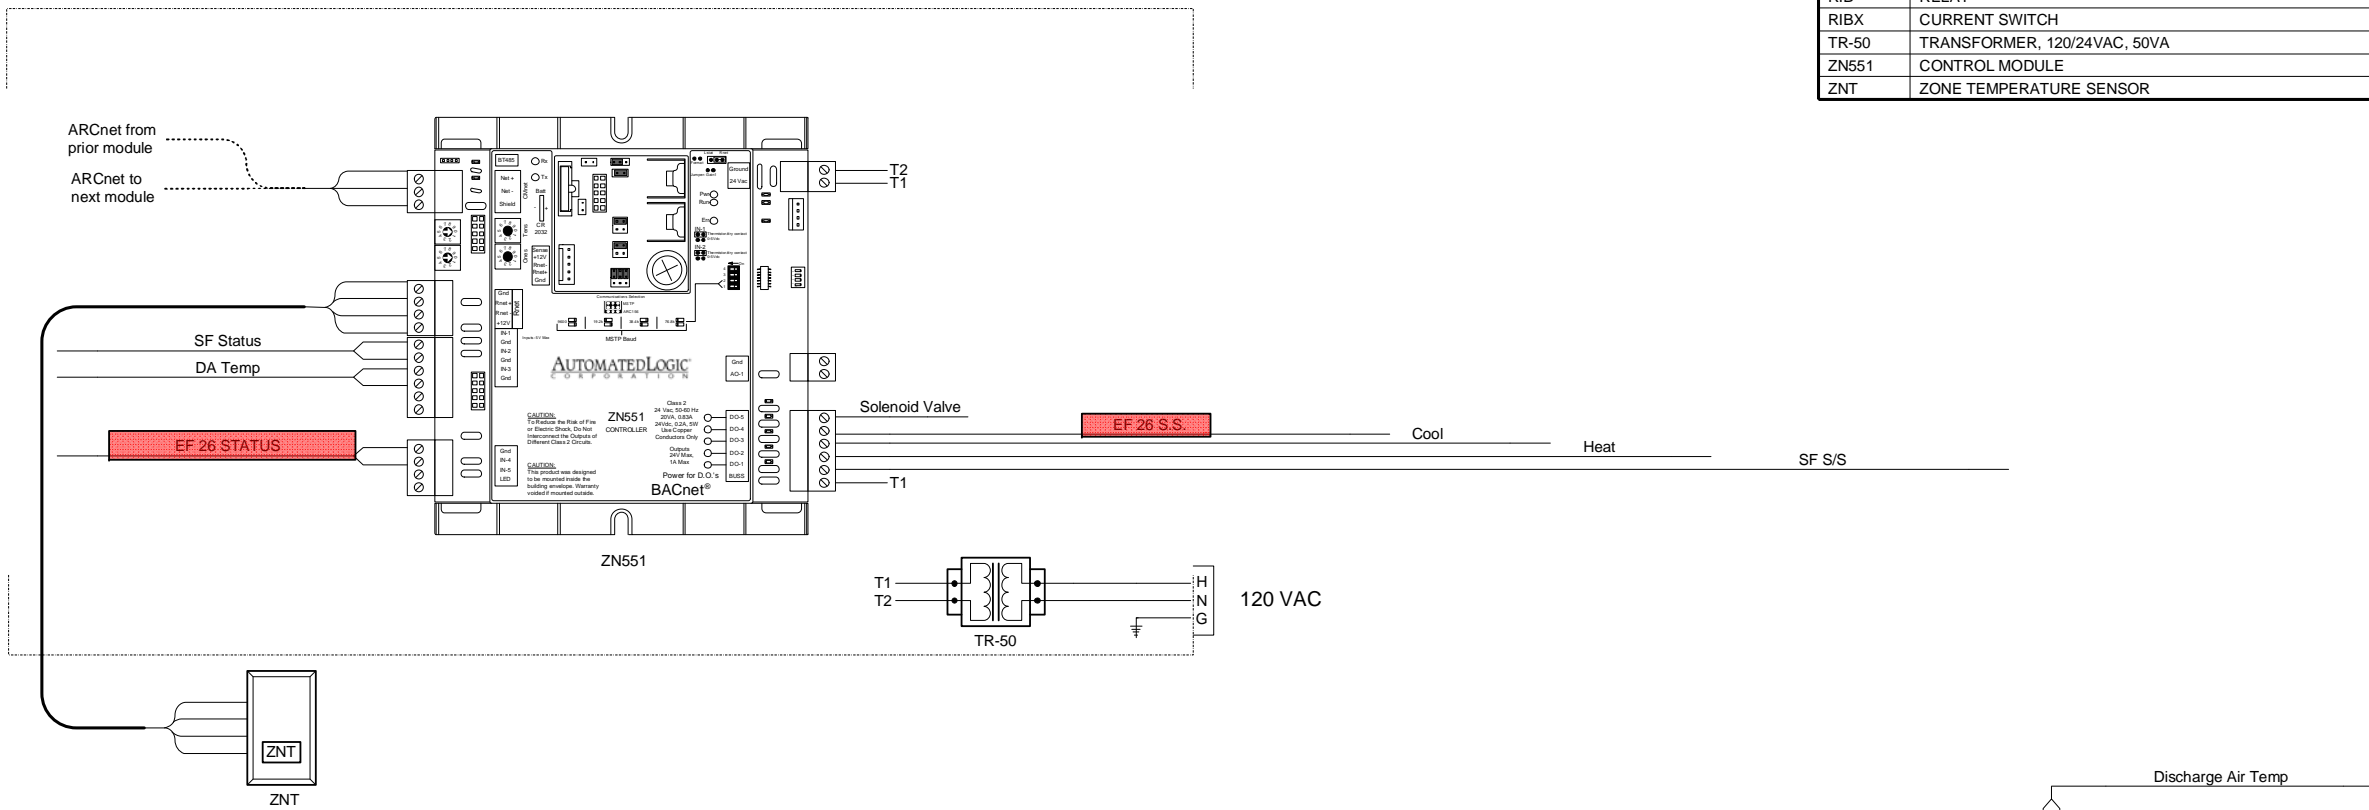

General Notes:

All ARC156 wiring shall be 22AWG single twisted pair, low capacitance (12.5pF/ft), shielded, plenum rated cable. ALC recommends Magnum Cable Corporation Product number A3ARC156.

Each ARC156 segment must be wired in a daisy chain configuration. Branching requires the use of a REP485.

Each ARC156 segment should have one (1) PROT485 installed to provide protection from electrical surges.


Each ARC156 segment end must be terminated with a TERM485 (120 ohm) terminating resistor.

The ARC156 network segment must have at least one (1) DIAG485 installed to supply bias.

Do not strip back shielded cable sheath more than 1" in order to keep twisted pair from separating. Do not ground shield to the panel or chassis ground. The shield should only be connected to the "Optional Shield" connection at a module.


Routing of communications cabling and control module locations shall be field verified.

NORWICH

DCMO BOCES - Phase 1&2 AS BUILT			
Norwich / Masonville, New York			
Air Temp Heating & Air Conditioning, Inc.			
HPNorwich C161 Special Ed			
REV: 1	As-Built	11/19/2007	JOB NO: P7425-7290
CHECK BY: RSL			DSCODE:
 AIR TEMP HEATING & AIR CONDITIONING, INC. A LINC SERVICE © CONTRACTOR			27 of 69

Riser 2

DCMO HAROLD CAMPUS

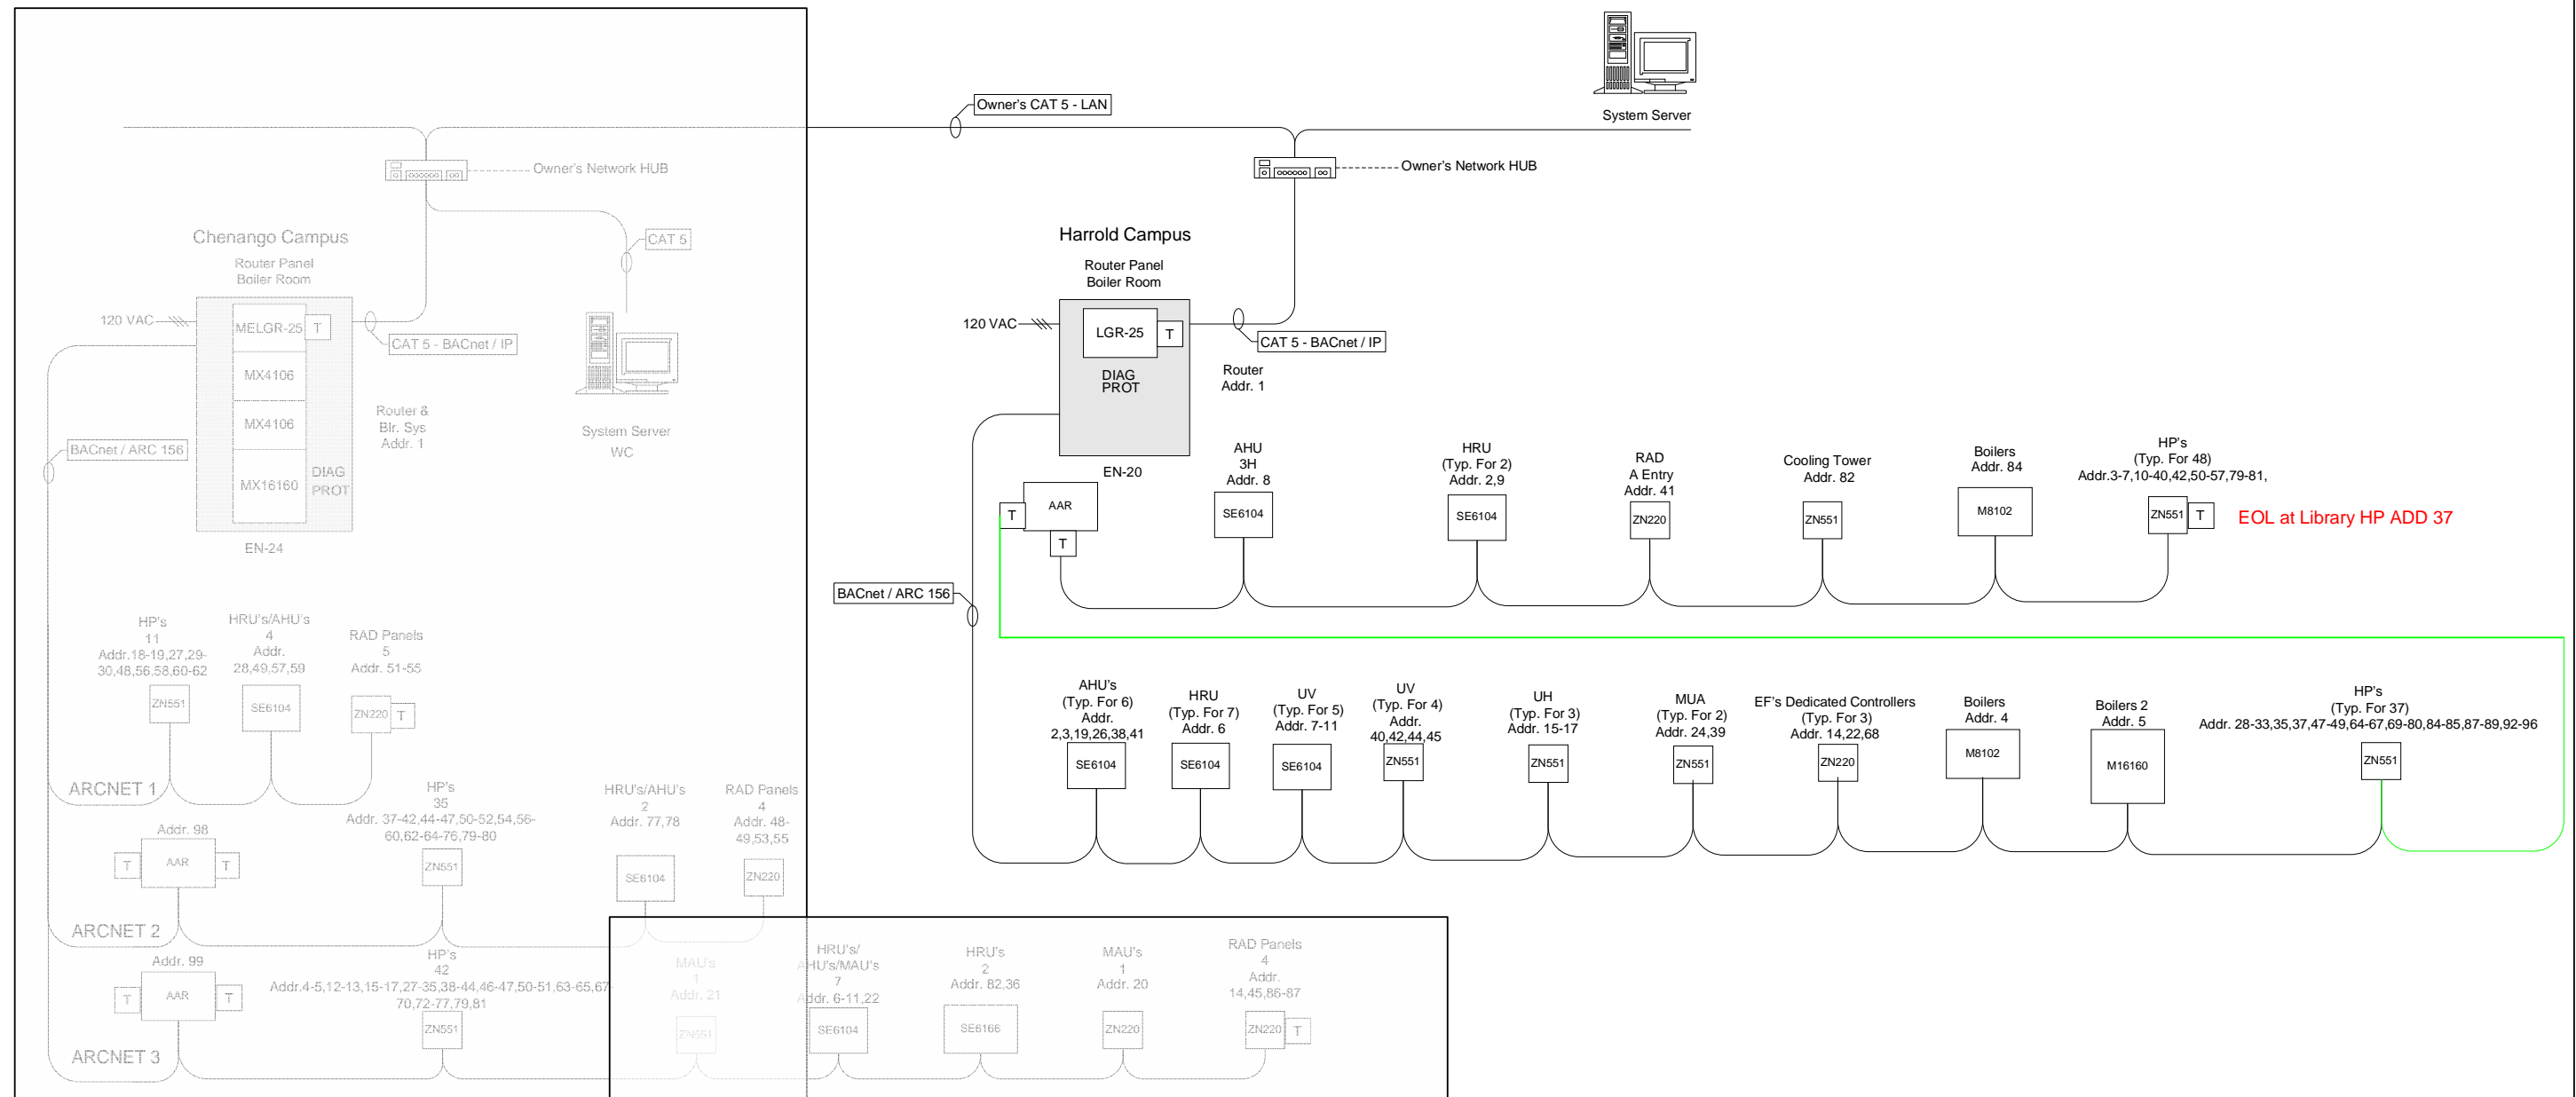

General Notes:

All ARC156 wiring shall be 22AWG single twisted pair, low capacitance (12.5pF/ft), shielded, plenum rated cable. ALC recommends Magnum Cable Corporation Product number A3ARC156.

Each ARC156 segment must be wired in a daisy chain configuration. Branching requires the use of a REP485.


Each ARC156 segment should have one (1) PROT485 installed to provide protection from electrical surges.


Each ARC156 segment end must be terminated with a TERM485 (120 ohm) terminating resistor.

The ARC156 network segment must have at least one (1) DIAG485 installed to supply bias.

Do not strip back shielded cable sheath more than 1" in order to keep twisted pair from separating. Do not ground shield to the panel or chassis ground. The shield should only be connected to the "Optional Shield" connection at a module.



Routing of communications cabling and control module locations shall be field verified.

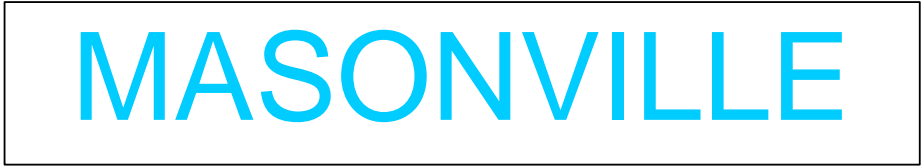

DCMO BOCES - Phase 1&2 AS BUILT			
Norwich / Masonville, New York			
Air Temp Heating & Air Conditioning, Inc.			
Riser 2			
REV: 1	As-Built	11/19/2007	JOB NO: P7425-7290
			CHECK BY: RSL
			DSCODE:
			28 of 69

HPNorwich C118 Computer Network

Bill of Materials				
DID	DESCRIPTION	MANUFACTURER	PART NUMBER	QTY
DATP	DISCHARGE AIR TEMP SENSOR	BAPI	BA/10K-2-RPP-8	102 ea
RIB	RELAY	FUNCTIONAL DEVICES	RIBU1C	102 ea
RIBX	CURRENT SWITCH	FUNCTIONAL DEVICES	RIBXKF	102 ea
TR-50	TRANSFORMER, 120/24VAC, 50VA	FUNCTIONAL DEVICES	TR50VA002	102 ea
ZN551	CONTROL MODULE	AUTOMATED LOGIC	ZN551	102 ea
ZNT	ZONE TEMPERATURE SENSOR	AUTOMATED LOGIC	RS PLUS	102 ea

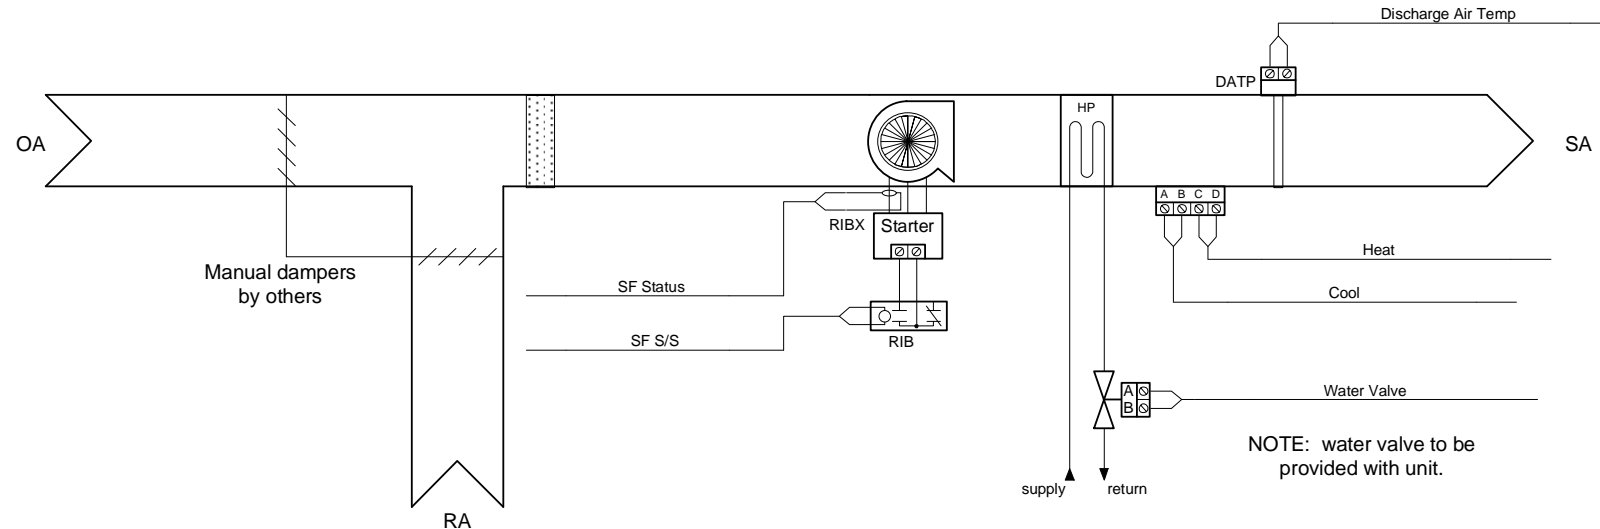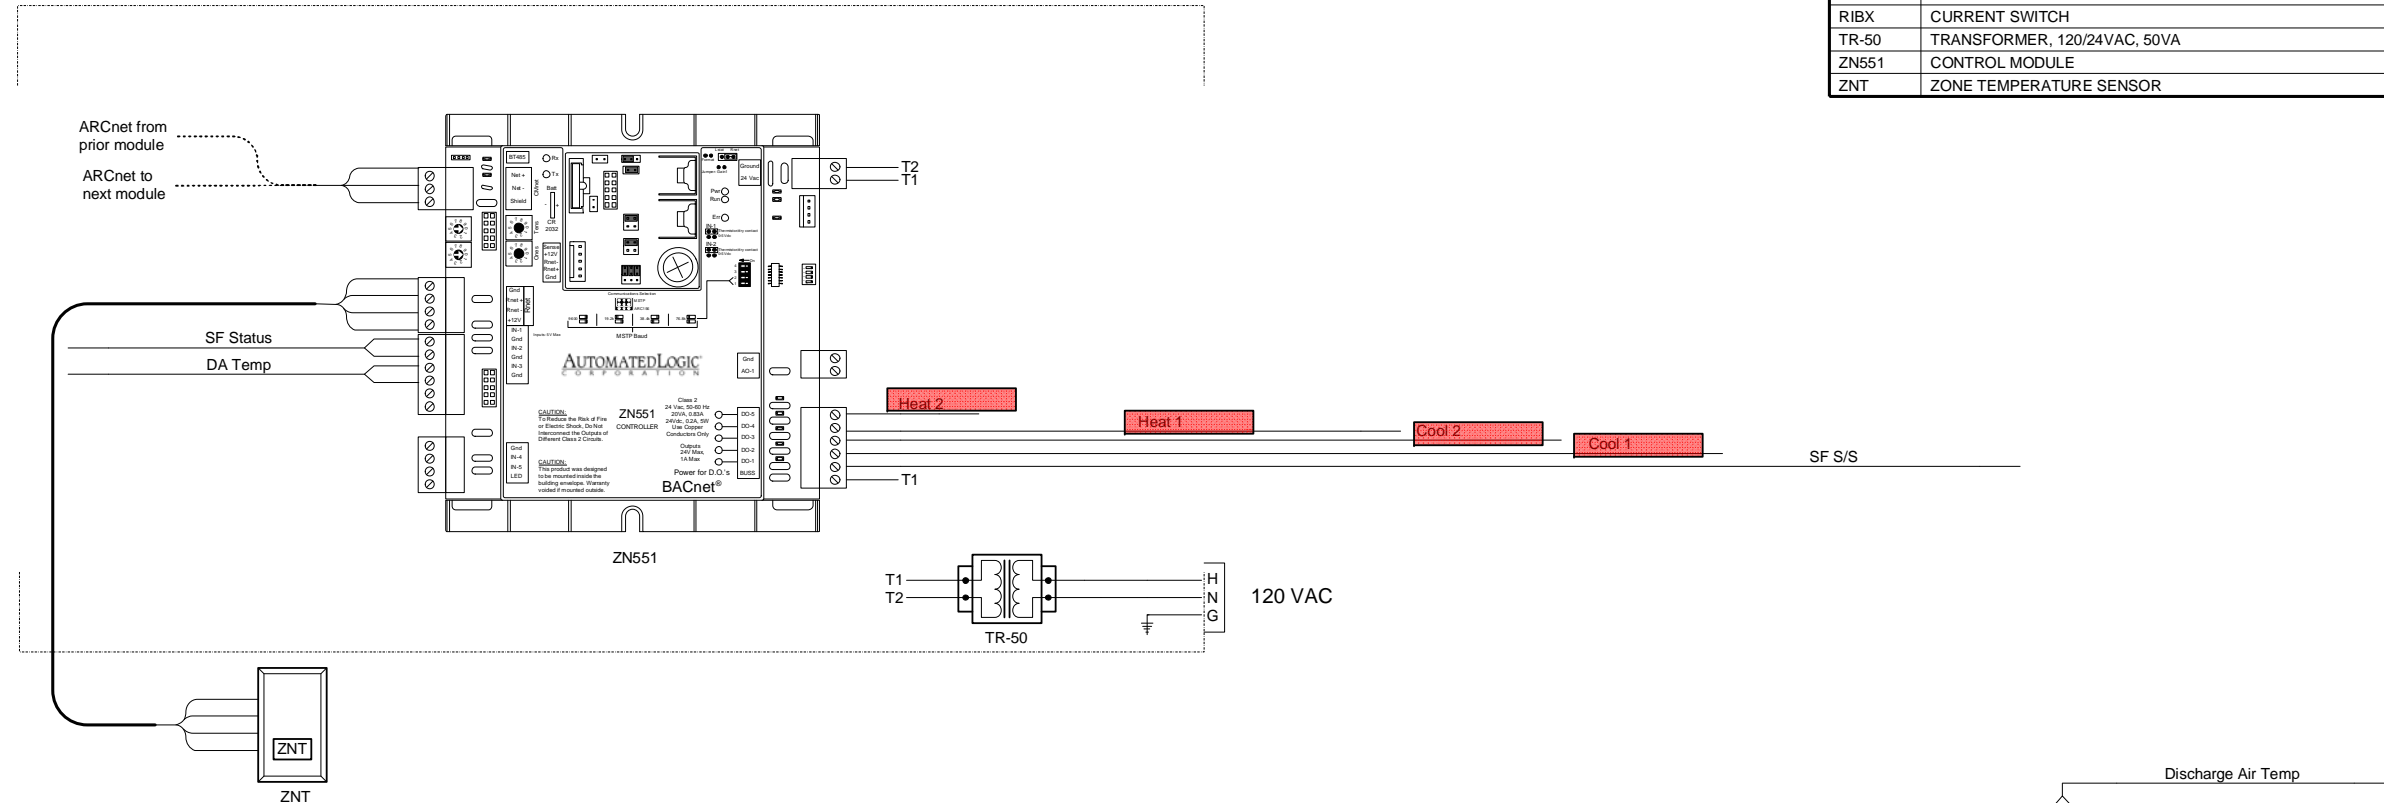

General Notes:

- All ARC156 wiring shall be 22AWG single twisted pair, low capacitance (12.5pF/ft), shielded, plenum rated cable. ALC recommends Magnum Cable Corporation Product number A3ARC156.
- Each ARC156 segment must be wired in a daisy chain configuration. Branching requires the use of a REP485.
- Each ARC156 segment should have one (1) PROT485 installed to provide protection from electrical surges.
- Each ARC156 segment end must be terminated with a TERM485 (120 ohm) terminating resistor.
- The ARC156 network segment must have at least one (1) DIAG485 installed to supply bias.
- Do not strip back shielded cable sheath more than 1" in order to keep twisted pair from separating. Do not ground shield to the panel or chassis ground. The shield should only be connected to the "Optional Shield" connection at a module.
- Routing of communications cabling and control module locations shall be field verified.



DCMO BOCES - Phase 1&2 AS BUILT
 Norwich / Masonville, New York

Air Temp Heating & Air Conditioning, Inc.
 HPNorwich C118 Computer Network


REV: 1	As-Built	11/19/2007	JOB NO: P7425-7290
CHECK BY: RSL			DSCODE:

AIR TEMP HEATING & AIR CONDITIONING, INC.
 A LINC SERVICE CONTRACTOR

29 of 69

HPNorwich HP C154 Special Ed

Bill of Materials				
DID	DESCRIPTION	MANUFACTURER	PART NUMBER	QTY
DATP	DISCHARGE AIR TEMP SENSOR	BAPI	BA/10K-2-RPP-8	102 ea
RIB	RELAY	FUNCTIONAL DEVICES	RIBU1C	102 ea
RIBX	CURRENT SWITCH	FUNCTIONAL DEVICES	RIBXKF	102 ea
TR-50	TRANSFORMER, 120/24VAC, 50VA	FUNCTIONAL DEVICES	TR50VA002	102 ea
ZN551	CONTROL MODULE	AUTOMATED LOGIC	ZN551	102 ea
ZNT	ZONE TEMPERATURE SENSOR	AUTOMATED LOGIC	RS PLUS	102 ea

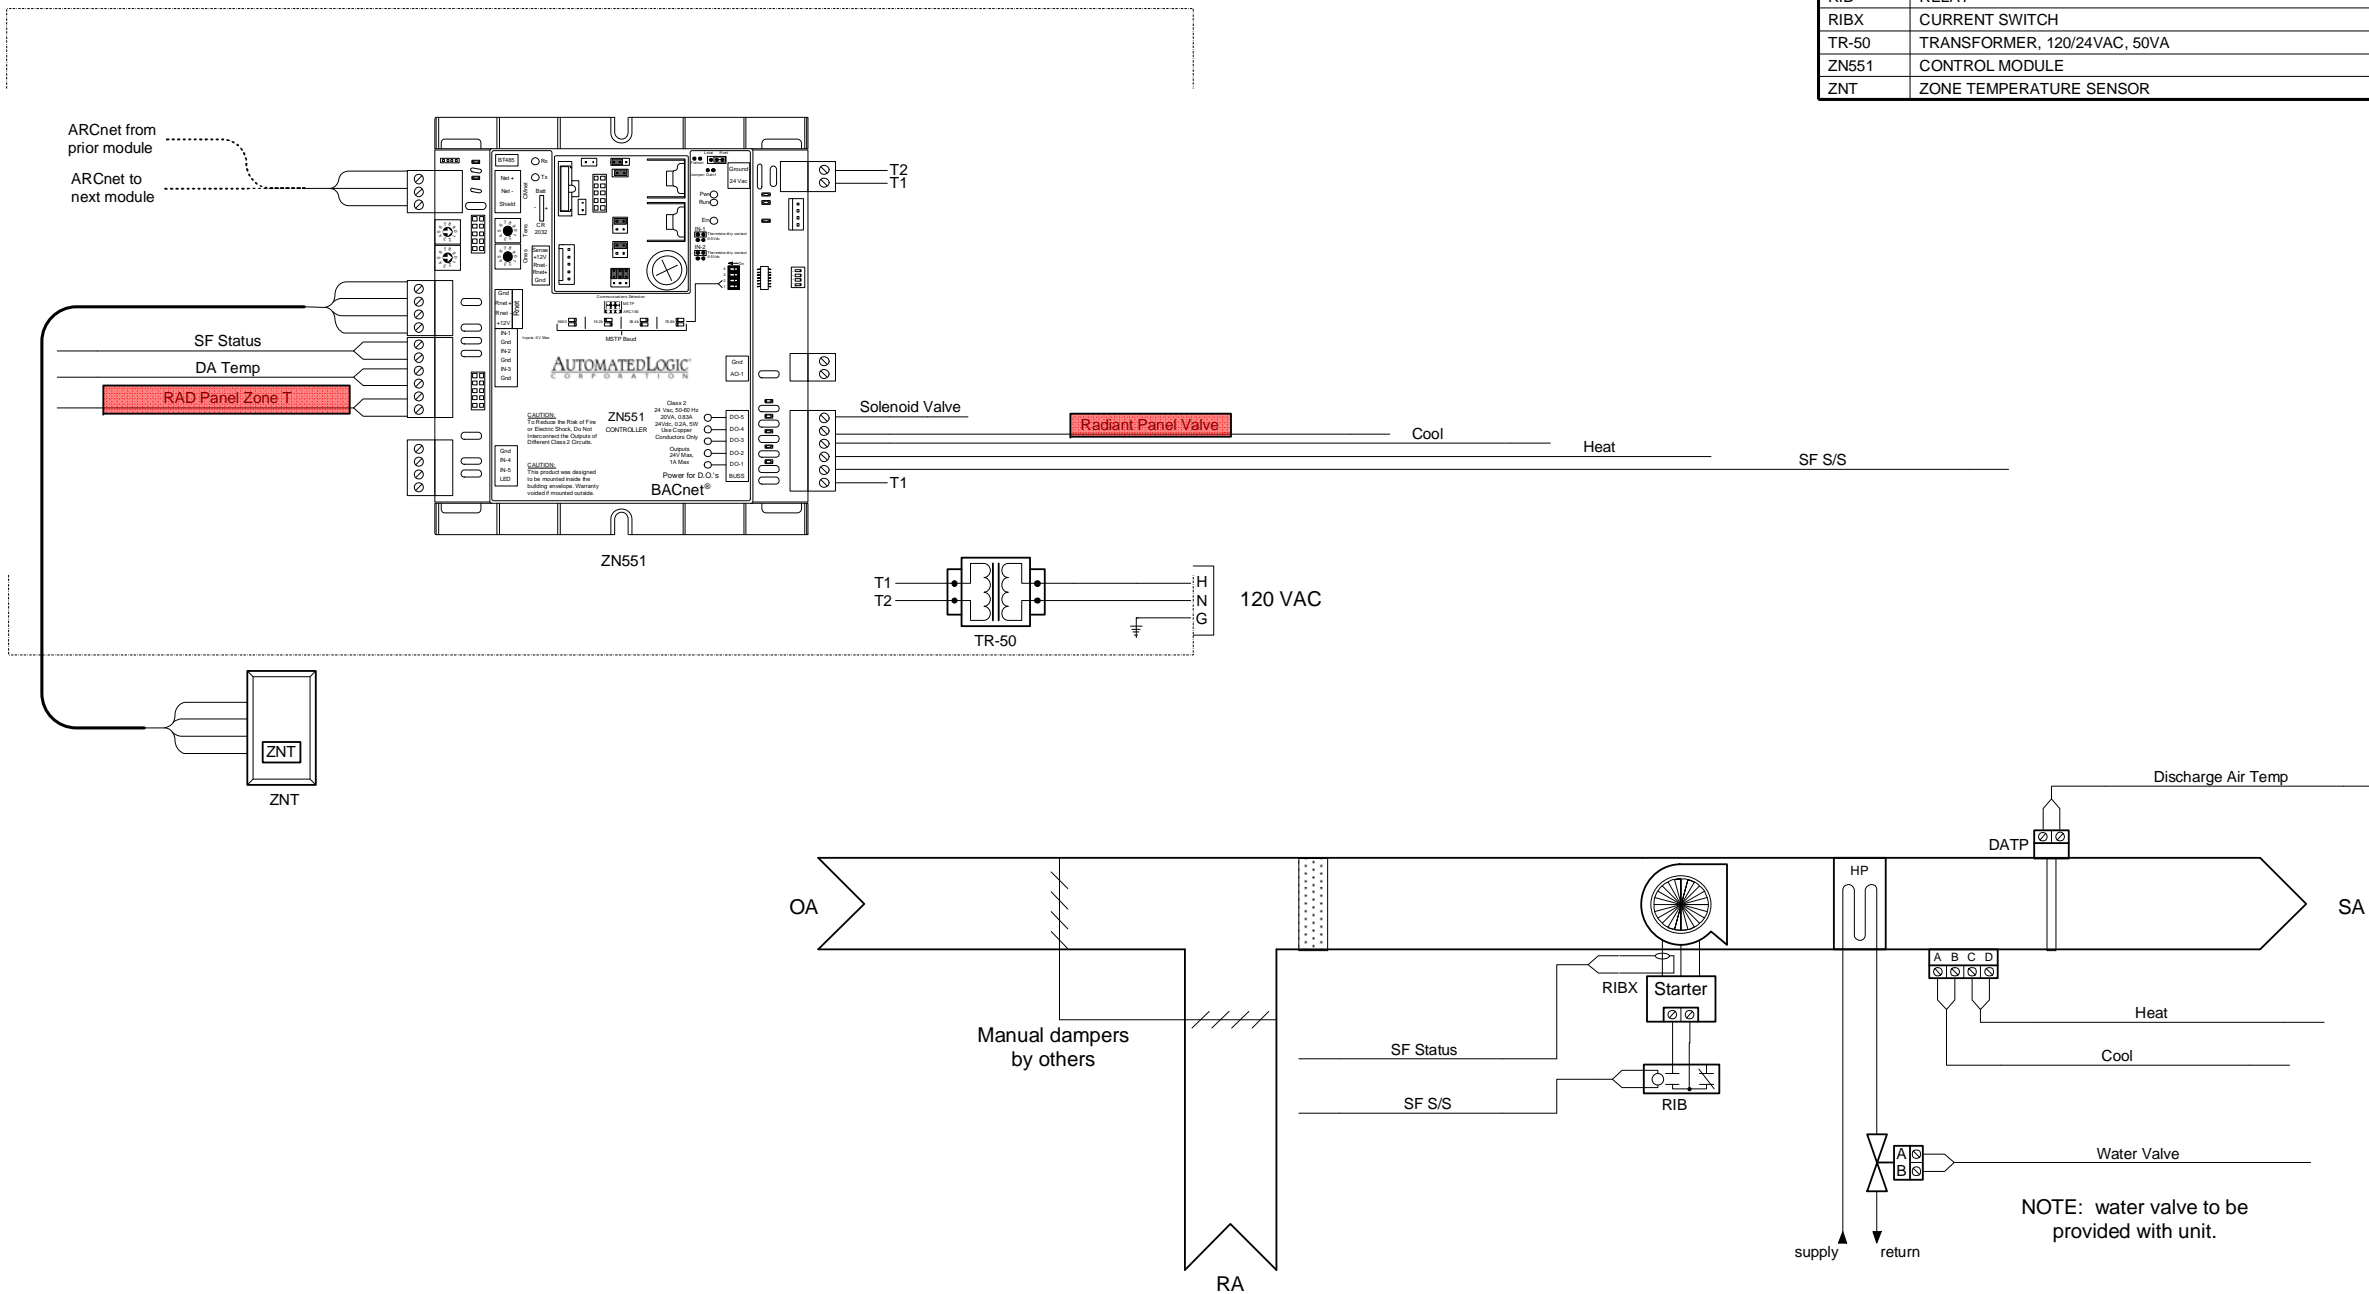

General Notes:

All ARC156 wiring shall be 22AWG single twisted pair, low capacitance (12.5pF/ft), shielded, plenum rated cable. ALC recommends Magnum Cable Corporation Product number A3ARC156.

Each ARC156 segment must be wired in a daisy chain configuration. Branching requires the use of a REP485.

Each ARC156 segment should have one (1) PROT485 installed to provide protection from electrical surges.


Each ARC156 segment end must be terminated with a TERM485 (120 ohm) terminating resistor.

The ARC156 network segment must have at least one (1) DIAG485 installed to supply bias.

Do not strip back shielded cable sheath more than 1" in order to keep twisted pair from separating. Do not ground shield to the panel or chassis ground. The shield should only be connected to the "Optional Shield" connection at a module.


Routing of communications cabling and control module locations shall be field verified.



DCMO BOCES - Phase 1&2 AS BUILT			
Norwich / Masonville, New York			
Air Temp Heating & Air Conditioning, Inc.			
HPNorwich HP C154 Special Ed			
REV: 1	As-Built	11/19/2007	JOB NO: P7425-7290
			CHECK BY: RSL
			DSCODE:
30 of 69			

HPNorwich 146 Bathrooms

Bill of Materials				
DID	DESCRIPTION	MANUFACTURER	PART NUMBER	QTY
DATP	DISCHARGE AIR TEMP SENSOR	BAPI	BA/10K-2-RPP-8	102 ea
RIB	RELAY	FUNCTIONAL DEVICES	RIBU1C	102 ea
RIBX	CURRENT SWITCH	FUNCTIONAL DEVICES	RIBXKF	102 ea
TR-50	TRANSFORMER, 120/24VAC, 50VA	FUNCTIONAL DEVICES	TR50VA002	102 ea
ZN551	CONTROL MODULE	AUTOMATED LOGIC	ZN551	102 ea
ZNT	ZONE TEMPERATURE SENSOR	AUTOMATED LOGIC	RS PLUS	102 ea

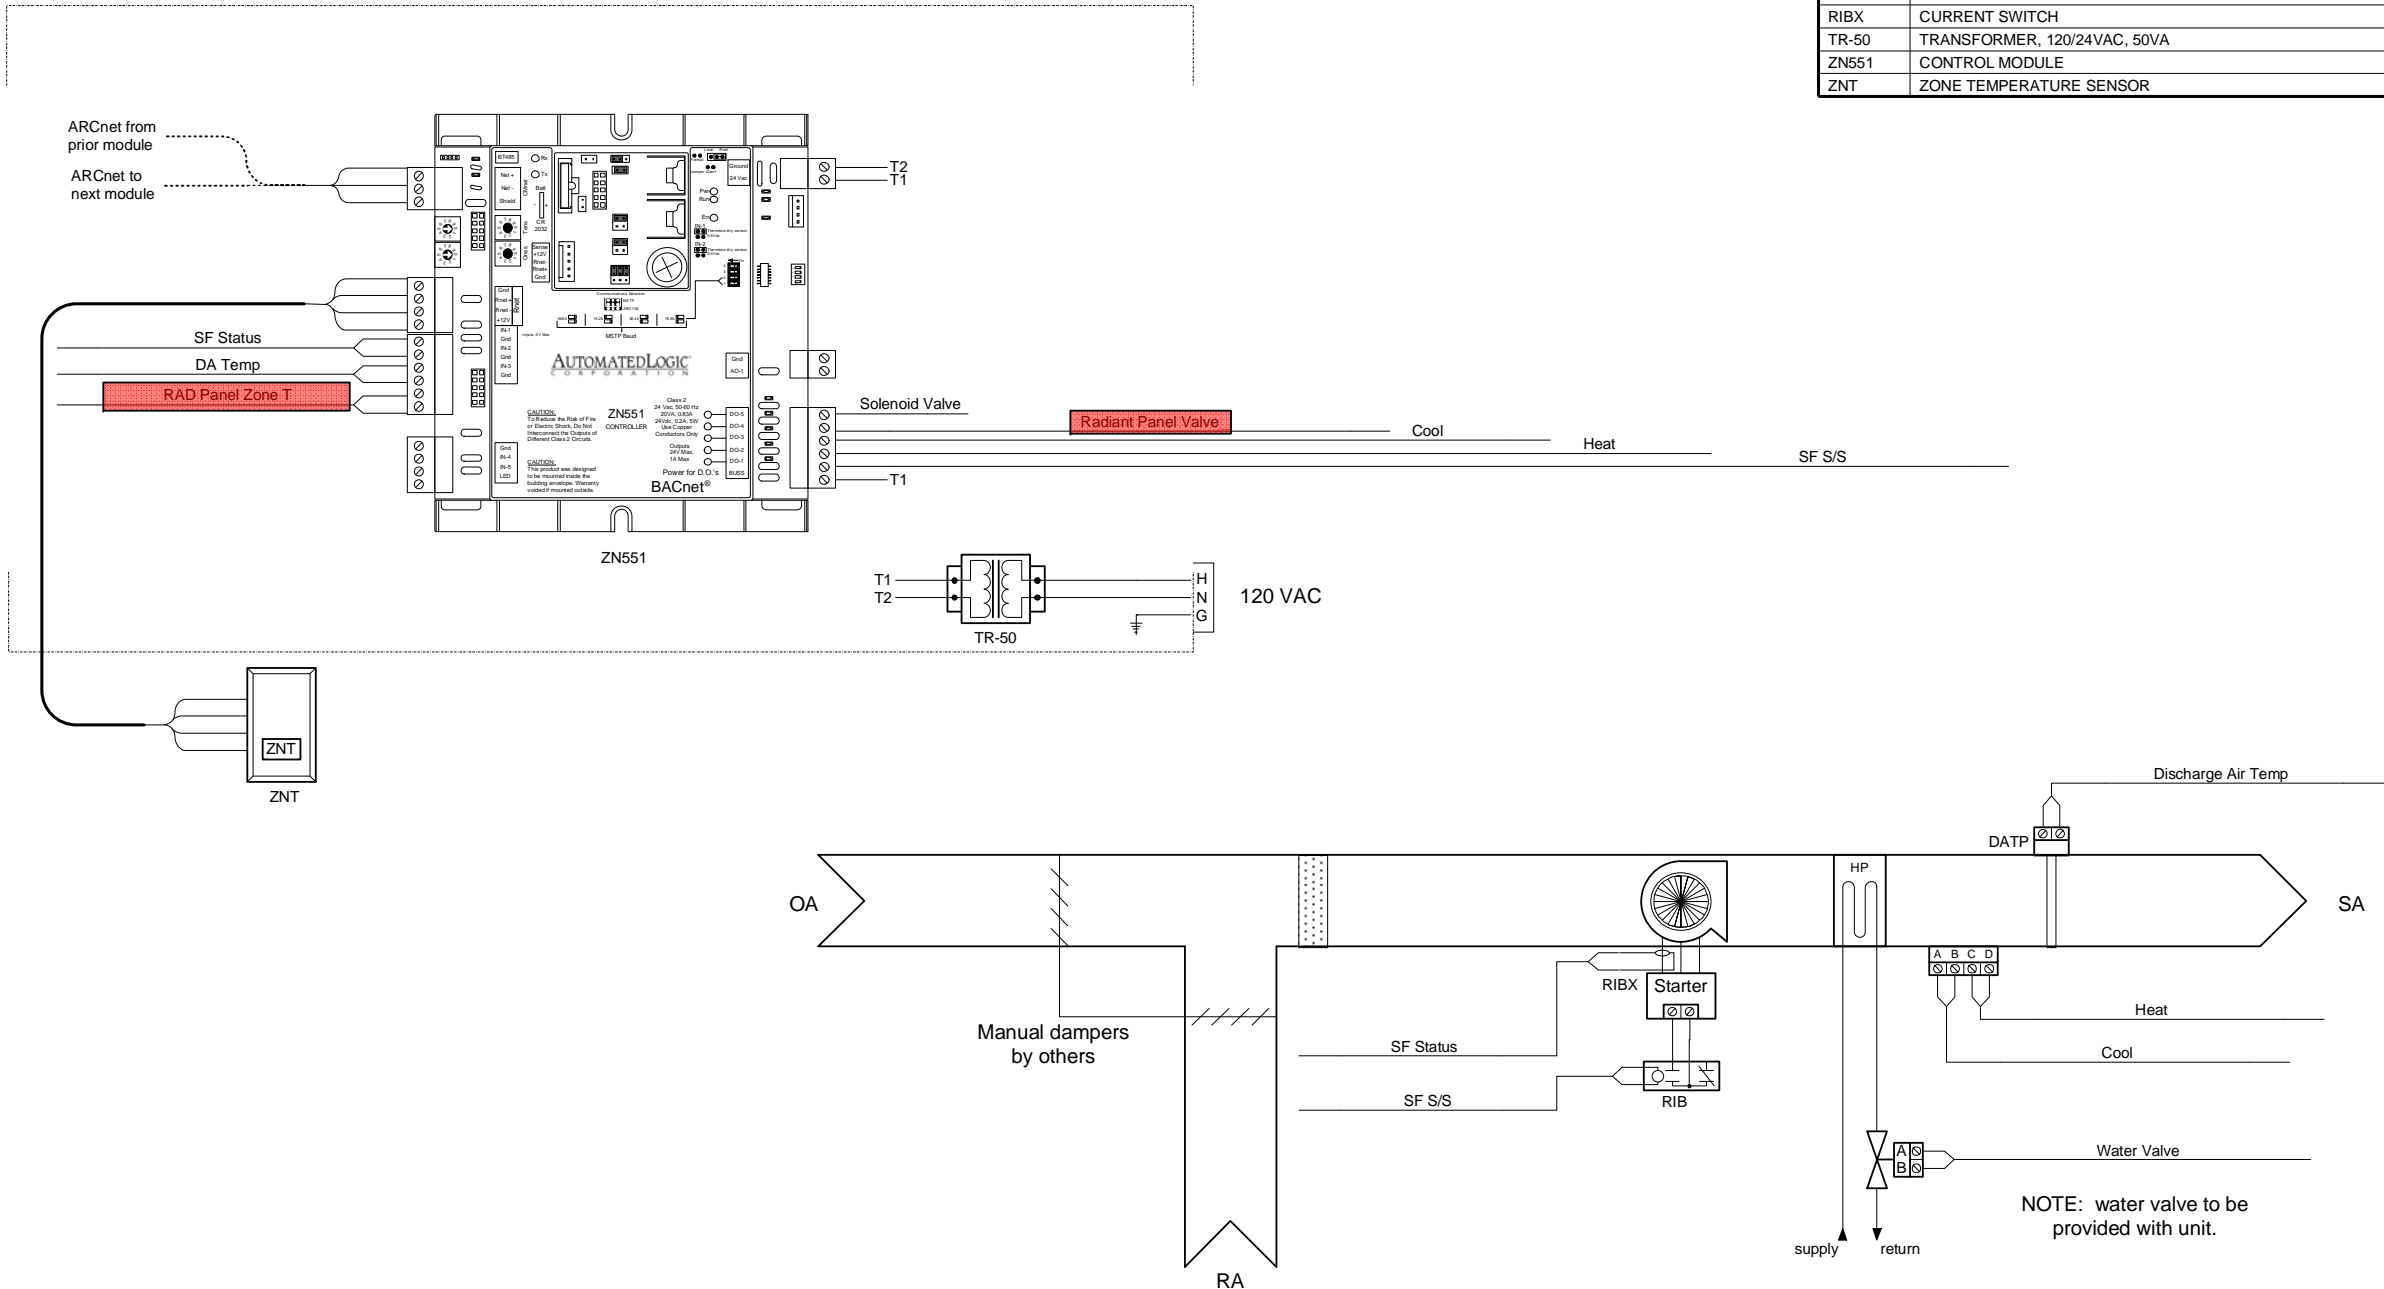

General Notes:
 All ARC156 wiring shall be 22AWG single twisted pair, low capacitance (12.5pF/ft), shielded, plenum rated cable. ALC recommends Magnum Cable Corporation Product number A3ARC156.

Each ARC156 segment must be wired in a daisy chain configuration. Branching requires the use of a REP485.

Each ARC156 segment should have one (1) PROT485 installed to provide protection from electrical surges.

Each ARC156 segment end must be terminated with a TERM485 (120 ohm) terminating resistor.

The ARC156 network segment must have at least one (1) DIAG485 installed to supply bias.

Do not strip back shielded cable sheath more than 1" in order to keep twisted pair from separating. Do not ground shield to the panel or chassis ground. The shield should only be connected to the "Optional Shield" connection at a module.

Routing of communications cabling and control module locations shall be field verified.


NORWICH

DCMO BOCES - Phase 1&2 AS BUILT			
Norwich / Masonville, New York			
Air Temp Heating & Air Conditioning, Inc.			
HPNorwich 146 Bathrooms			
REV: 1	As-Built	11/19/2007	JOB NO: P7425-7290
			CHECK BY: RSL
			DSCODE:
			31 of 69





HPNorwich C136 Bathrooms

Bill of Materials				
DID	DESCRIPTION	MANUFACTURER	PART NUMBER	QTY
DATP	DISCHARGE AIR TEMP SENSOR	BAPI	BA/10K-2-RPP-8	102 ea
RIB	RELAY	FUNCTIONAL DEVICES	RIBU1C	102 ea
RIBX	CURRENT SWITCH	FUNCTIONAL DEVICES	RIBXKF	102 ea
TR-50	TRANSFORMER, 120/24VAC, 50VA	FUNCTIONAL DEVICES	TR50VA002	102 ea
ZN551	CONTROL MODULE	AUTOMATED LOGIC	ZN551	102 ea
ZNT	ZONE TEMPERATURE SENSOR	AUTOMATED LOGIC	RS PLUS	102 ea

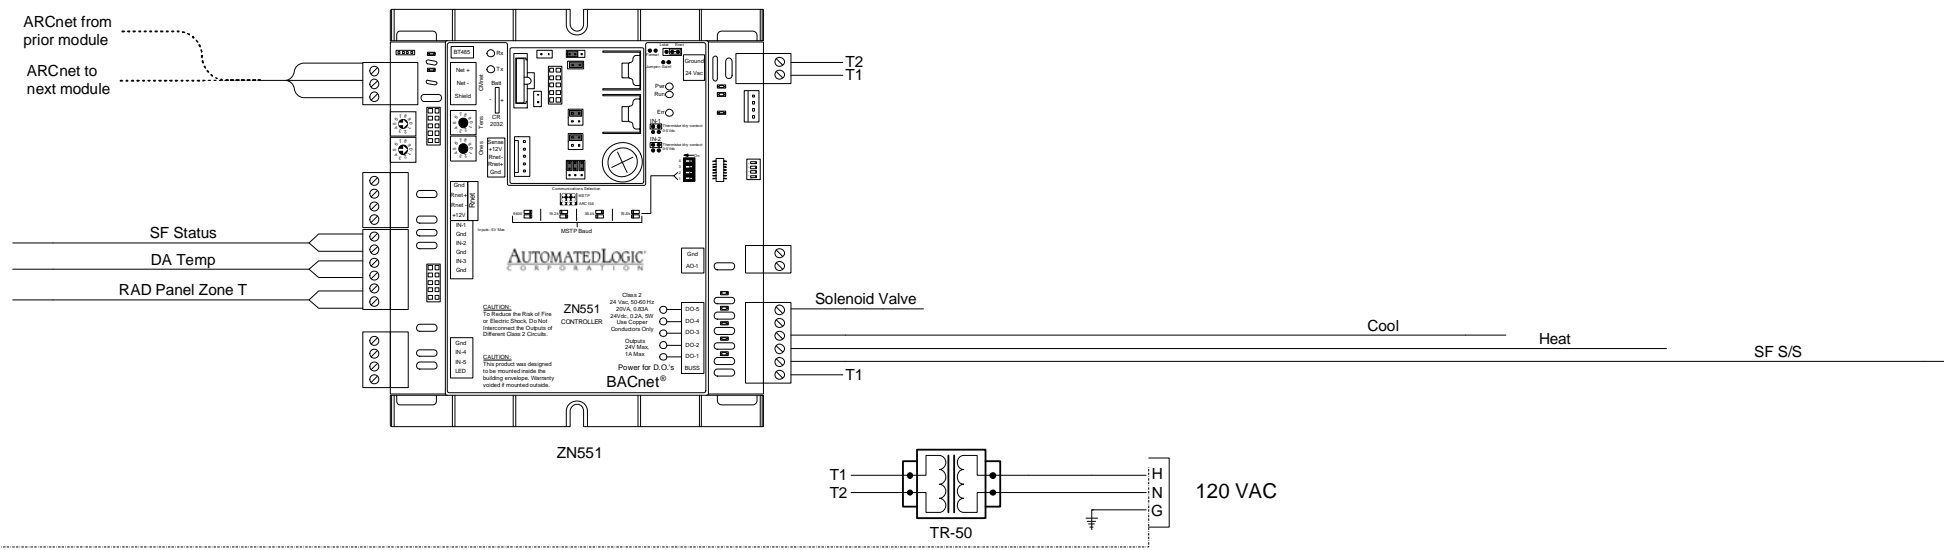

NETWORKED FROM Address 55

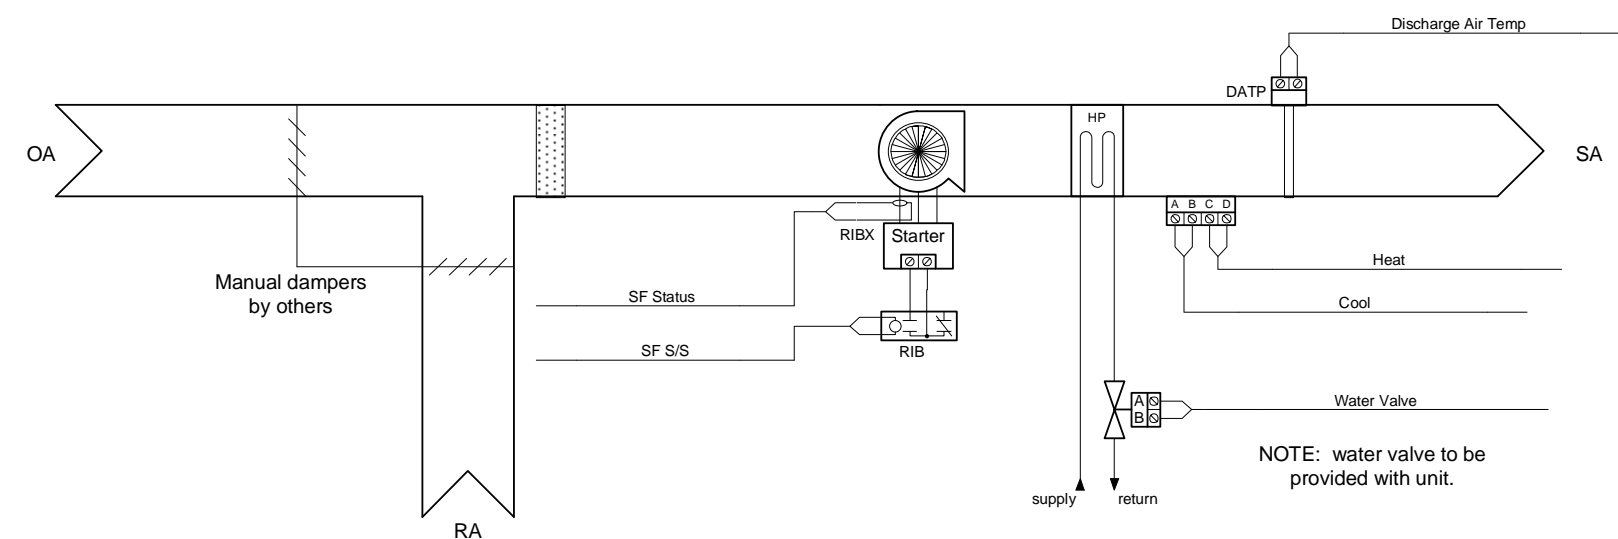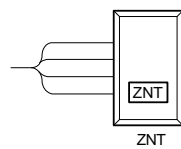

General Notes:

All ARC156 wiring shall be 22AWG single twisted pair, low capacitance (12.5pF/ft), shielded, plenum rated cable. ALC recommends Magnum Cable Corporation Product number A3ARC156.

Each ARC156 segment must be wired in a daisy chain configuration. Branching requires the use of a REP485.

Each ARC156 segment should have one (1) PROT485 installed to provide protection from electrical surges.


Each ARC156 segment end must be terminated with a TERM485 (120 ohm) terminating resistor.

The ARC156 network segment must have at least one (1) DIAG485 installed to supply bias.

Do not strip back shielded cable sheath more than 1" in order to keep twisted pair from separating. Do not ground shield to the panel or chassis ground. The shield should only be connected to the "Optional Shield" connection at a module.


Routing of communications cabling and control module locations shall be field verified.





DCMO BOCES - Phase 1&2 AS BUILT			
Norwich / Masonville, New York			
Air Temp Heating & Air Conditioning, Inc.			
HPNorwich C136 Bathrooms			
REV: 1	As-Built	11/19/2007	JOB NO: P7425-7290
			CHECK BY: RSL
			DSCODE:
32 of 69			

HPNorwich C133.1 Girls Locker

Bill of Materials				
DID	DESCRIPTION	MANUFACTURER	PART NUMBER	QTY
DATP	DISCHARGE AIR TEMP SENSOR	BAPI	BA/10K-2-RPP-8	102 ea
RIB	RELAY	FUNCTIONAL DEVICES	RIBU1C	102 ea
RIBX	CURRENT SWITCH	FUNCTIONAL DEVICES	RIBXKF	102 ea
TR-50	TRANSFORMER, 120/24VAC, 50VA	FUNCTIONAL DEVICES	TR50VA002	102 ea
ZN551	CONTROL MODULE	AUTOMATED LOGIC	ZN551	102 ea
ZNT	ZONE TEMPERATURE SENSOR	AUTOMATED LOGIC	RS PLUS	102 ea

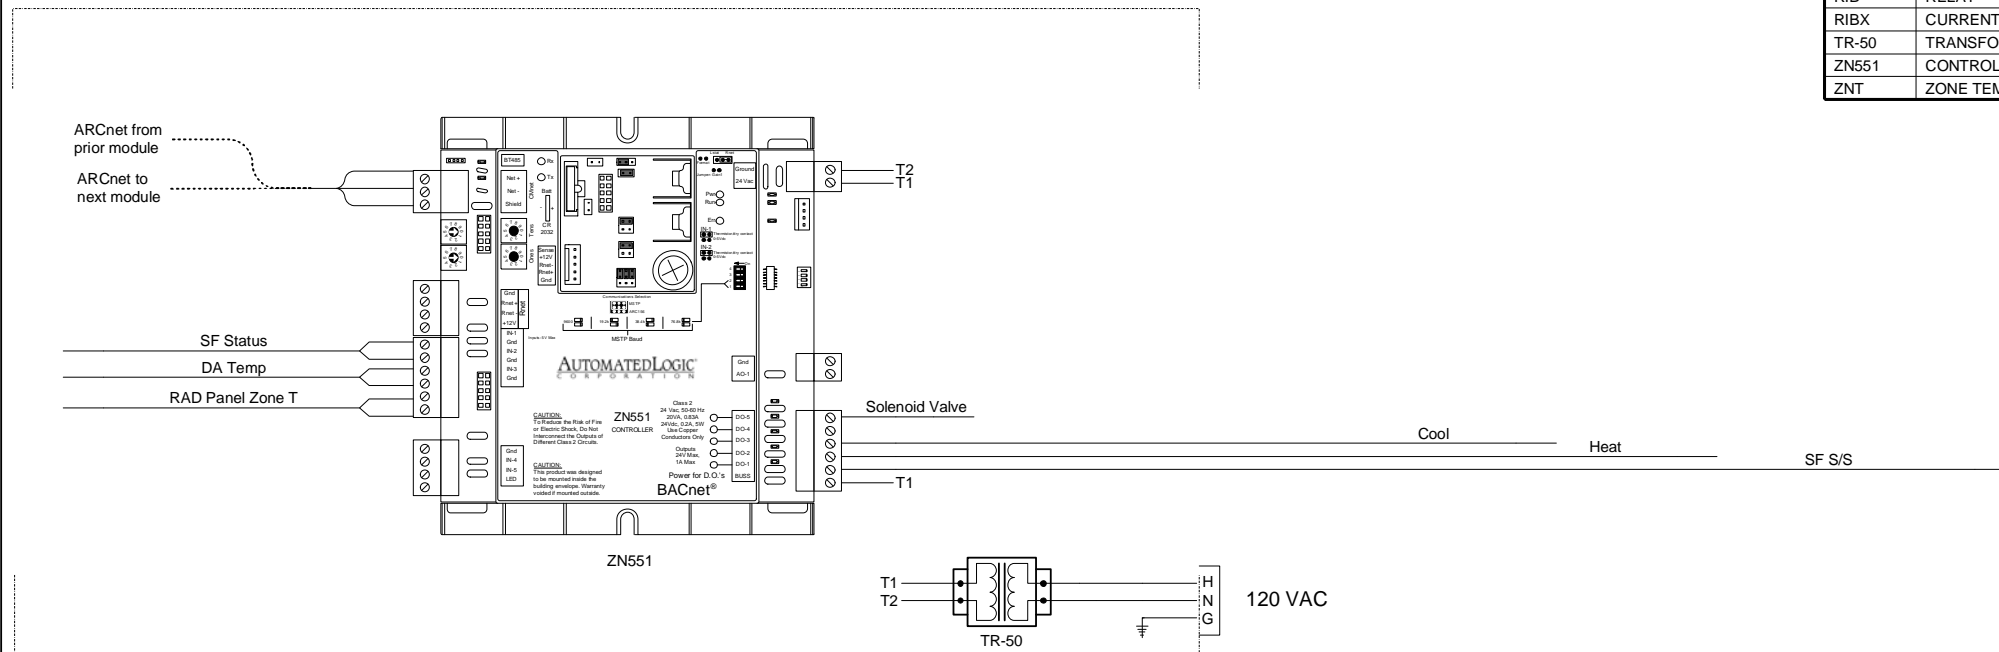

NETWORKED FROM Address 52

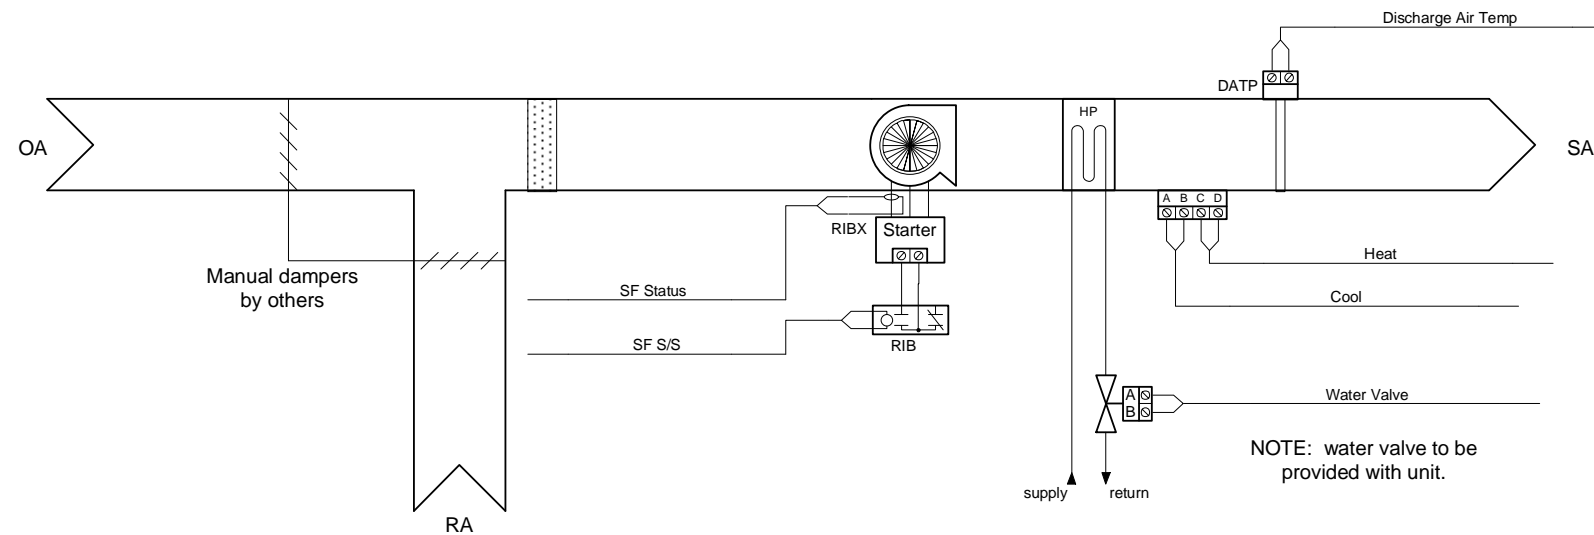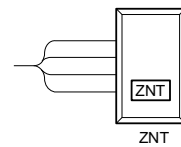

General Notes:

All ARC156 wiring shall be 22AWG single twisted pair, low capacitance (12.5pF/ft), shielded, plenum rated cable. ALC recommends Magnum Cable Corporation Product number A3ARC156.

Each ARC156 segment must be wired in a daisy chain configuration. Branching requires the use of a REP485.

Each ARC156 segment should have one (1) PROT485 installed to provide protection from electrical surges.


Each ARC156 segment end must be terminated with a TERM485 (120 ohm) terminating resistor.

The ARC156 network segment must have at least one (1) DIAG485 installed to supply bias.

Do not strip back shielded cable sheath more than 1" in order to keep twisted pair from separating. Do not ground shield to the panel or chassis ground. The shield should only be connected to the "Optional Shield" connection at a module.


Routing of communications cabling and control module locations shall be field verified.





DCMO BOCES - Phase 1&2 AS BUILT			
Norwich / Masonville, New York			
Air Temp Heating & Air Conditioning, Inc.			
HPNorwich C133.1 Girls Locker			
REV: 1	As-Built	11/19/2007	JOB NO: P7425-7290
			CHECK BY: RSL
			DSCODE:
33 of 69			

HPNorwich C132.1 Boys Locker

Bill of Materials				
DID	DESCRIPTION	MANUFACTURER	PART NUMBER	QTY
DATP	DISCHARGE AIR TEMP SENSOR	BAPI	BA/10K-2-RPP-8	102 ea
RIB	RELAY	FUNCTIONAL DEVICES	RIBU1C	102 ea
RIBX	CURRENT SWITCH	FUNCTIONAL DEVICES	RIBXKF	102 ea
TR-50	TRANSFORMER, 120/24VAC, 50VA	FUNCTIONAL DEVICES	TR50VA002	102 ea
ZN551	CONTROL MODULE	AUTOMATED LOGIC	ZN551	102 ea
ZNT	ZONE TEMPERATURE SENSOR	AUTOMATED LOGIC	RS PLUS	102 ea

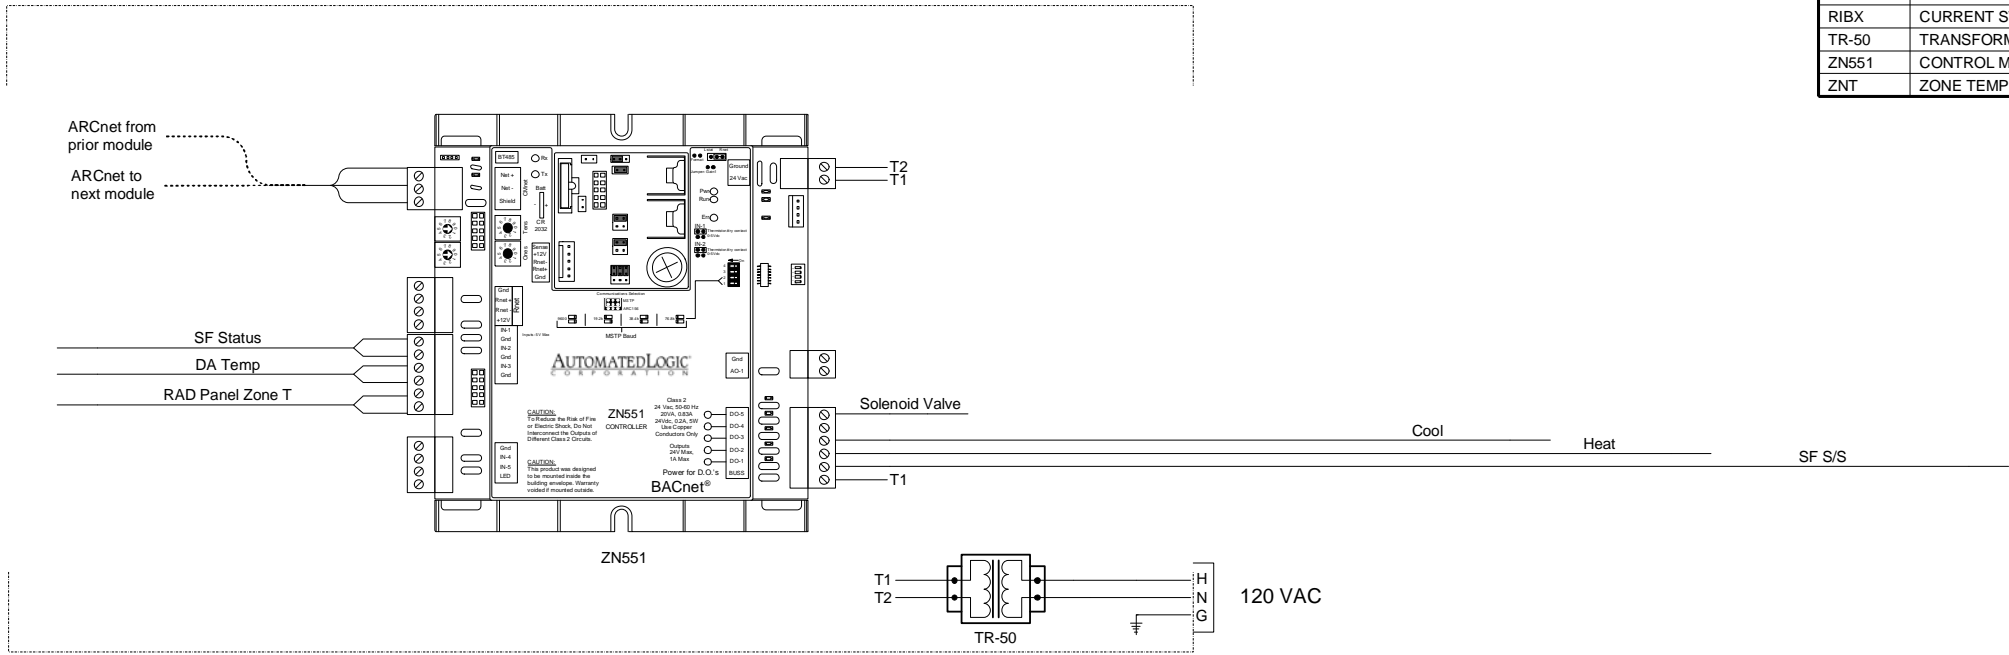

NETWORKED FROM Address 51

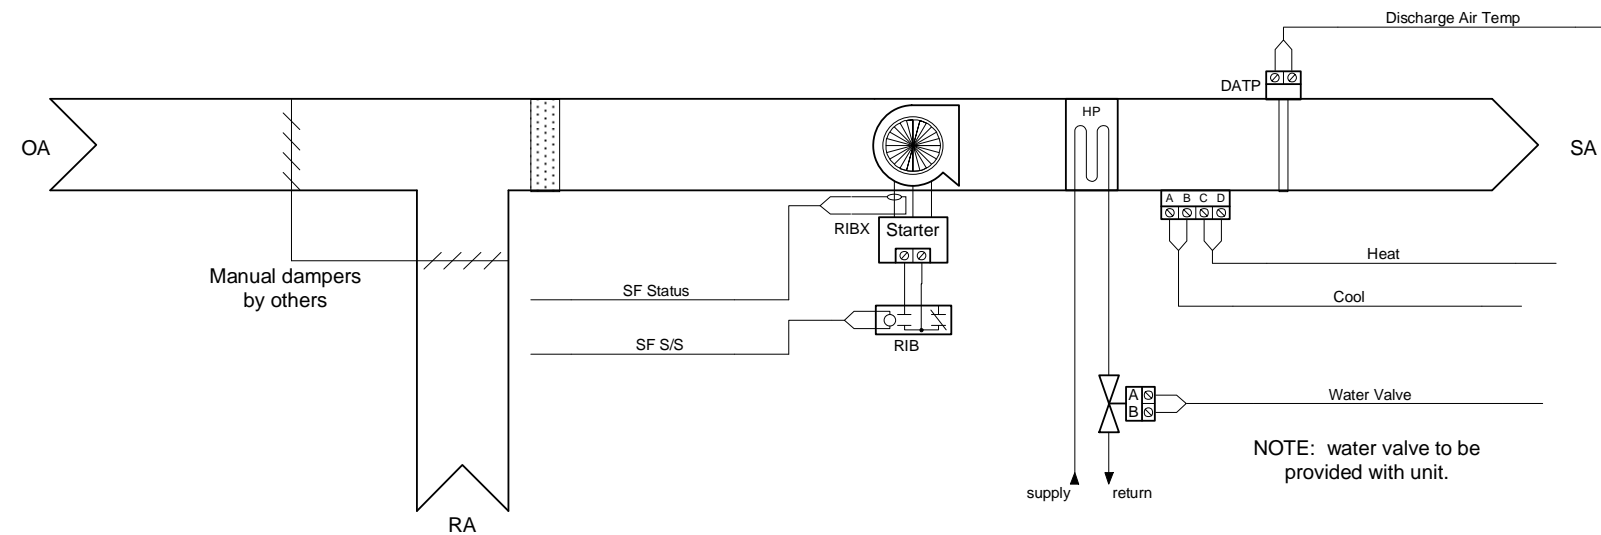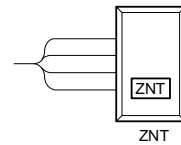

General Notes:

All ARC156 wiring shall be 22AWG single twisted pair, low capacitance (12.5pF/ft), shielded, plenum rated cable. ALC recommends Magnum Cable Corporation Product number A3ARC156.

Each ARC156 segment must be wired in a daisy chain configuration. Branching requires the use of a REP485.

Each ARC156 segment should have one (1) PROT485 installed to provide protection from electrical surges.


Each ARC156 segment end must be terminated with a TERM485 (120 ohm) terminating resistor.

The ARC156 network segment must have at least one (1) DIAG485 installed to supply bias.

Do not strip back shielded cable sheath more than 1" in order to keep twisted pair from separating. Do not ground shield to the panel or chassis ground. The shield should only be connected to the "Optional Shield" connection at a module.


Routing of communications cabling and control module locations shall be field verified.





DCMO BOCES - Phase 1&2 AS BUILT			
Norwich / Masonville, New York			
Air Temp Heating & Air Conditioning, Inc.			
HPNorwich C132.1 Boys Locker			
REV: 1	As-Built	11/19/2007	JOB NO: P7425-7290
			CHECK BY: RSL
			DSCODE:
34 of 69			

HPNorwich C19 Corridor

Bill of Materials				
DID	DESCRIPTION	MANUFACTURER	PART NUMBER	QTY
DATP	DISCHARGE AIR TEMP SENSOR	BAPI	BA/10K-2-RPP-8	102 ea
RIB	RELAY	FUNCTIONAL DEVICES	RIBU1C	102 ea
RIBX	CURRENT SWITCH	FUNCTIONAL DEVICES	RIBXKF	102 ea
TR-50	TRANSFORMER, 120/24VAC, 50VA	FUNCTIONAL DEVICES	TR50VA002	102 ea
ZN551	CONTROL MODULE	AUTOMATED LOGIC	ZN551	102 ea
ZNT	ZONE TEMPERATURE SENSOR	AUTOMATED LOGIC	RS PLUS	102 ea

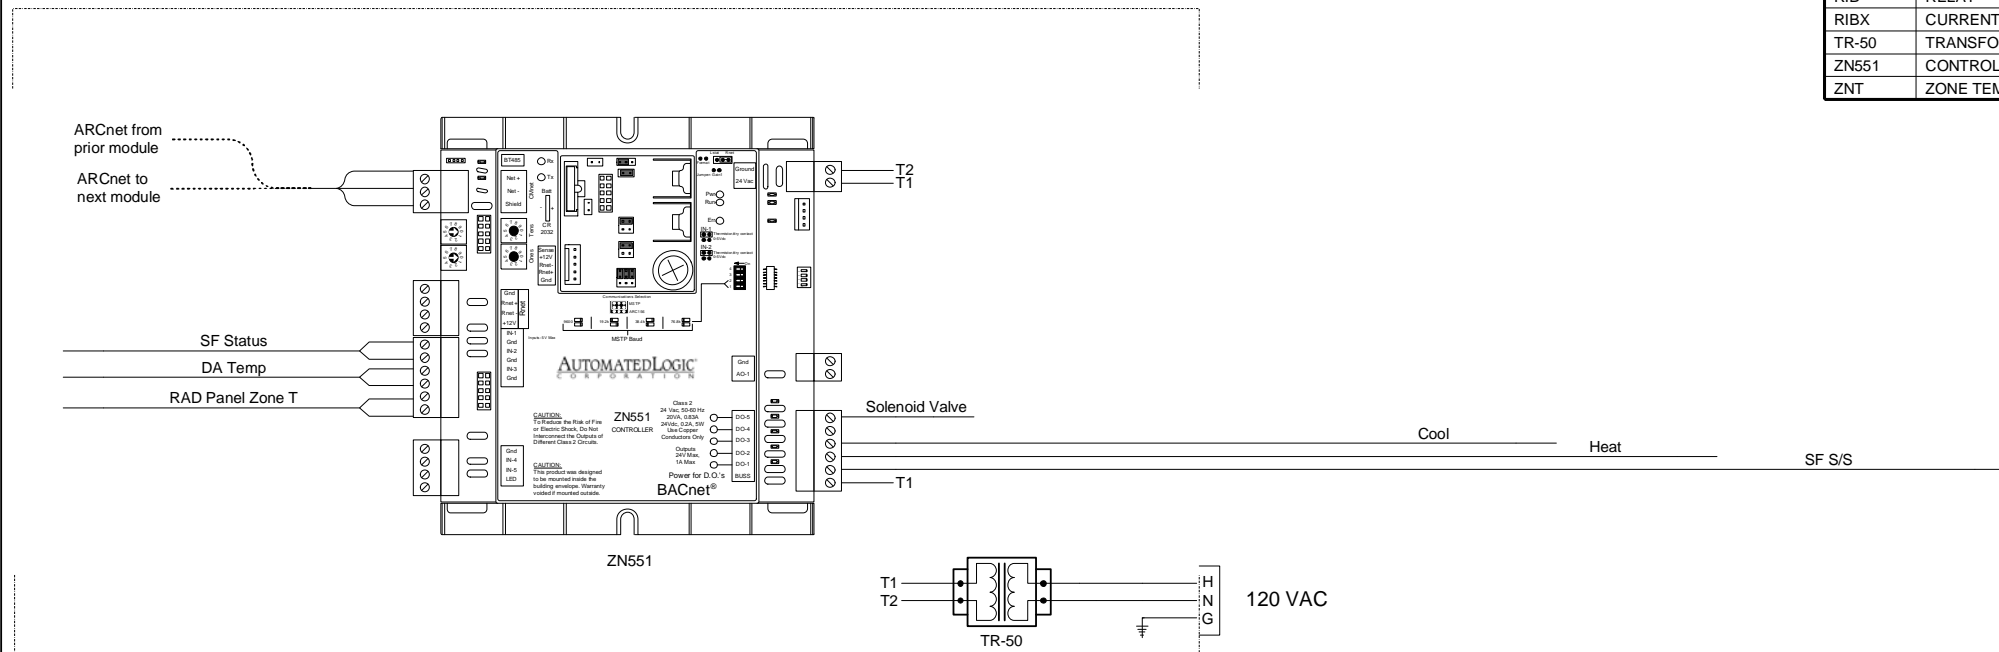

NETWORKED FROM Address 50

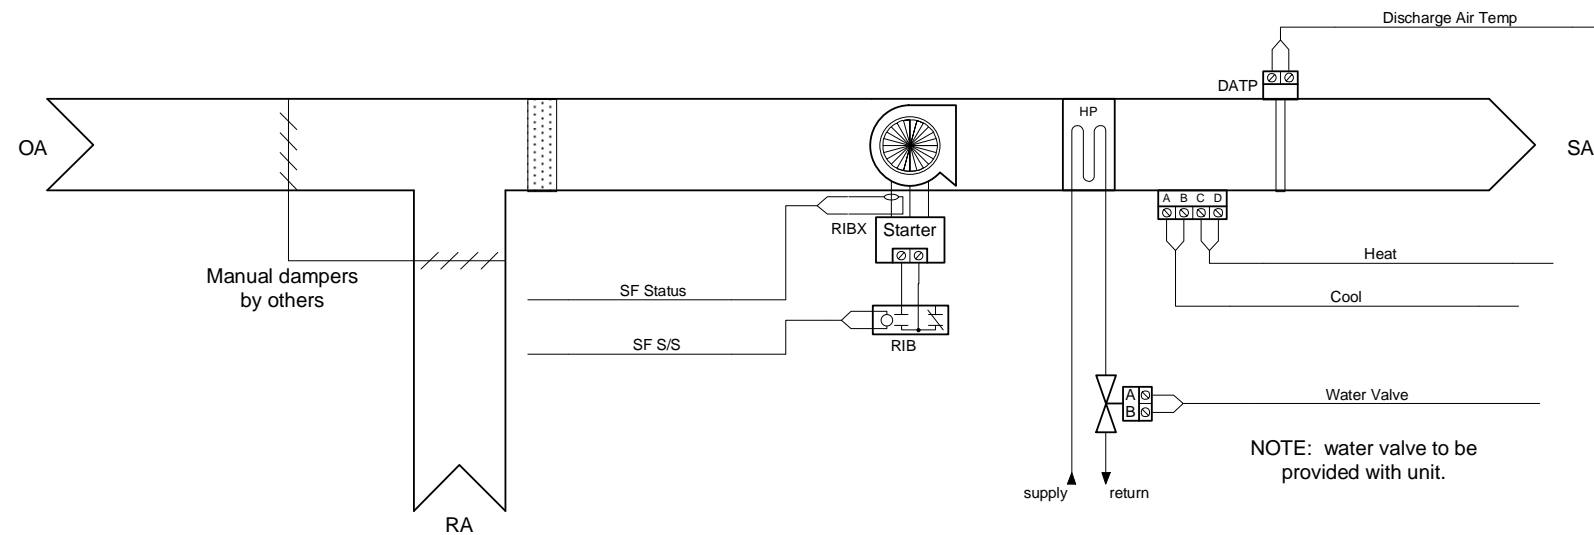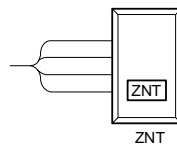

General Notes:

All ARC156 wiring shall be 22AWG single twisted pair, low capacitance (12.5pF/ft), shielded, plenum rated cable. ALC recommends Magnum Cable Corporation Product number A3ARC156.

Each ARC156 segment must be wired in a daisy chain configuration. Branching requires the use of a REP485.

Each ARC156 segment should have one (1) PROT485 installed to provide protection from electrical surges.


Each ARC156 segment end must be terminated with a TERM485 (120 ohm) terminating resistor.

The ARC156 network segment must have at least one (1) DIAG485 installed to supply bias.

Do not strip back shielded cable sheath more than 1" in order to keep twisted pair from separating. Do not ground shield to the panel or chassis ground. The shield should only be connected to the "Optional Shield" connection at a module.



Routing of communications cabling and control module locations shall be field verified.



DCMO BOCES - Phase 1&2 AS BUILT			
Norwich / Masonville, New York			
Air Temp Heating & Air Conditioning, Inc.			
HPNorwich C19 Corridor			
REV: 1	As-Built	11/19/2007	JOB NO: P7425-7290
			CHECK BY: RSL
			DSCODE:
35 of 69			

HPNorwich CG07 Bathroom

Bill of Materials				
DID	DESCRIPTION	MANUFACTURER	PART NUMBER	QTY
DATP	DISCHARGE AIR TEMP SENSOR	BAPI	BA/10K-2-RPP-8	102 ea
RIB	RELAY	FUNCTIONAL DEVICES	RIBU1C	102 ea
RIBX	CURRENT SWITCH	FUNCTIONAL DEVICES	RIBXKF	102 ea
TR-50	TRANSFORMER, 120/24VAC, 50VA	FUNCTIONAL DEVICES	TR50VA002	102 ea
ZN551	CONTROL MODULE	AUTOMATED LOGIC	ZN551	102 ea
ZNT	ZONE TEMPERATURE SENSOR	AUTOMATED LOGIC	RS PLUS	102 ea

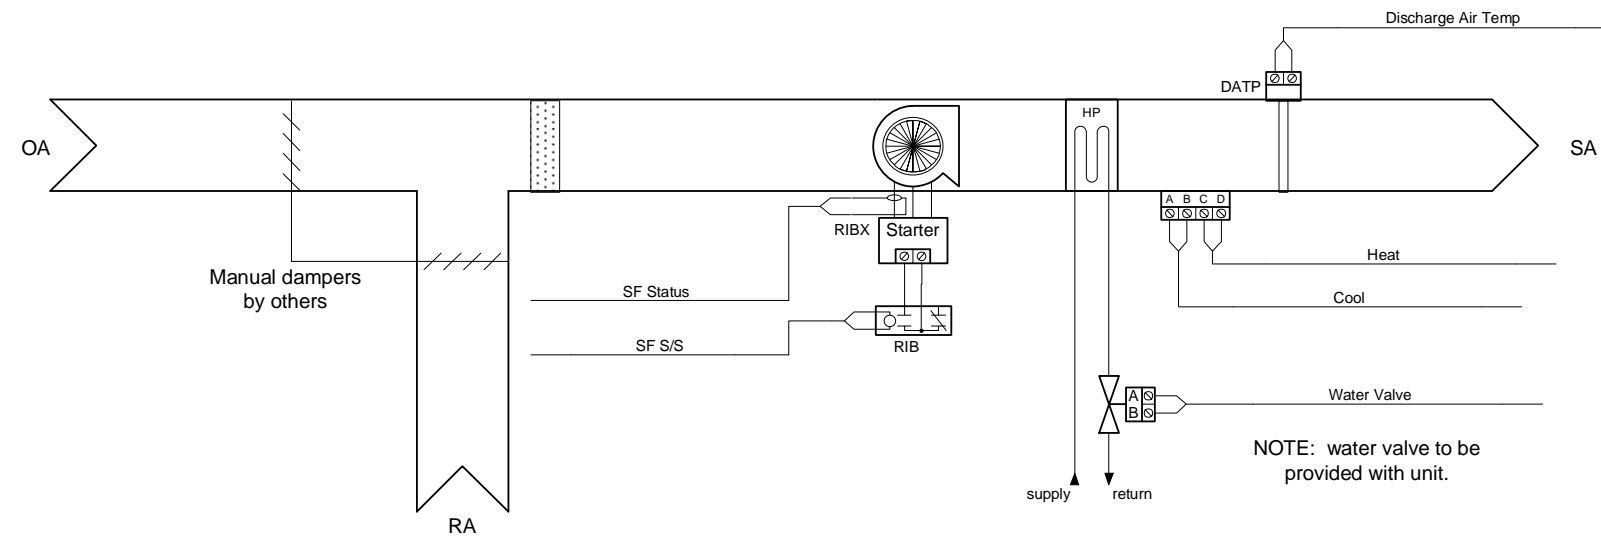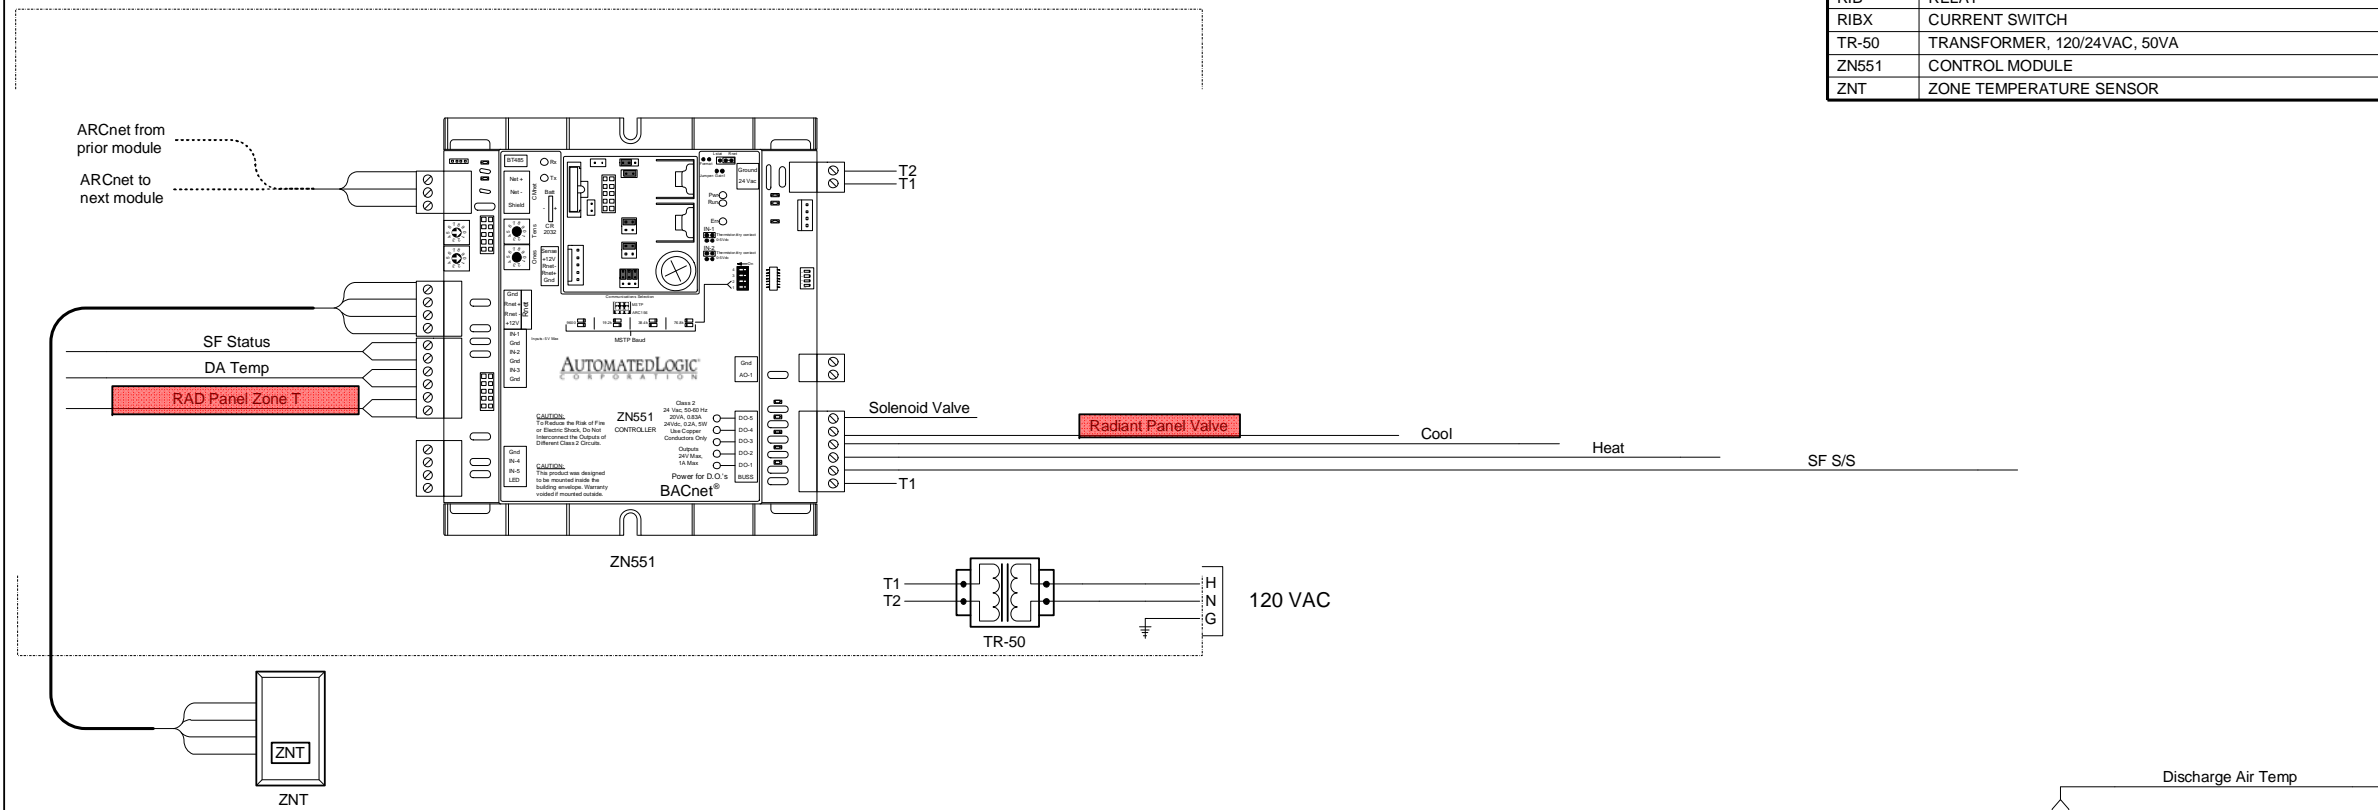

General Notes:

All ARC156 wiring shall be 22AWG single twisted pair, low capacitance (12.5pF/ft), shielded, plenum rated cable. ALC recommends Magnum Cable Corporation Product number A3ARC156.

Each ARC156 segment must be wired in a daisy chain configuration. Branching requires the use of a REP485.

Each ARC156 segment should have one (1) PROT485 installed to provide protection from electrical surges.


Each ARC156 segment end must be terminated with a TERM485 (120 ohm) terminating resistor.

The ARC156 network segment must have at least one (1) DIAG485 installed to supply bias.

Do not strip back shielded cable sheath more than 1" in order to keep twisted pair from separating. Do not ground shield to the panel or chassis ground. The shield should only be connected to the "Optional Shield" connection at a module.


Routing of communications cabling and control module locations shall be field verified.



DCMO BOCES - Phase 1&2 AS BUILT			
Norwich / Masonville, New York			
Air Temp Heating & Air Conditioning, Inc.			
HPNorwich CG07 Bathroom			
REV: 1	As-Built	11/19/2007	JOB NO: P7425-7290
CHECK BY: RSL			DSCODE:
			36 of 69

HPNorwich CG05 Bathroom

Bill of Materials				
DID	DESCRIPTION	MANUFACTURER	PART NUMBER	QTY
DATP	DISCHARGE AIR TEMP SENSOR	BAPI	BA/10K-2-RPP-8	102 ea
RIB	RELAY	FUNCTIONAL DEVICES	RIBU1C	102 ea
RIBX	CURRENT SWITCH	FUNCTIONAL DEVICES	RIBXKF	102 ea
TR-50	TRANSFORMER, 120/24VAC, 50VA	FUNCTIONAL DEVICES	TR50VA002	102 ea
ZN551	CONTROL MODULE	AUTOMATED LOGIC	ZN551	102 ea
ZNT	ZONE TEMPERATURE SENSOR	AUTOMATED LOGIC	RS PLUS	102 ea

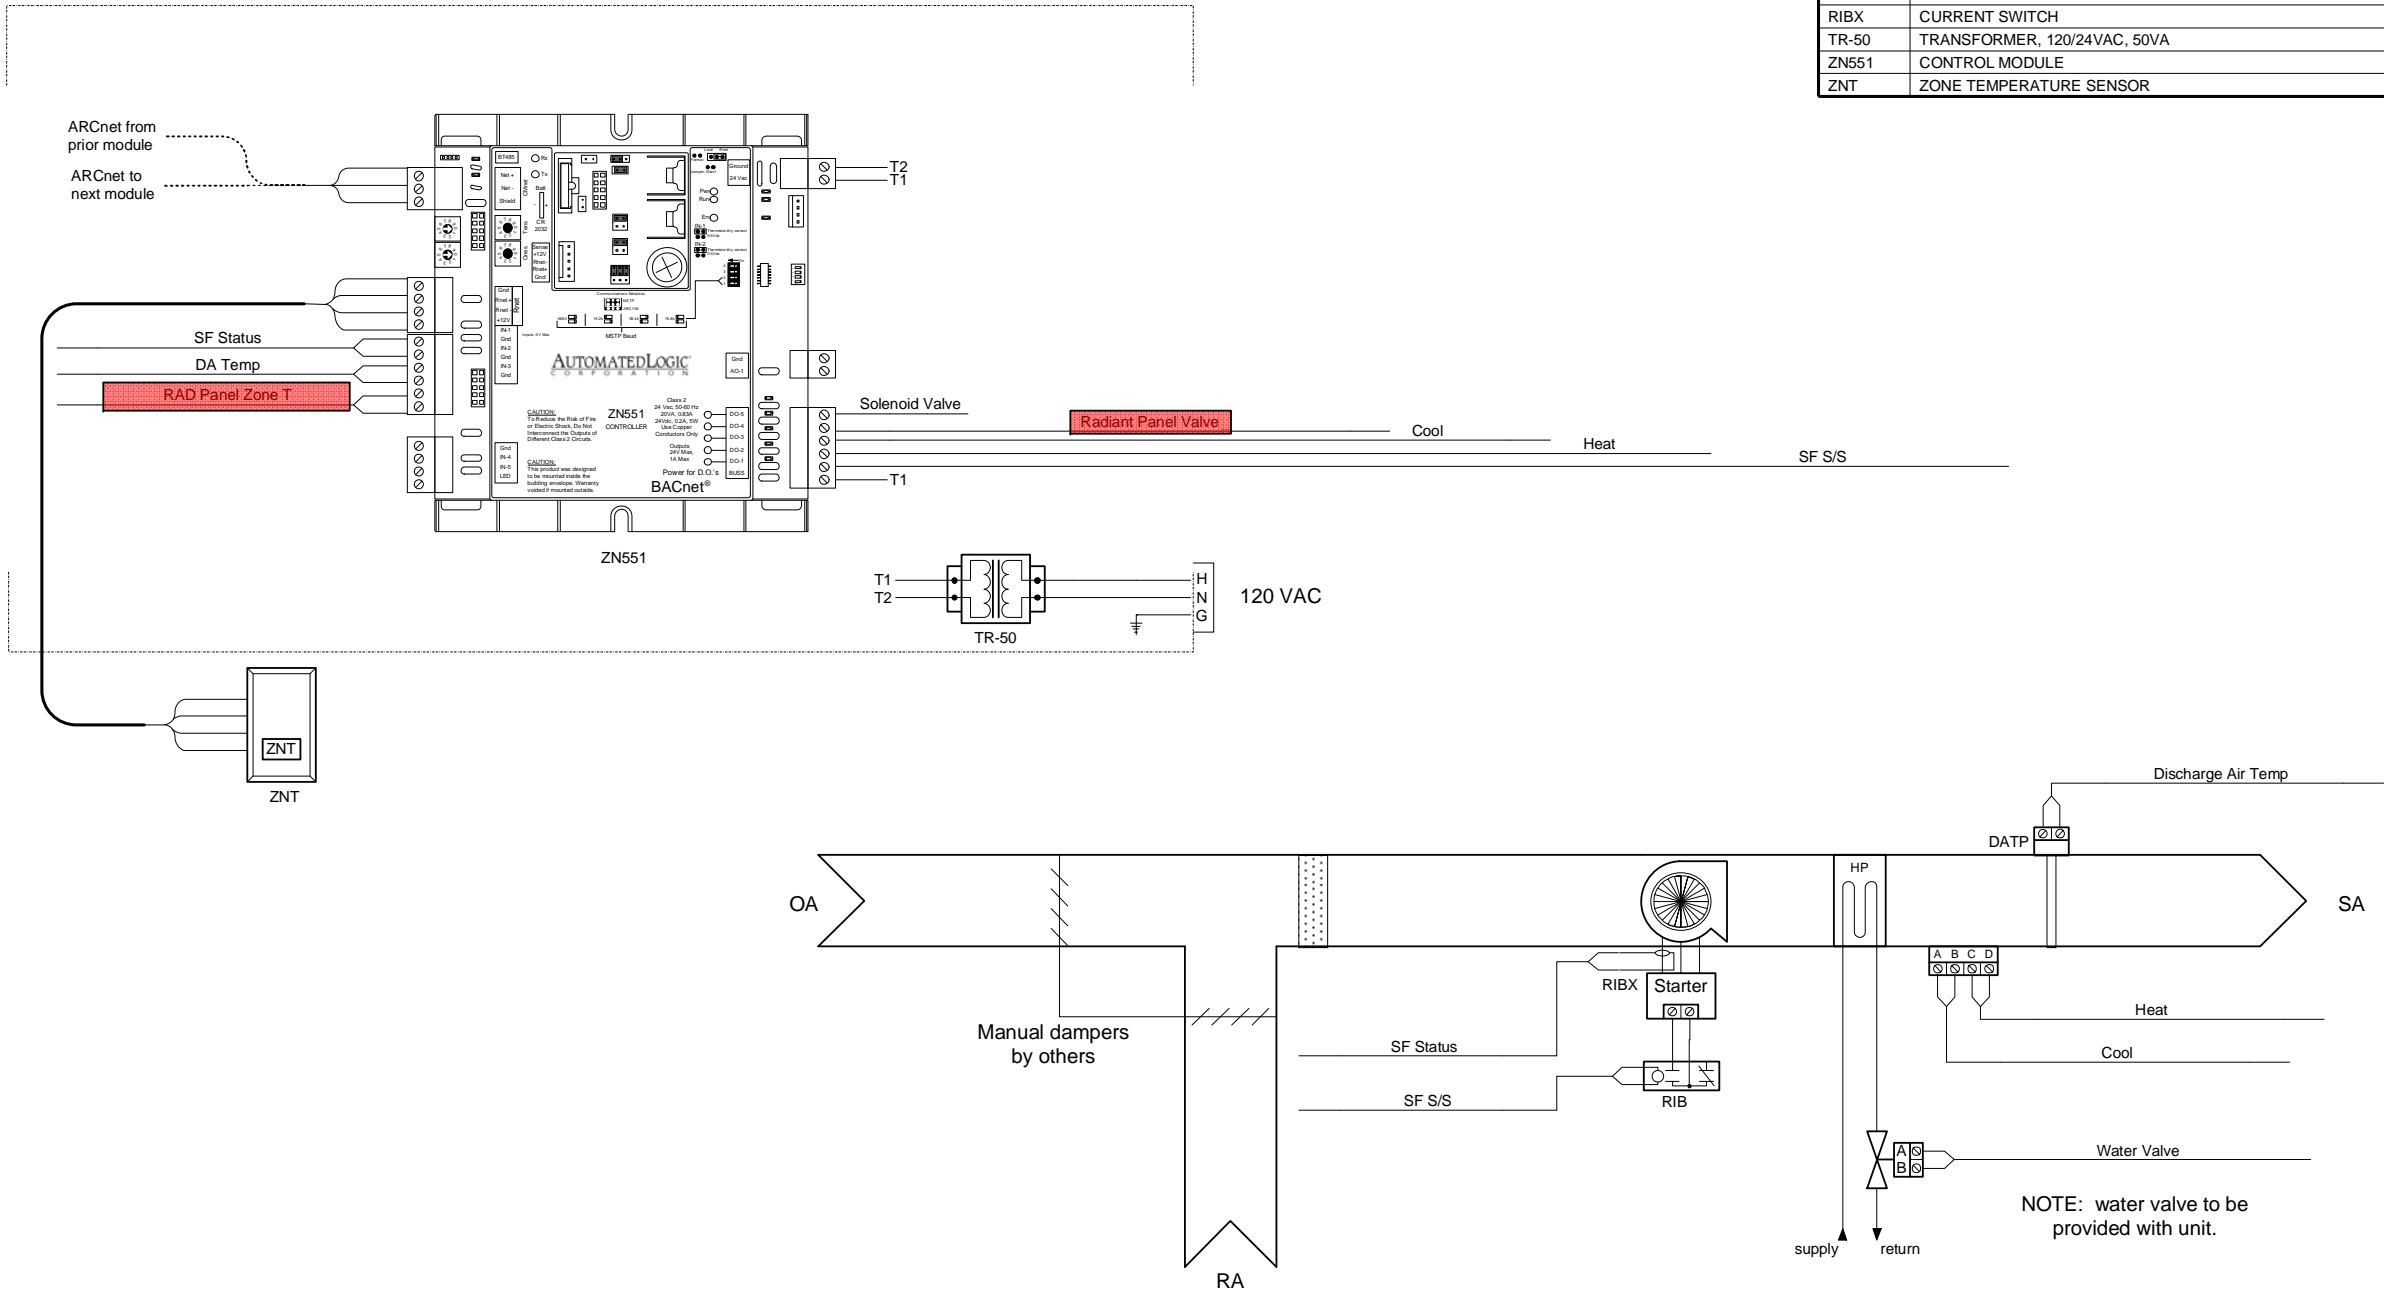

General Notes:
 All ARC156 wiring shall be 22AWG single twisted pair, low capacitance (12.5pF/ft), shielded, plenum rated cable. ALC recommends Magnum Cable Corporation Product number A3ARC156.

Each ARC156 segment must be wired in a daisy chain configuration. Branching requires the use of a REP485.

Each ARC156 segment should have one (1) PROT485 installed to provide protection from electrical surges.


Each ARC156 segment end must be terminated with a TERM485 (120 ohm) terminating resistor.

The ARC156 network segment must have at least one (1) DIAG485 installed to supply bias.

Do not strip back shielded cable sheath more than 1" in order to keep twisted pair from separating. Do not ground shield to the panel or chassis ground. The shield should only be connected to the "Optional Shield" connection at a module.


Routing of communications cabling and control module locations shall be field verified.



DCMO BOCES - Phase 1&2 AS BUILT			
Norwich / Masonville, New York			
Air Temp Heating & Air Conditioning, Inc.			
HPNorwich CG05 Bathroom			
REV: 1	As-Built	11/19/2007	JOB NO: P7425-7290
			CHECK BY: RSL
			DSCODE:
37 of 69			

HPNorwich C163 Bathrooms

Bill of Materials				
DID	DESCRIPTION	MANUFACTURER	PART NUMBER	QTY
DATP	DISCHARGE AIR TEMP SENSOR	BAPI	BA/10K-2-RPP-8	102 ea
RIB	RELAY	FUNCTIONAL DEVICES	RIBU1C	102 ea
RIBX	CURRENT SWITCH	FUNCTIONAL DEVICES	RIBXKF	102 ea
TR-50	TRANSFORMER, 120/24VAC, 50VA	FUNCTIONAL DEVICES	TR50VA002	102 ea
ZN551	CONTROL MODULE	AUTOMATED LOGIC	ZN551	102 ea
ZNT	ZONE TEMPERATURE SENSOR	AUTOMATED LOGIC	RS PLUS	102 ea

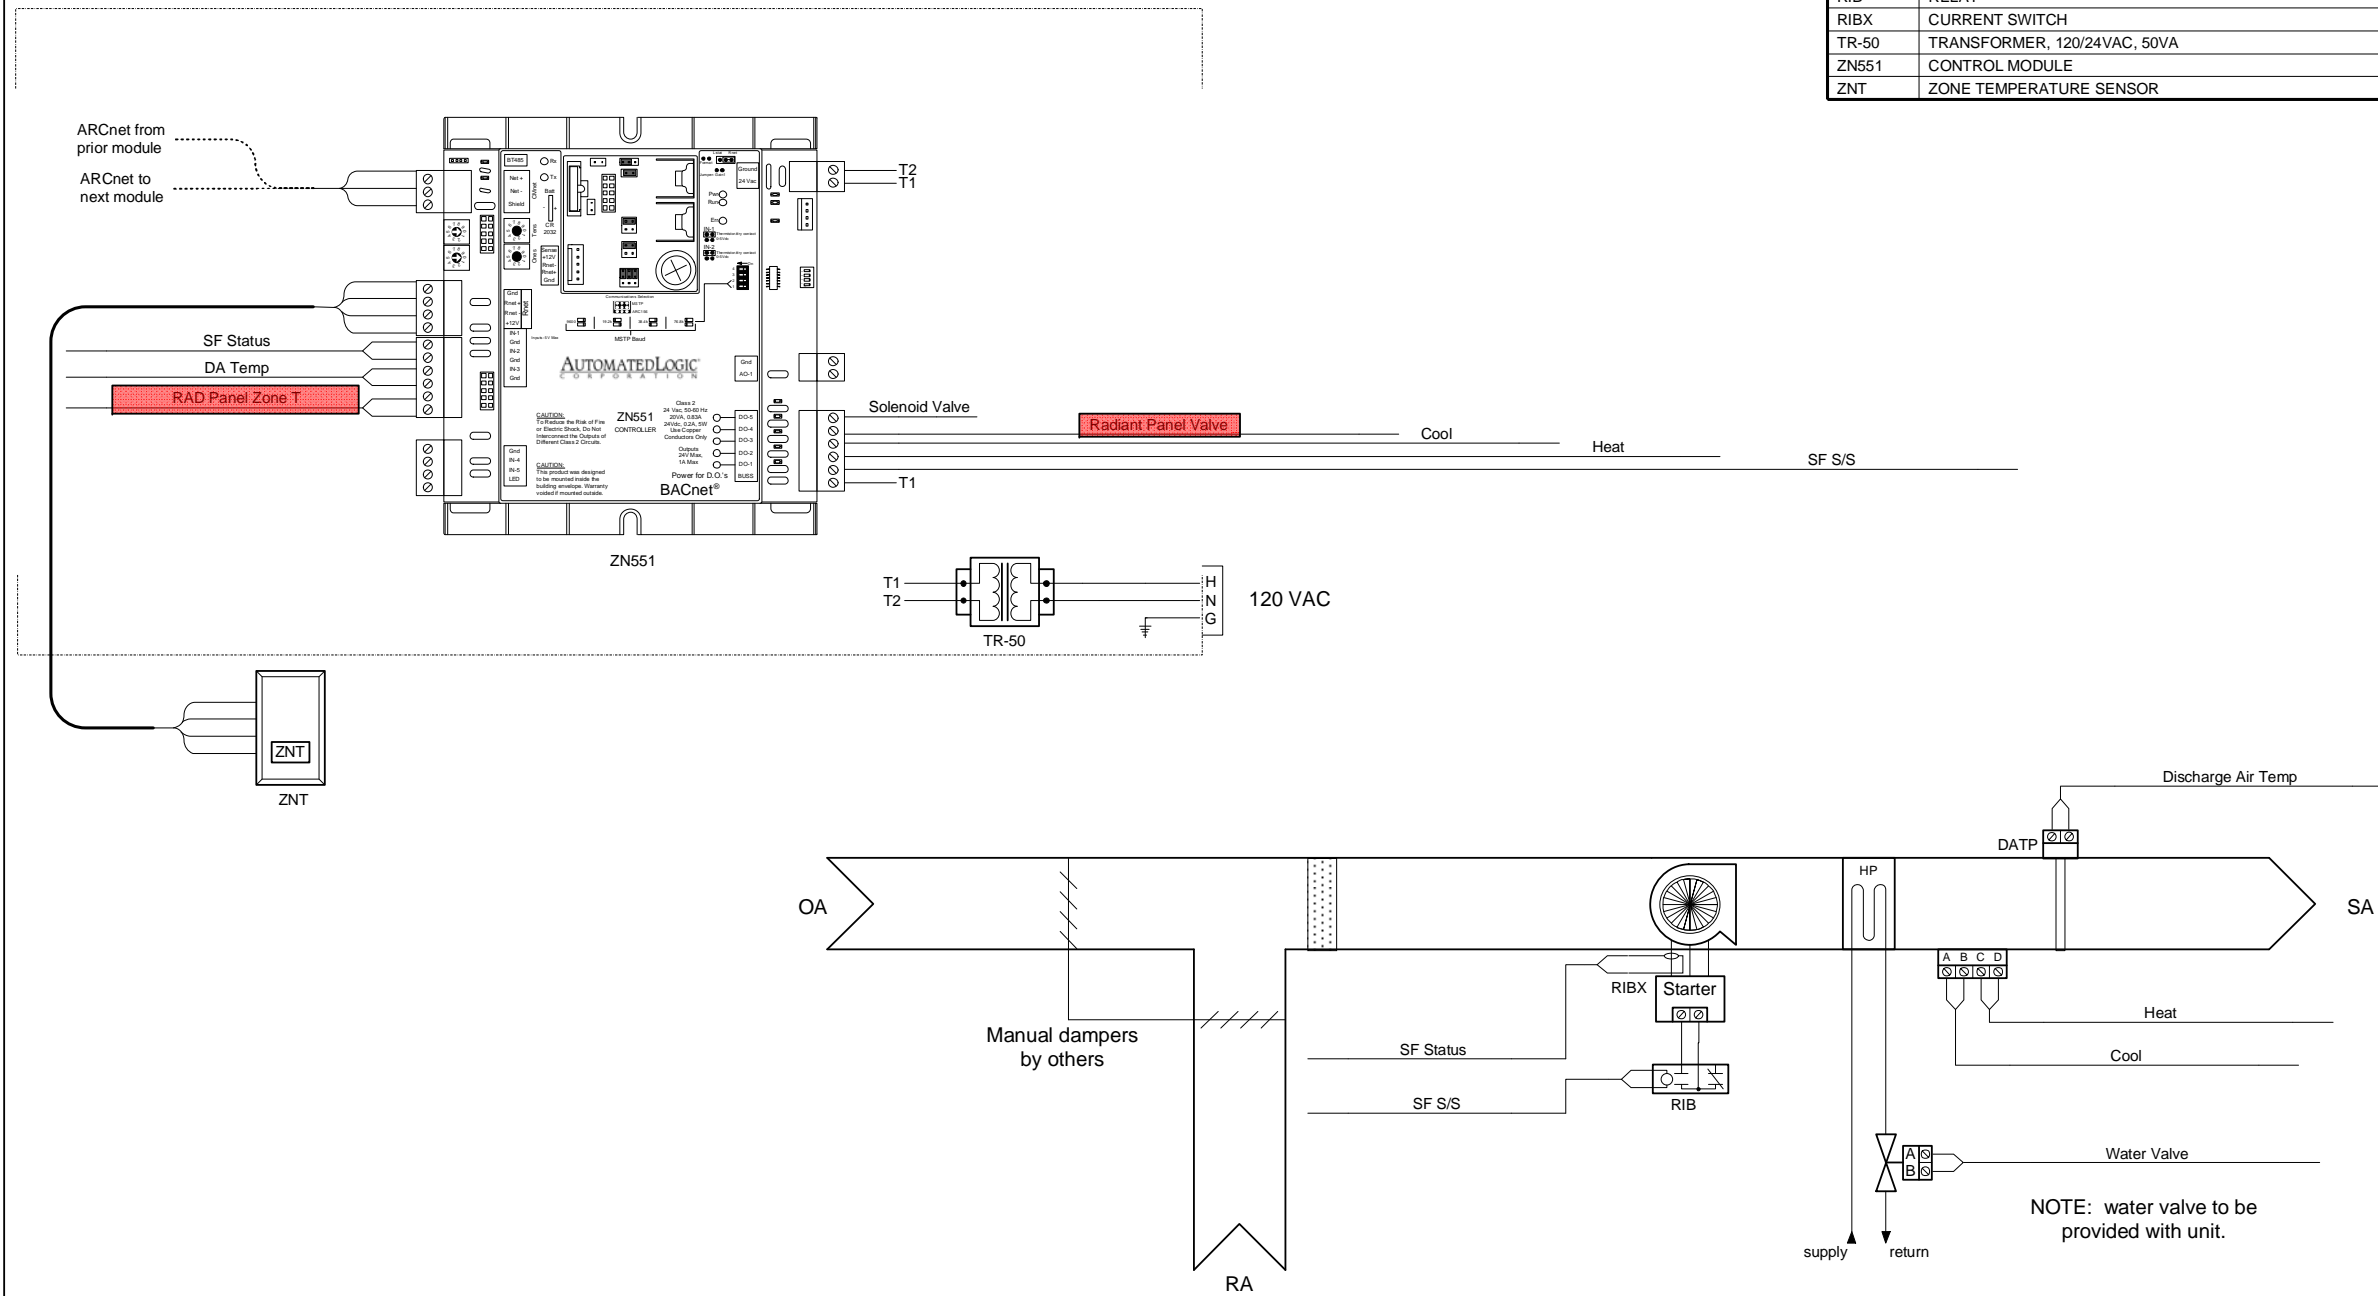

General Notes:

All ARC156 wiring shall be 22AWG single twisted pair, low capacitance (12.5pF/ft), shielded, plenum rated cable. ALC recommends Magnum Cable Corporation Product number A3ARC156.

Each ARC156 segment must be wired in a daisy chain configuration. Branching requires the use of a REP485.

Each ARC156 segment should have one (1) PROT485 installed to provide protection from electrical surges.

Each ARC156 segment end must be terminated with a TERM485 (120 ohm) terminating resistor.

The ARC156 network segment must have at least one (1) DIAG485 installed to supply bias.

Do not strip back shielded cable sheath more than 1" in order to keep twisted pair from separating. Do not ground shield to the panel or chassis ground. The shield should only be connected to the "Optional Shield" connection at a module.


Routing of communications cabling and control module locations shall be field verified.

DCMO BOCES - Phase 1&2 AS BUILT			
Norwich / Masonville, New York			
Air Temp Heating & Air Conditioning, Inc.			
HPNorwich C163 Bathrooms			
REV: 1	As-Built	11/19/2007	JOB NO: P7425-7290
			CHECK BY: RSL
			DSCODE:
			38 of 69



AIR TEMP HEATING & AIR CONDITIONING, INC.
A LINC SERVICE CONTRACTOR

EF'S NORWICH

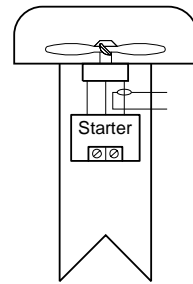


CS-E

REL-F

- EF 24 C Bathrooms 146, 147 Controlled From Device 2-42
- EF 145 C Bathrooms 144, 145 Controlled From Device 3-88
- EF 151 Bathrooms 151 Controlled From Device 3-88
- EF 30 C Prep Room 169.1 Controlled From Device 2-39
- EF 26 Girls Bathroom E Wing Controlled From Device 2-59
- EF 25 Boys Bathroom E Wing Controlled From Device 3-88
- EF 28 Area D Locker Rooms Controlled From Device 1-59

NORWICH


Bill of Materials				
DID	DESCRIPTION	MANUFACTURER	PART NUMBER	QTY
CS-E	CURRENT SWITCH .5-200 AMP SOLID CORE GO/NO GO	VERUS IND.	H-800	1 ea
REL-F	RIB PILOT RELAY SPDT 10AMP	KELE & ASSOC.	RIBU1C	1 ea

DCMO BOCES - Phase 1&2 AS BUILT			
Norwich / Masonville, New York			
Air Temp Heating & Air Conditioning, Inc.			
EF'S NORWICH			
REV: 1	As-Built	11/19/2007	JOB NO: P7425-7290
 AIR TEMP HEATING & AIR CONDITIONING, INC. <small>A LINC SERVICE © CONTRACTOR</small>			CHECK BY: RSL
			DSCODE:
			39 of 69

Convector


Bill of Materials

DID	DESCRIPTION	MANUFACTURER	PART NUMBER	QTY
RTS-AC	10K ROOM THERMISTOR SS WALL PLATE	BAPI	BA/10K-2-93-631	1 ea
TR-AG	TRANSFORMER, 120/24VAC 150VA W/CCT BREAKER	CORE COMPONENTS	LE-124	1 ea
ZN220	ZN220	AUTOMATED LOGIC	ZN220	1 ea

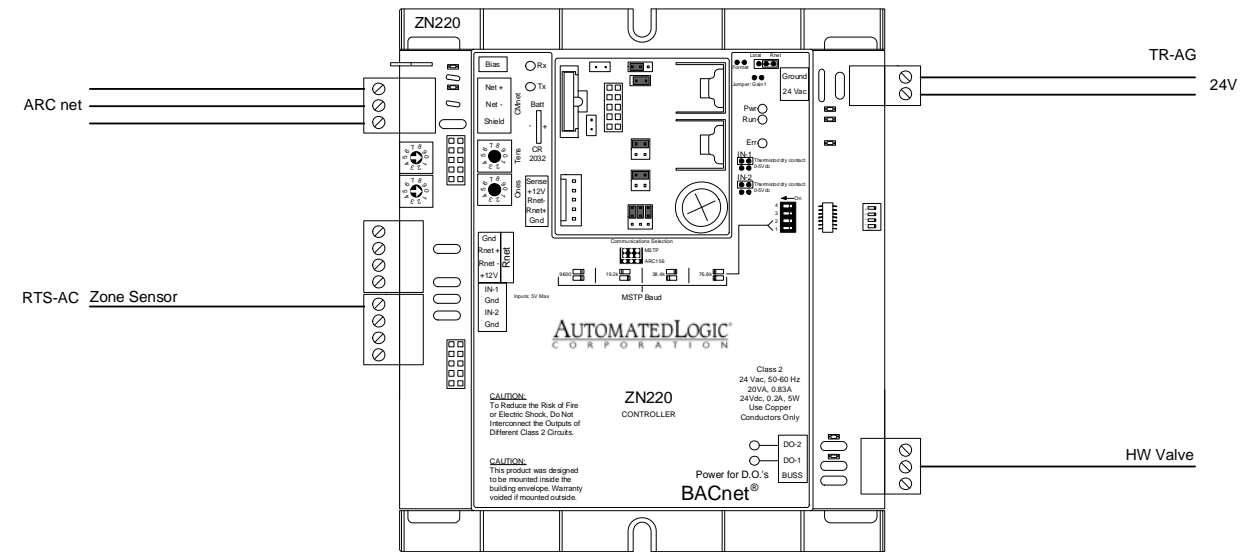


Radiant C107.5

Network 3 Address 86

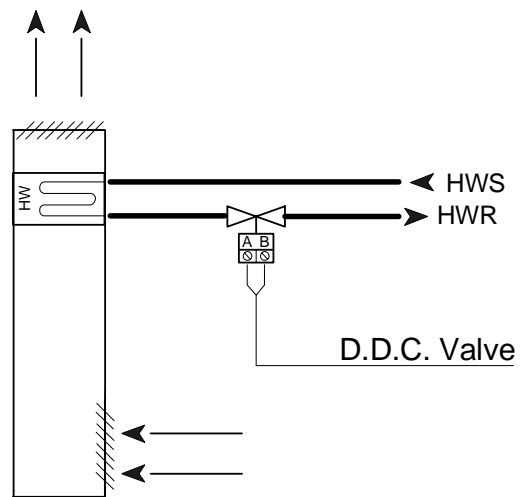

CONVECTOR HEATER

NORWICH


DCMO BOCES - Phase 1&2 AS BUILT			
Norwich / Masonville, New York			
Air Temp Heating & Air Conditioning, Inc.			
Convector			
REV: 1	As-Built	11/19/2007	JOB NO: P7425-7290
			CHECK BY: RSL
			DSCODE:
40 of 69			

Boiler Wiring 01- HC

Harrold Campus Typical For 2 Boiler Rooms

Bill of Materials

DID	DESCRIPTION	MANUFACTURER	PART NUMBER	QTY
M8102	CONTROL MODULE	AUTOMATED LOGIC	M8102	2 ea
MX880	CONTROL MODULE	AUTOMATED LOGIC	MX880	2 ea
TR-50	TRANSFORMER, 120/24VAC, 50VA	FUNCTIONAL DEVICES	TR50VA002	6 ea

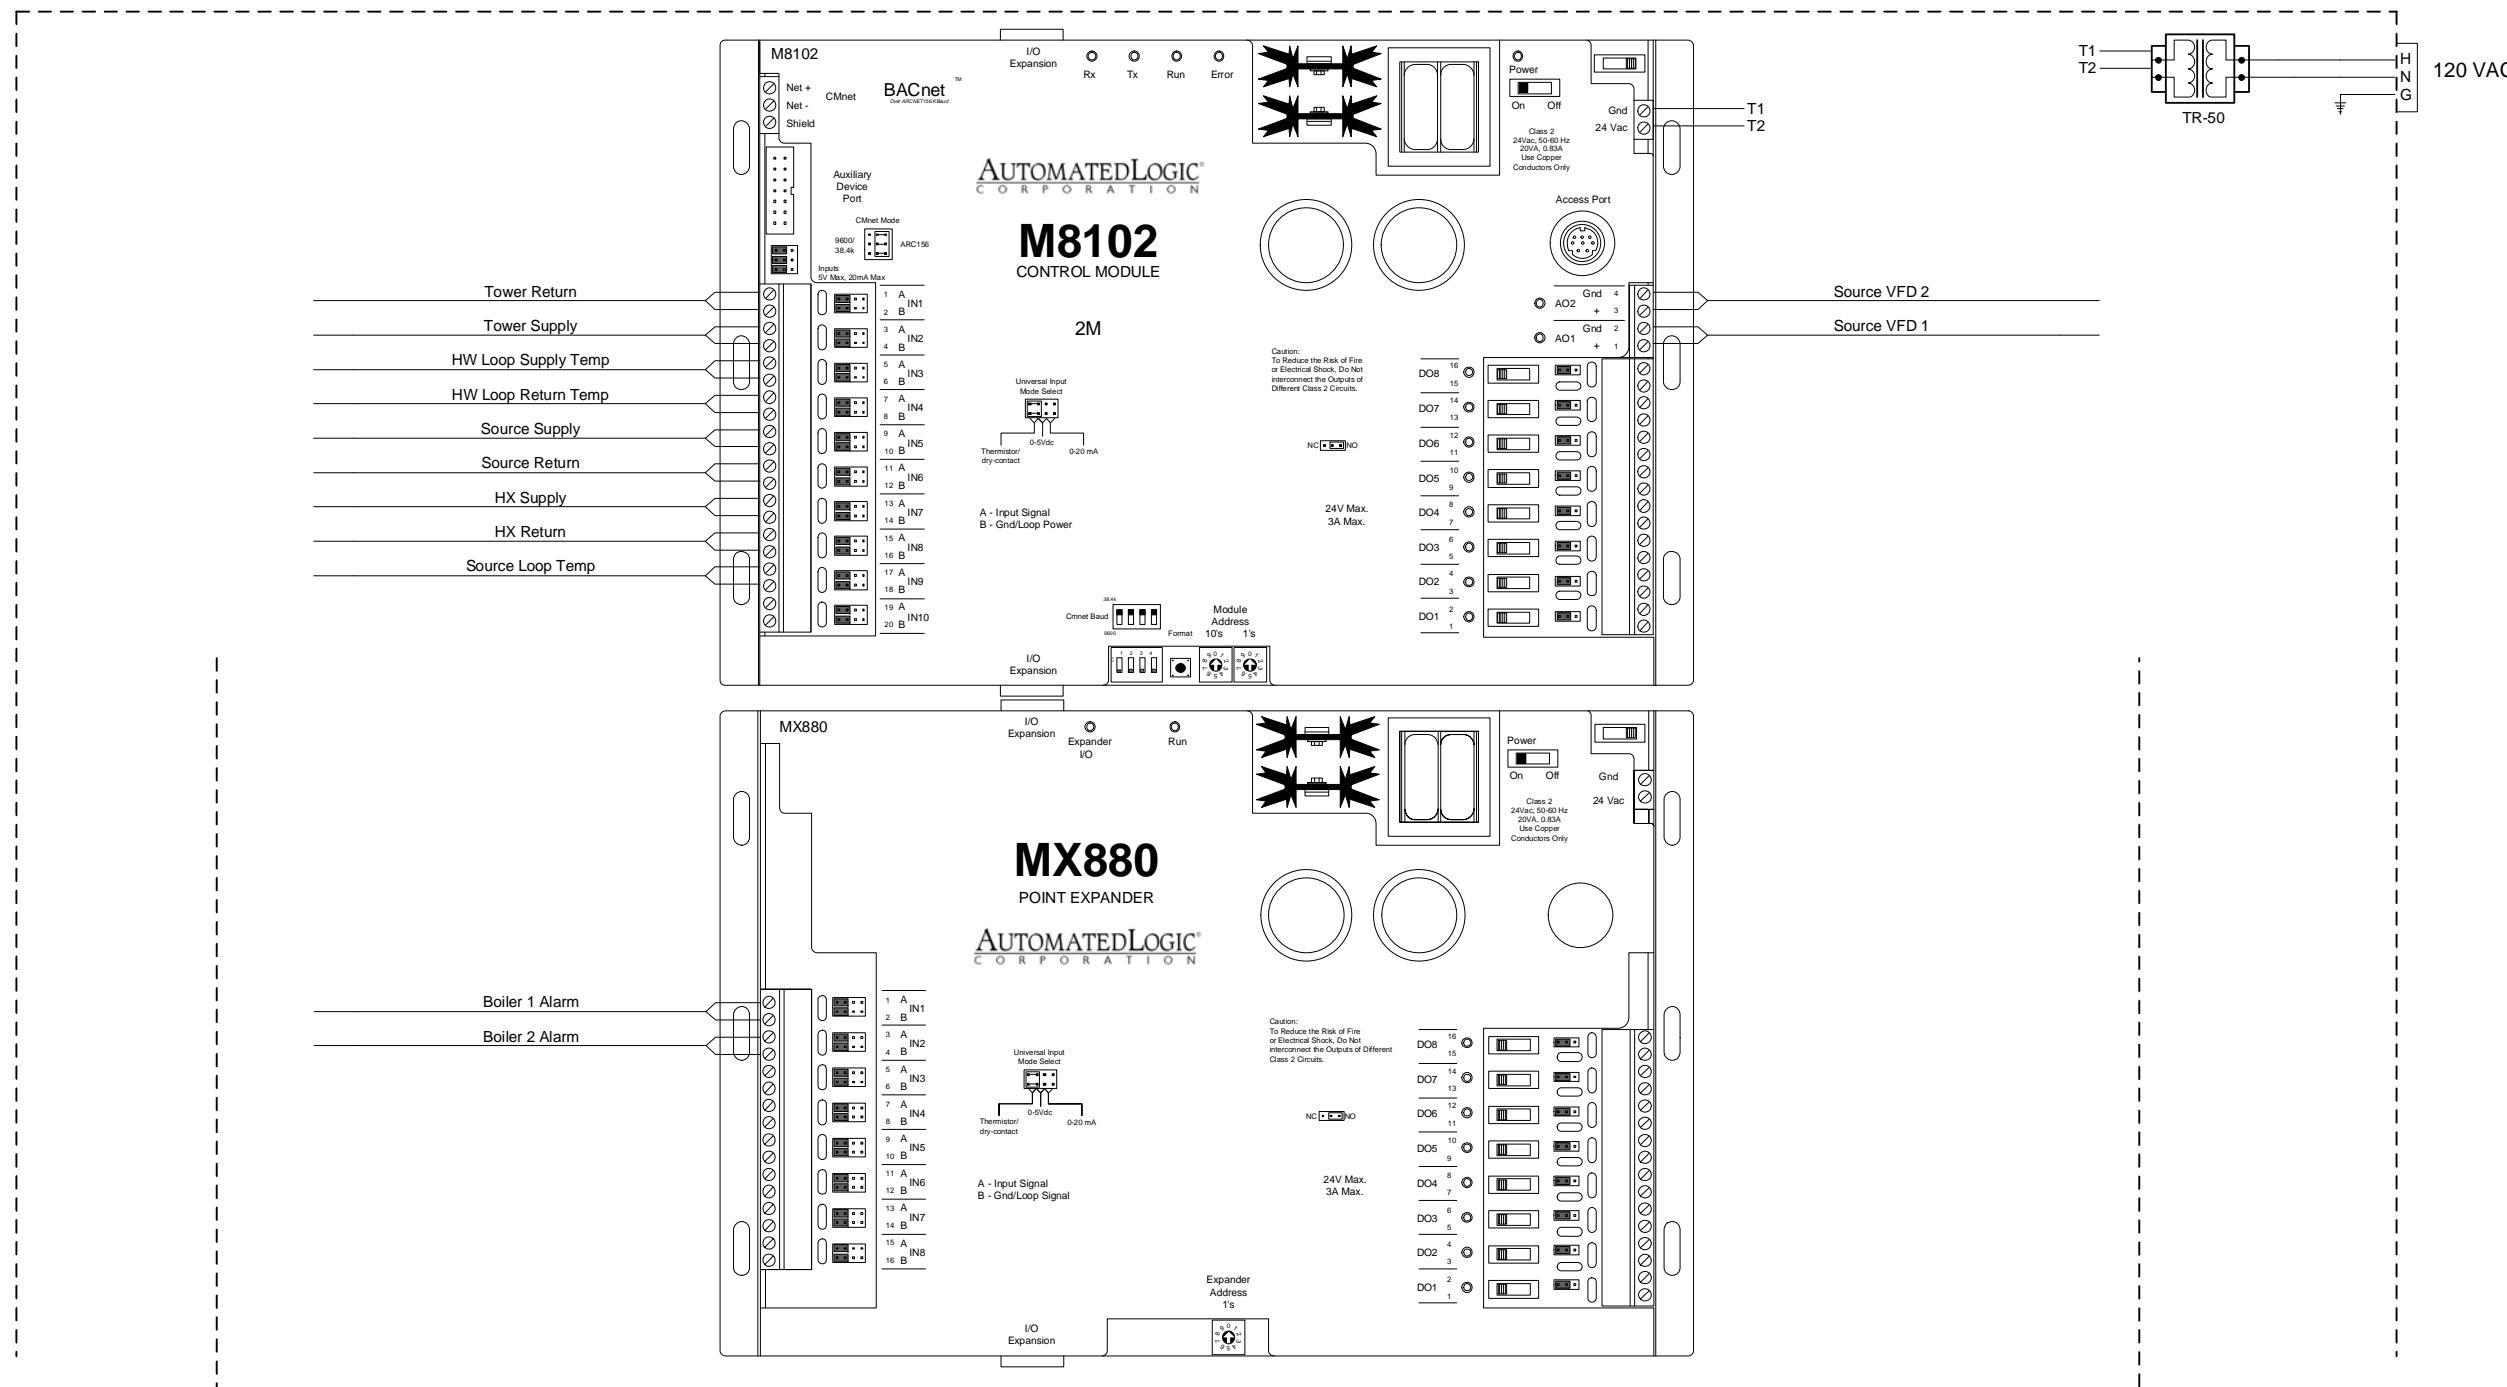

MASONVILLE WITH EXPANDER 1

CONTINUED NEXT PAGE

DCMO BOCES - Phase 1&2 AS BUILT

Norwich / Masonville, New York

Air Temp Heating & Air Conditioning, Inc.

Boiler Wiring 01- HC

REV: 1	As-Built	11/19/2007	JOB NO: P7425-7290
--------	----------	------------	--------------------

CHECK BY: RSL

DSCODE:

AIR TEMP HEATING & AIR CONDITIONING, INC.
A LINC SERVICE CONTRACTOR


Boiler Wiring 02 - HC

Bill of Materials

DID	DESCRIPTION	MANUFACTURER	PART NUMBER	QTY
IS	SENSOR	BAPI	BA10K214	12 ea
MX16160	MX16160	AUTOMATED LOGIC	MX16160	1 ea
RIB	RELAY	FUNCTIONAL DEVICES	RIBU1C	10 ea
RIBXKF	CT	FUNCTIONAL DEVICES	RIBXKF	12 ea

Harrold Campus
A BOILER

Panel continued from previous page

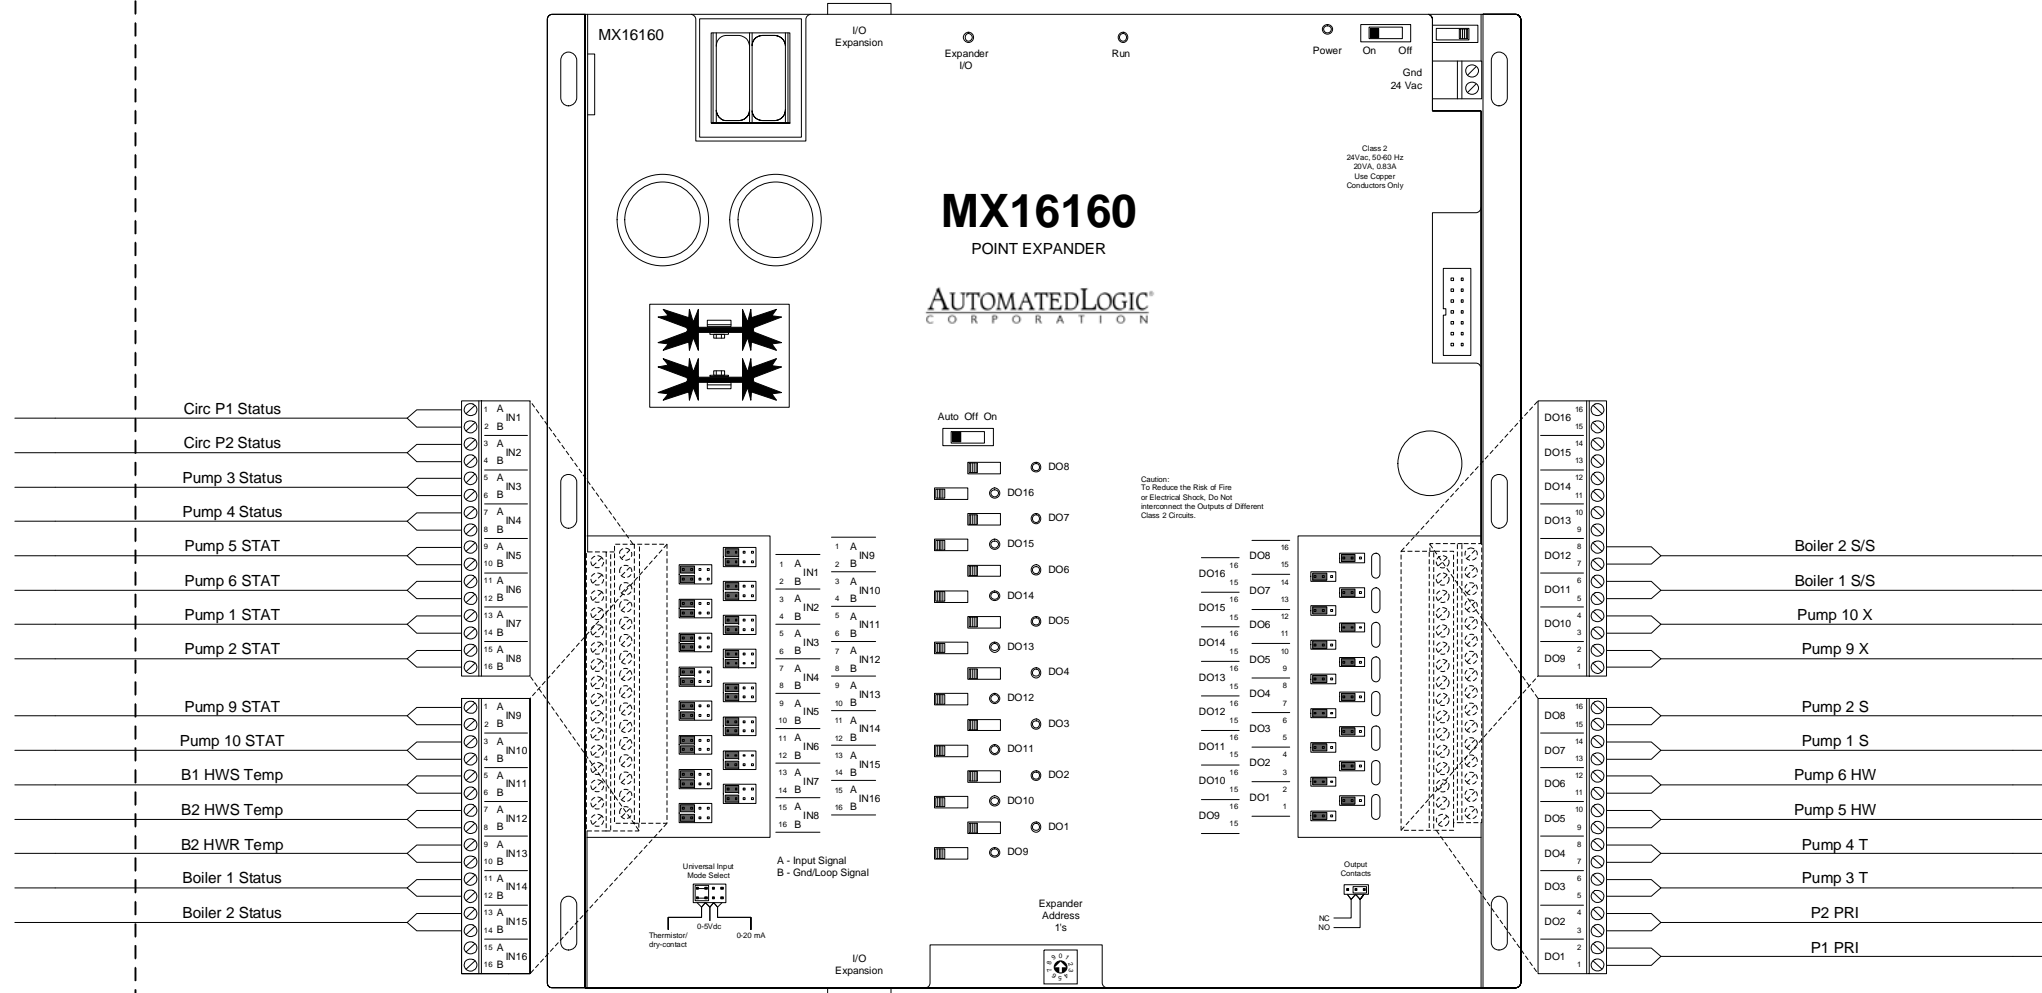

IS RIB
RIBXKF

MASONVILLE WITH EXPANDER 2

DCMO BOCES - Phase 1&2 AS BUILT

Norwich / Masonville, New York

Air Temp Heating & Air Conditioning, Inc.

Boiler Wiring 02 - HC

REV: 1	As-Built	11/19/2007	JOB NO: P7425-7290
--------	----------	------------	--------------------

CHECK BY: RSL

DSCODE:


42 of 69



Boiler Wiring 03 - HC

Bill of Materials

DID	DESCRIPTION	MANUFACTURER	PART NUMBER	QTY
TR	TRANSFORMER	FUNTIONAL DEVICES	TR50VA	3 ea
ZN253	ZN253	AUTOMATED LOGIC	ZN253	1 ea

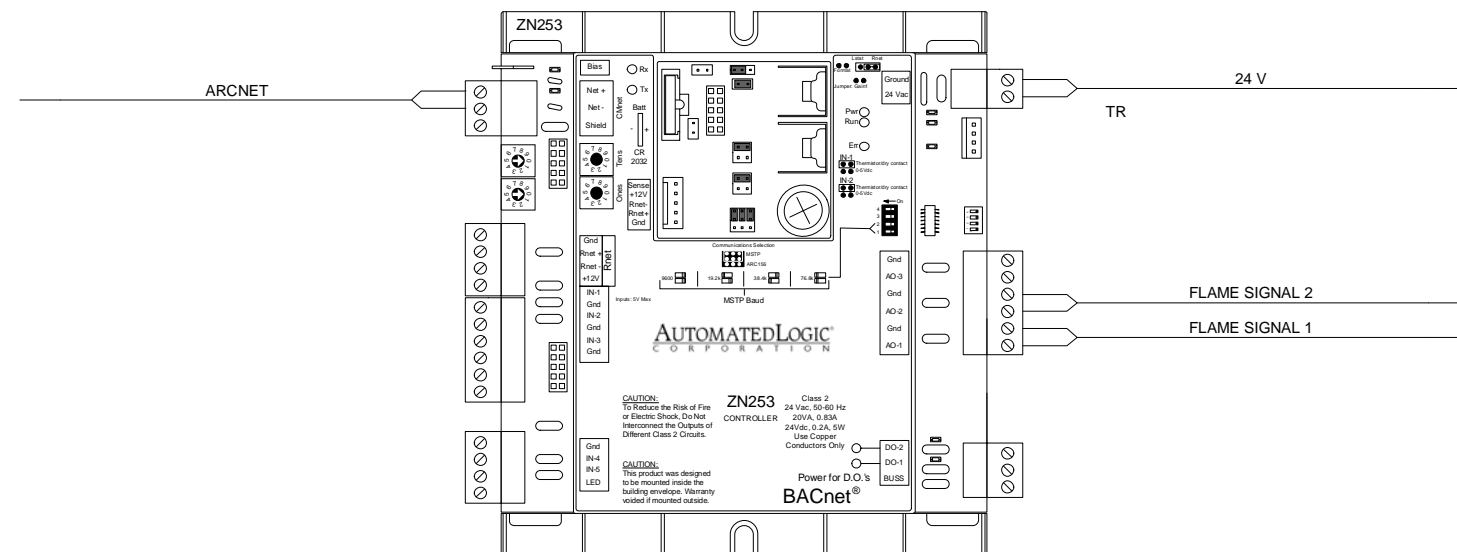

DCMO BOCES - Phase 1&2 AS BUILT

Norwich / Masonville, New York

Air Temp Heating & Air Conditioning, Inc.

Boiler Wiring 03 - HC

REV: 1	As-Built	11/19/2007	JOB NO: P7425-7290
--------	----------	------------	--------------------


CHECK BY: RSL



DSCODE:

HPHarold A308 Bathrooms

Bill of Materials				
DID	DESCRIPTION	MANUFACTURER	PART NUMBER	QTY
DATP	DISCHARGE AIR TEMP SENSOR	BAPI	BA/10K-2-RPP-8	102 ea
RIB	RELAY	FUNCTIONAL DEVICES	RIBU1C	102 ea
RIBX	CURRENT SWITCH	FUNCTIONAL DEVICES	RIBXKF	102 ea
TR-50	TRANSFORMER, 120/24VAC, 50VA	FUNCTIONAL DEVICES	TR50VA002	102 ea
ZN551	CONTROL MODULE	AUTOMATED LOGIC	ZN551	102 ea
ZNT	ZONE TEMPERATURE SENSOR	AUTOMATED LOGIC	RS PLUS	102 ea

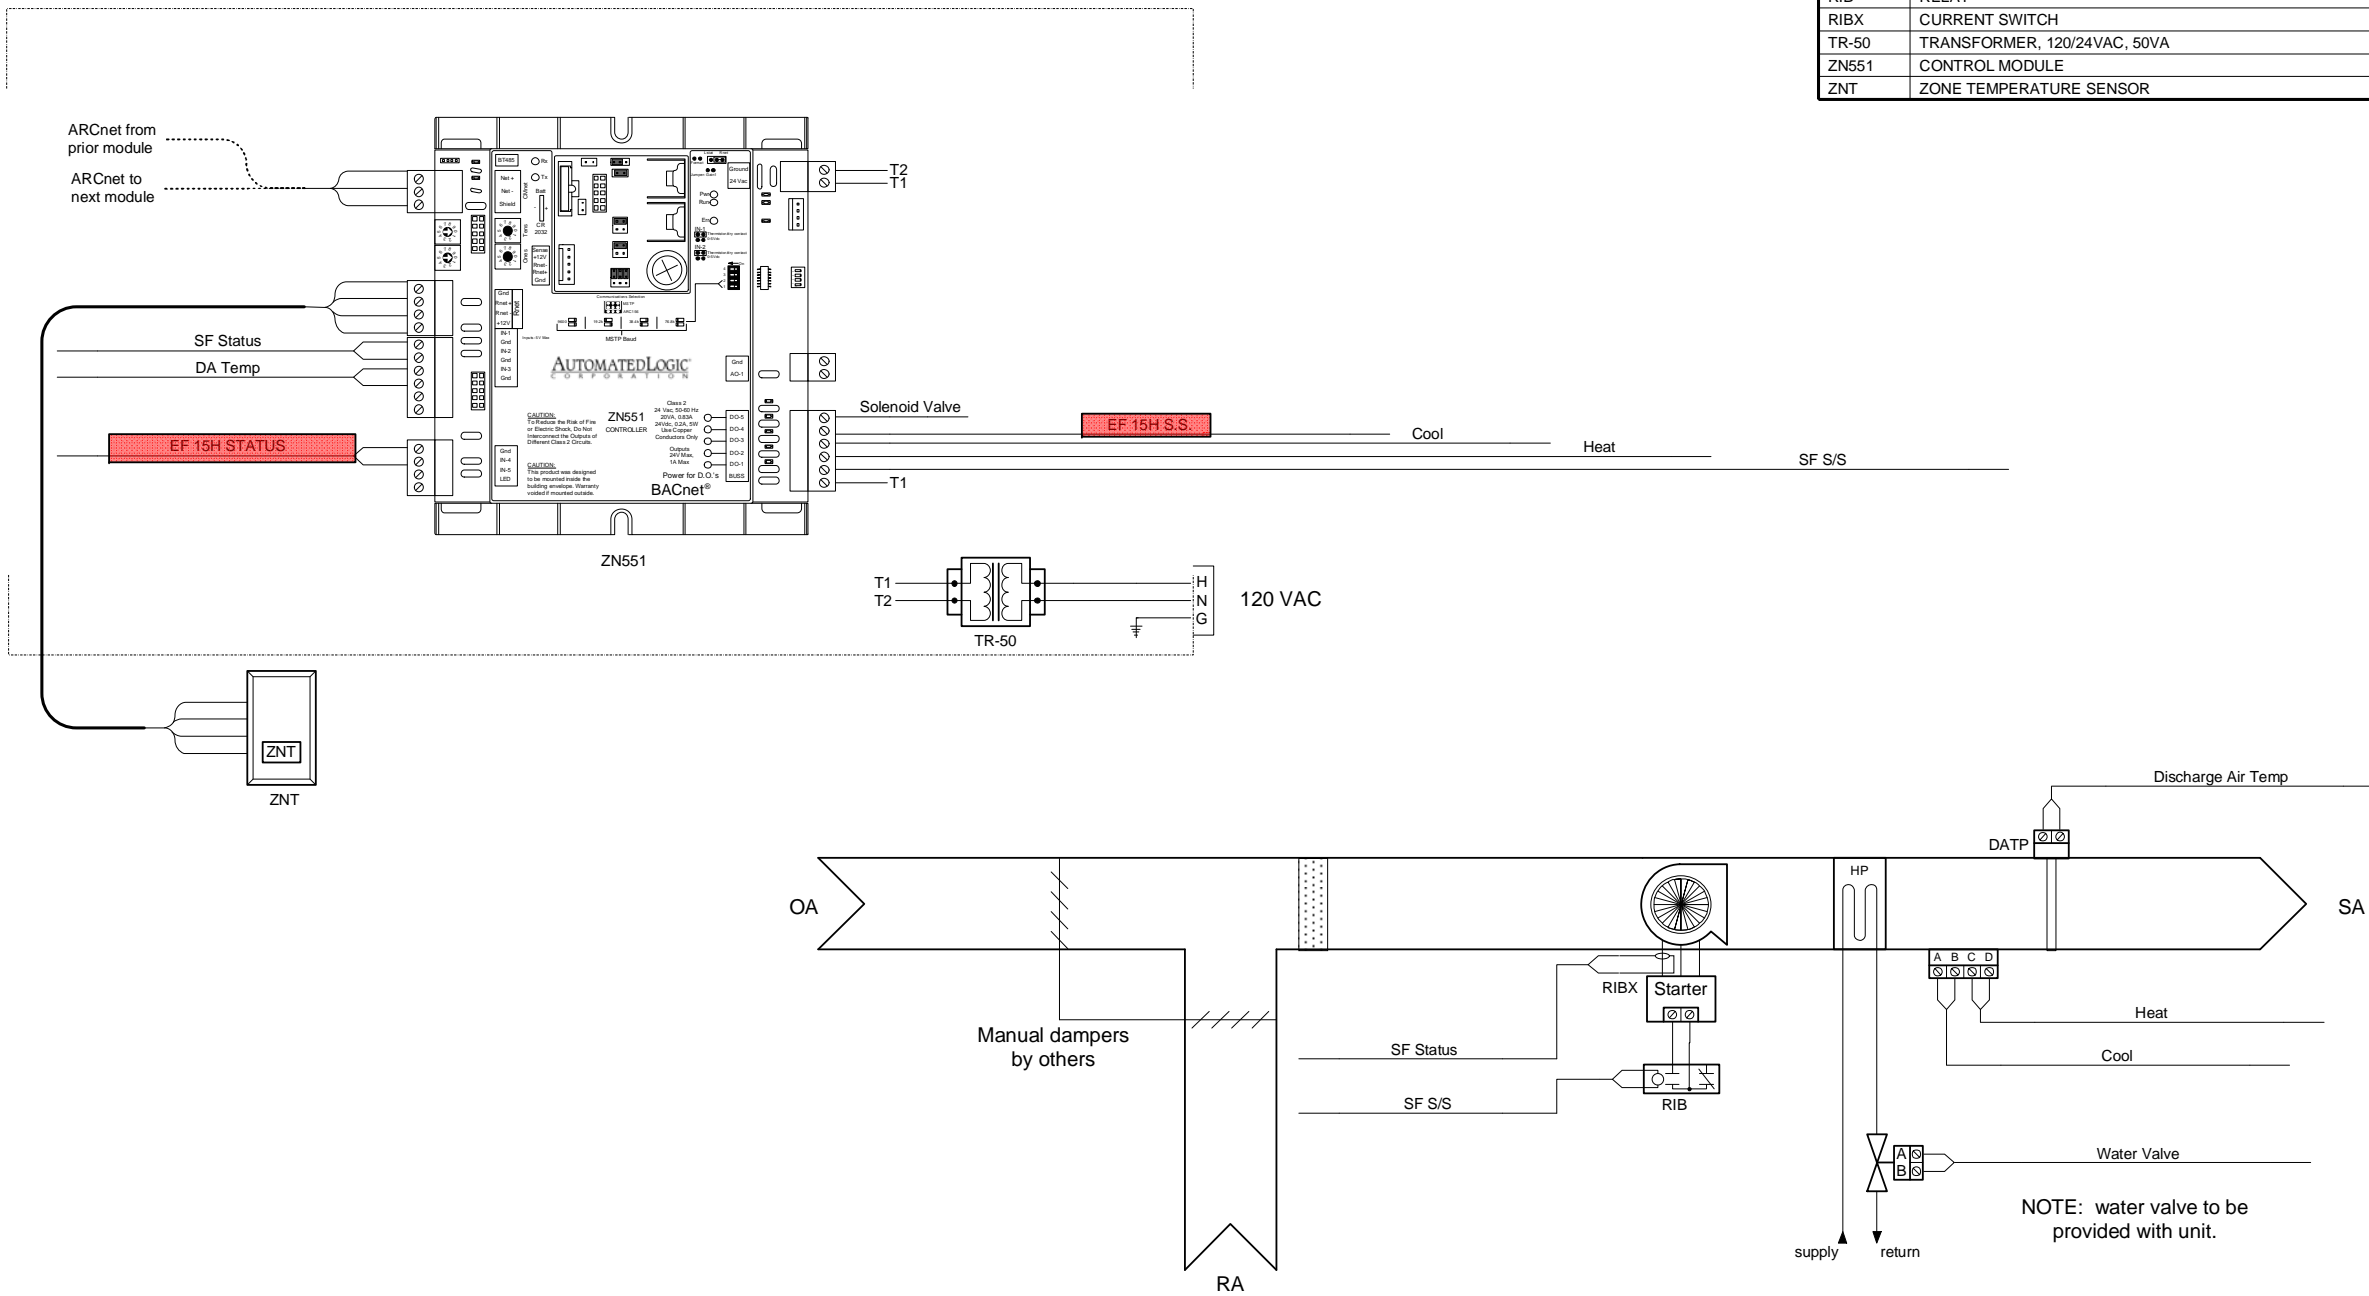

General Notes:

All ARC156 wiring shall be 22AWG single twisted pair, low capacitance (12.5pF/ft), shielded, plenum rated cable. ALC recommends Magnum Cable Corporation Product number A3ARC156.

Each ARC156 segment must be wired in a daisy chain configuration. Branching requires the use of a REP485.

Each ARC156 segment should have one (1) PROT485 installed to provide protection from electrical surges.


Each ARC156 segment end must be terminated with a TERM485 (120 ohm) terminating resistor.

The ARC156 network segment must have at least one (1) DIAG485 installed to supply bias.

Do not strip back shielded cable sheath more than 1" in order to keep twisted pair from separating. Do not ground shield to the panel or chassis ground. The shield should only be connected to the "Optional Shield" connection at a module.



Routing of communications cabling and control module locations shall be field verified.



DCMO BOCES - Phase 1&2 AS BUILT			
Norwich / Masonville, New York			
Air Temp Heating & Air Conditioning, Inc.			
HPHarold A308 Bathrooms			
REV: 1	As-Built	11/19/2007	JOB NO: P7425-7290
			CHECK BY: RSL
			DSCODE:
44 of 69			

HPHarold A212

Bill of Materials				
DID	DESCRIPTION	MANUFACTURER	PART NUMBER	QTY
DATP	DISCHARGE AIR TEMP SENSOR	BAPI	BA/10K-2-RPP-8	102 ea
RIB	RELAY	FUNCTIONAL DEVICES	RIBU1C	102 ea
RIBX	CURRENT SWITCH	FUNCTIONAL DEVICES	RIBXKF	102 ea
TR-50	TRANSFORMER, 120/24VAC, 50VA	FUNCTIONAL DEVICES	TR50VA002	102 ea
ZN551	CONTROL MODULE	AUTOMATED LOGIC	ZN551	102 ea
ZNT	ZONE TEMPERATURE SENSOR	AUTOMATED LOGIC	RS PLUS	102 ea

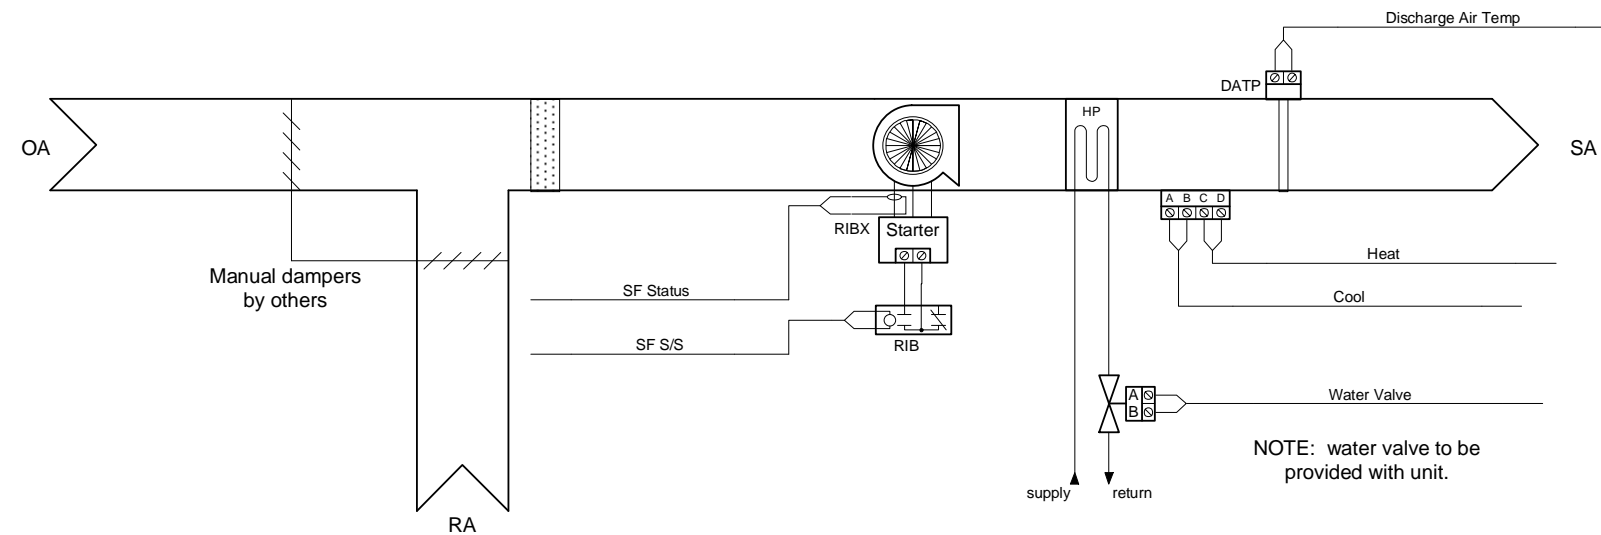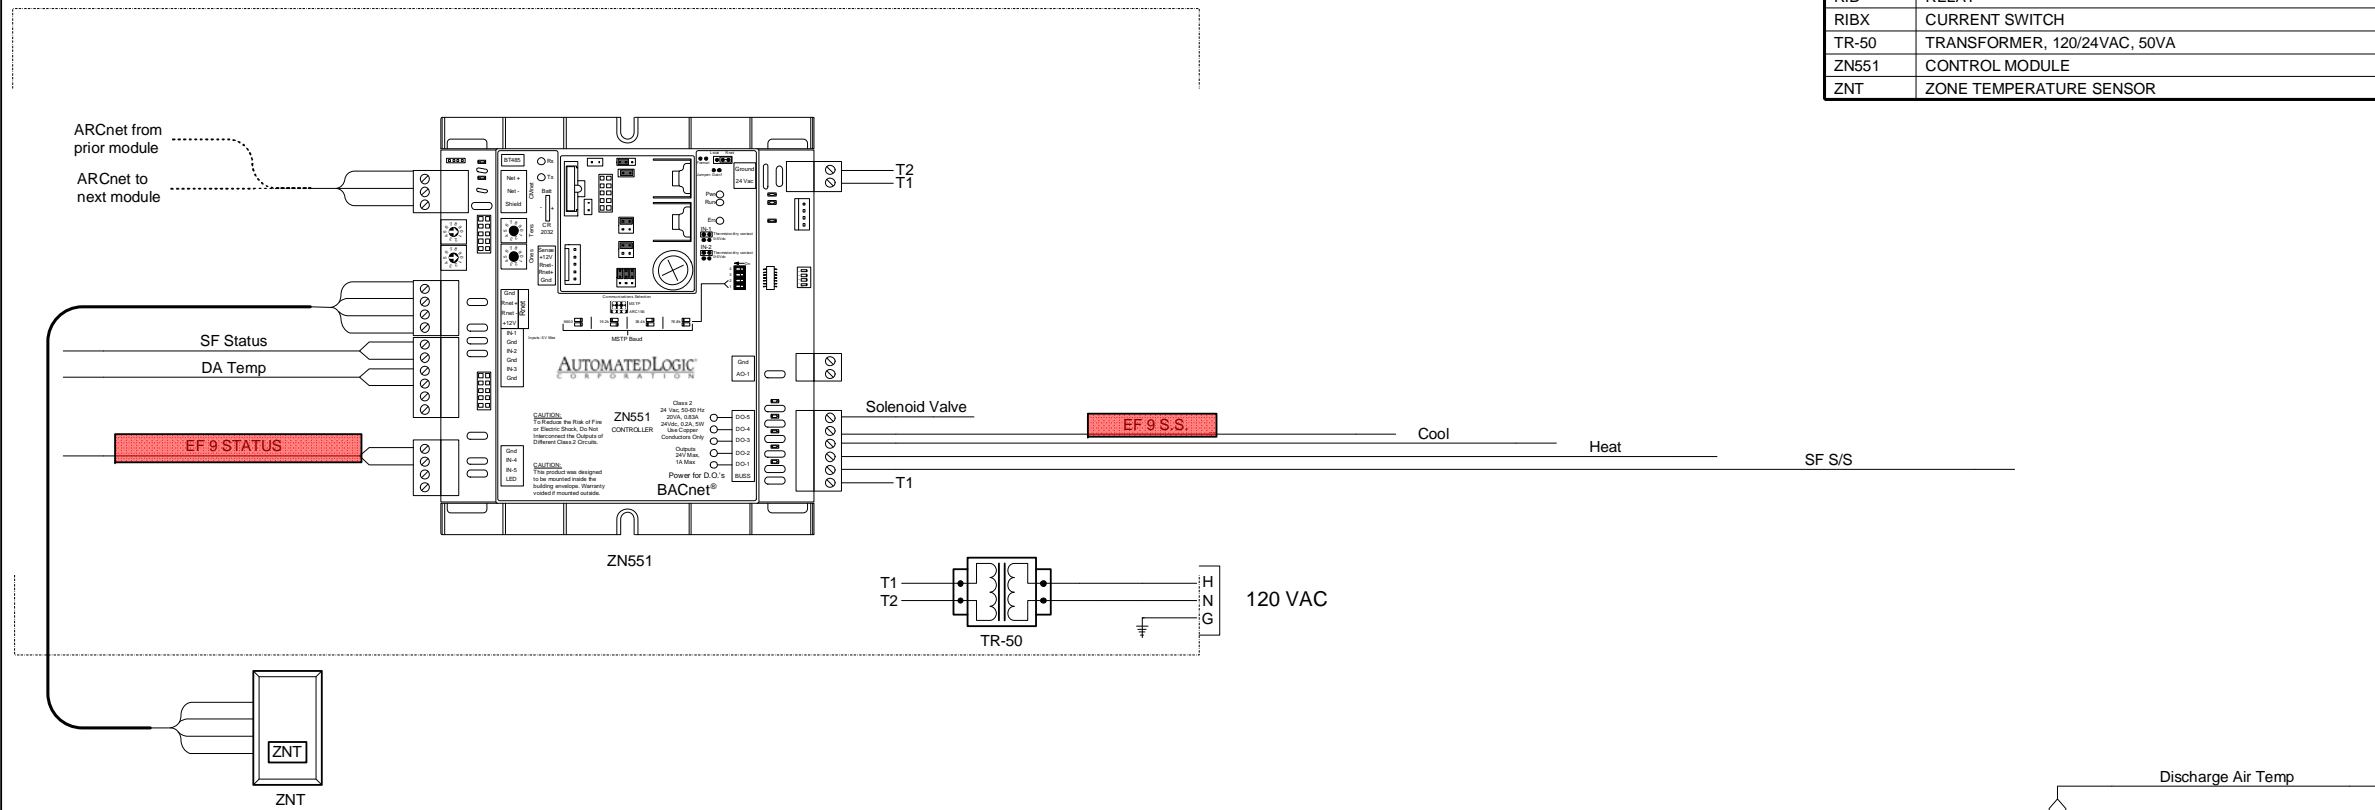

General Notes:

All ARC156 wiring shall be 22AWG single twisted pair, low capacitance (12.5pF/ft), shielded, plenum rated cable. ALC recommends Magnum Cable Corporation Product number A3ARC156.

Each ARC156 segment must be wired in a daisy chain configuration. Branching requires the use of a REP485.

Each ARC156 segment should have one (1) PROT485 installed to provide protection from electrical surges.


Each ARC156 segment end must be terminated with a TERM485 (120 ohm) terminating resistor.

The ARC156 network segment must have at least one (1) DIAG485 installed to supply bias.

Do not strip back shielded cable sheath more than 1" in order to keep twisted pair from separating. Do not ground shield to the panel or chassis ground. The shield should only be connected to the "Optional Shield" connection at a module.



Routing of communications cabling and control module locations shall be field verified.



DCMO BOCES - Phase 1&2 AS BUILT			
Norwich / Masonville, New York			
Air Temp Heating & Air Conditioning, Inc.			
HPHarold A212			
REV: 1	As-Built	11/19/2007	JOB NO: P7425-7290
			CHECK BY: RSL
			DSCODE:
45 of 69			

HPHarold A301 Bathrooms

Bill of Materials				
DID	DESCRIPTION	MANUFACTURER	PART NUMBER	QTY
DATP	DISCHARGE AIR TEMP SENSOR	BAPI	BA/10K-2-RPP-8	102 ea
RIB	RELAY	FUNCTIONAL DEVICES	RIBU1C	102 ea
RIBX	CURRENT SWITCH	FUNCTIONAL DEVICES	RIBXKF	102 ea
TR-50	TRANSFORMER, 120/24VAC, 50VA	FUNCTIONAL DEVICES	TR50VA002	102 ea
ZN551	CONTROL MODULE	AUTOMATED LOGIC	ZN551	102 ea
ZNT	ZONE TEMPERATURE SENSOR	AUTOMATED LOGIC	RS PLUS	102 ea

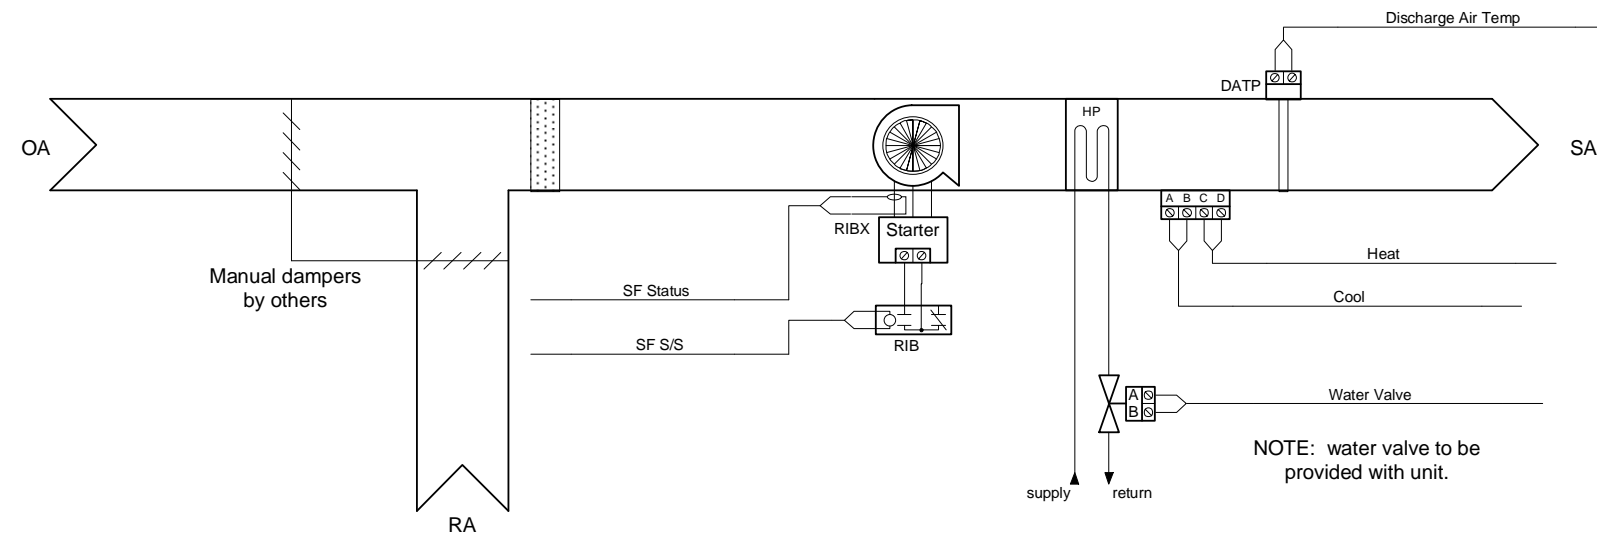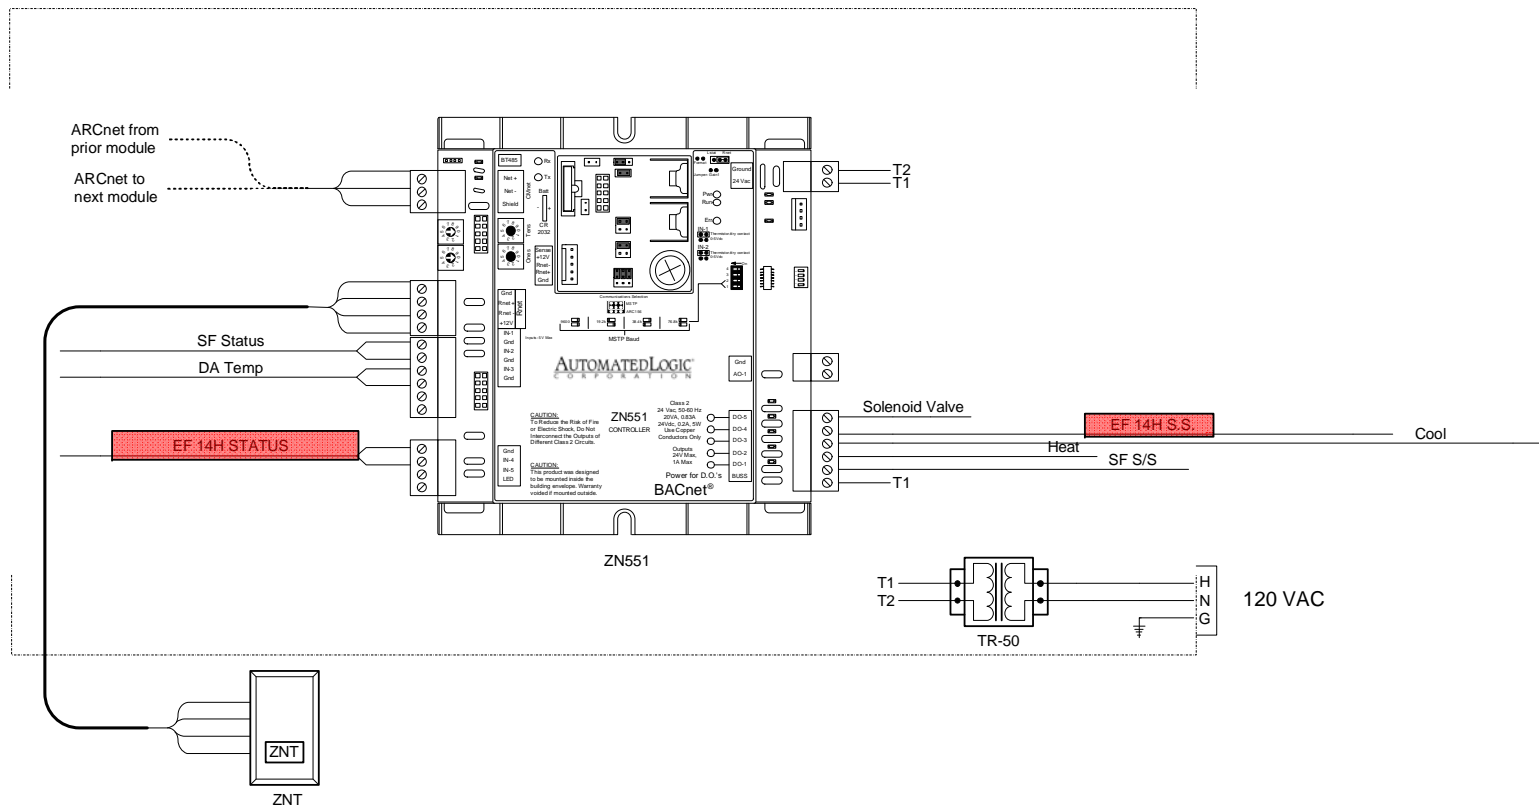

General Notes:

All ARC156 wiring shall be 22AWG single twisted pair, low capacitance (12.5pF/ft), shielded, plenum rated cable. ALC recommends Magnum Cable Corporation Product number A3ARC156.

Each ARC156 segment must be wired in a daisy chain configuration. Branching requires the use of a REP485.

Each ARC156 segment should have one (1) PROT485 installed to provide protection from electrical surges.


Each ARC156 segment end must be terminated with a TERM485 (120 ohm) terminating resistor.

The ARC156 network segment must have at least one (1) DIAG485 installed to supply bias.


Do not strip back shielded cable sheath more than 1" in order to keep twisted pair from separating. Do not ground shield to the panel or chassis ground. The shield should only be connected to the "Optional Shield" connection at a module.

Routing of communications cabling and control module locations shall be field verified.




DCMO BOCES - Phase 1&2 AS BUILT			
Norwich / Masonville, New York			
Air Temp Heating & Air Conditioning, Inc.			
HPHarold A301 Bathrooms			
REV: 1	As-Built	11/19/2007	JOB NO: P7425-7290
			CHECK BY: RSL
			DSCODE:
46 of 69			

HPHarold A16 Corridor

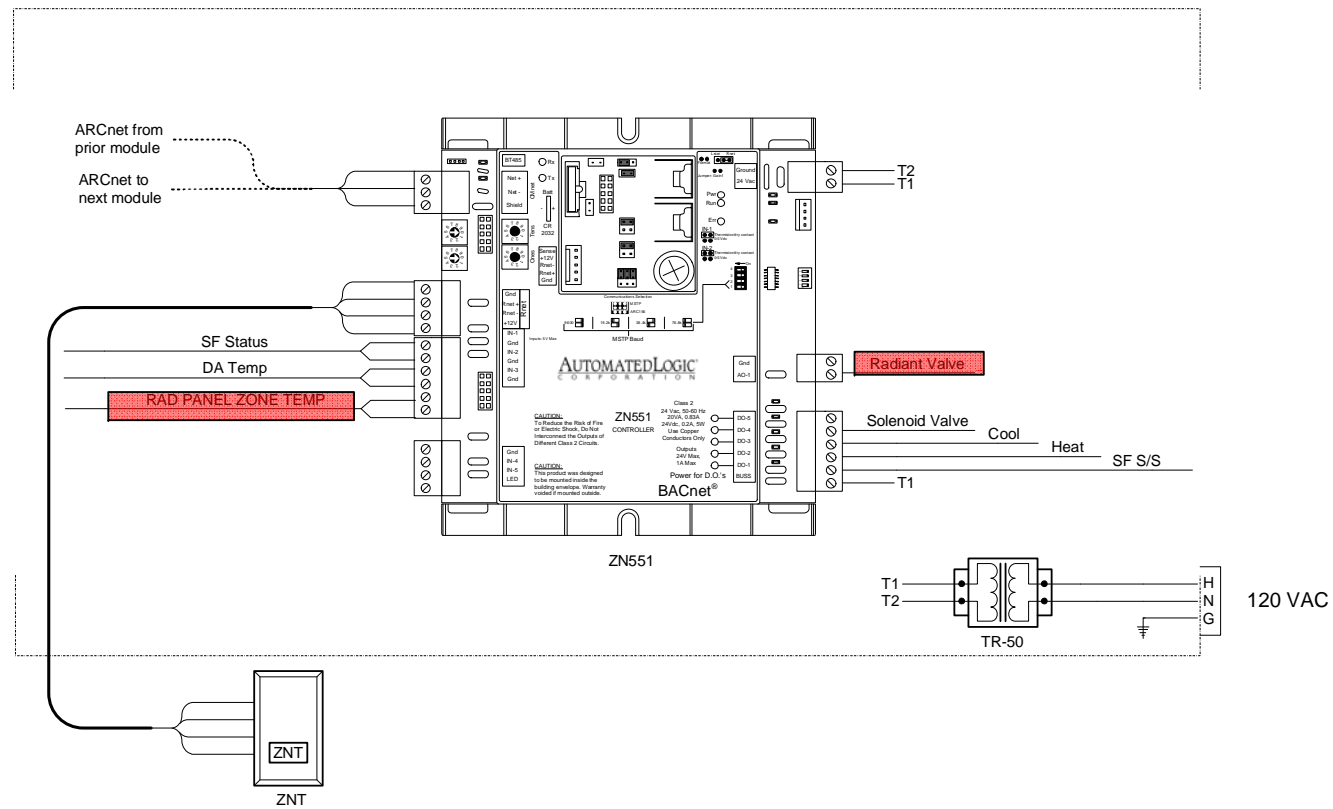

Bill of Materials				
DID	DESCRIPTION	MANUFACTURER	PART NUMBER	QTY
DATP	DISCHARGE AIR TEMP SENSOR	BAPI	BA/10K-2-RPP-8	102 ea
RIB	RELAY	FUNCTIONAL DEVICES	RIBU1C	102 ea
RIBX	CURRENT SWITCH	FUNCTIONAL DEVICES	RIBXKF	102 ea
TR-50	TRANSFORMER, 120/24VAC, 50VA	FUNCTIONAL DEVICES	TR50VA002	102 ea
ZN551	CONTROL MODULE	AUTOMATED LOGIC	ZN551	102 ea
ZNT	ZONE TEMPERATURE SENSOR	AUTOMATED LOGIC	RS PLUS	102 ea

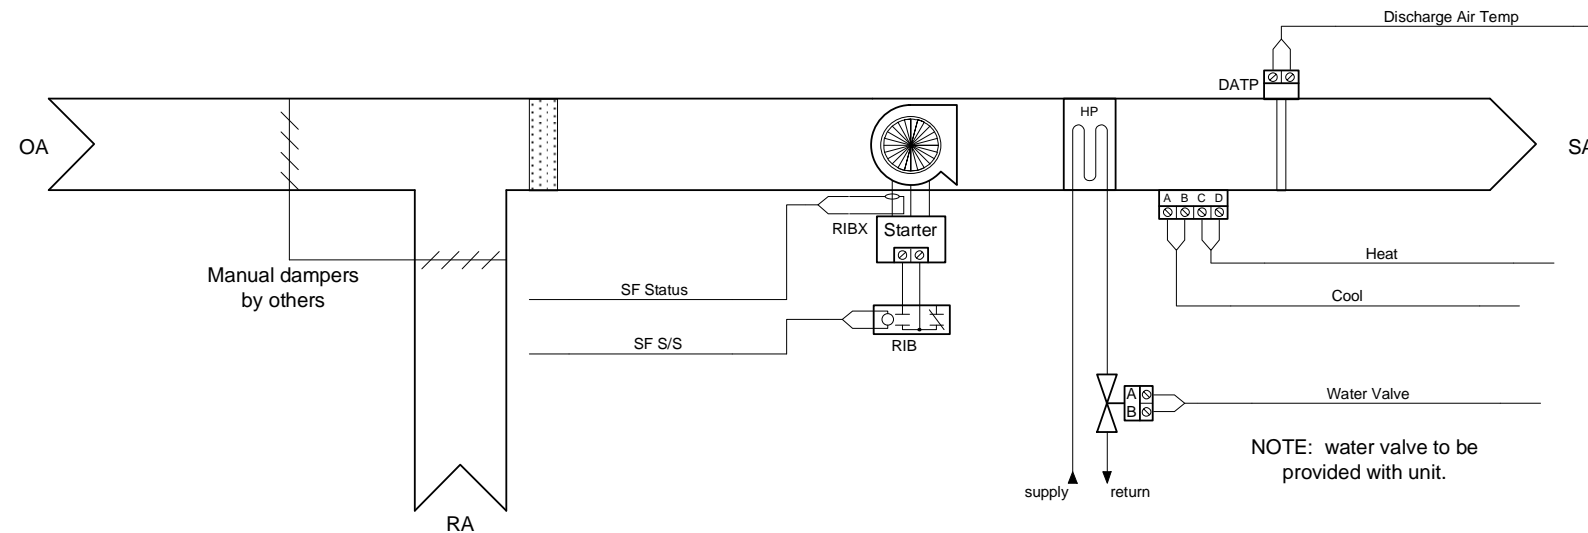

General Notes:

All ARC156 wiring shall be 22AWG single twisted pair, low capacitance (12.5pF/ft), shielded, plenum rated cable. ALC recommends Magnum Cable Corporation Product number A3ARC156.

Each ARC156 segment must be wired in a daisy chain configuration. Branching requires the use of a REP485.

Each ARC156 segment should have one (1) PROT485 installed to provide protection from electrical surges.


Each ARC156 segment end must be terminated with a TERM485 (120 ohm) terminating resistor.

The ARC156 network segment must have at least one (1) DIAG485 installed to supply bias.

Do not strip back shielded cable sheath more than 1" in order to keep twisted pair from separating. Do not ground shield to the panel or chassis ground. The shield should only be connected to the "Optional Shield" connection at a module.



Routing of communications cabling and control module locations shall be field verified.



DCMO BOCES - Phase 1&2 AS BUILT			
Norwich / Masonville, New York			
Air Temp Heating & Air Conditioning, Inc.			
HPHarold A16 Corridor			
REV: 1	As-Built	11/19/2007	JOB NO: P7425-7290
			CHECK BY: RSL
			DSCODE:
47 of 69			

HPHarold A226 Office

Bill of Materials				
DID	DESCRIPTION	MANUFACTURER	PART NUMBER	QTY
DATP	DISCHARGE AIR TEMP SENSOR	BAPI	BA/10K-2-RPP-8	102 ea
RIB	RELAY	FUNCTIONAL DEVICES	RIBU1C	102 ea
RIBX	CURRENT SWITCH	FUNCTIONAL DEVICES	RIBXKF	102 ea
TR-50	TRANSFORMER, 120/24VAC, 50VA	FUNCTIONAL DEVICES	TR50VA002	102 ea
ZN551	CONTROL MODULE	AUTOMATED LOGIC	ZN551	102 ea
ZNT	ZONE TEMPERATURE SENSOR	AUTOMATED LOGIC	RS PLUS	102 ea

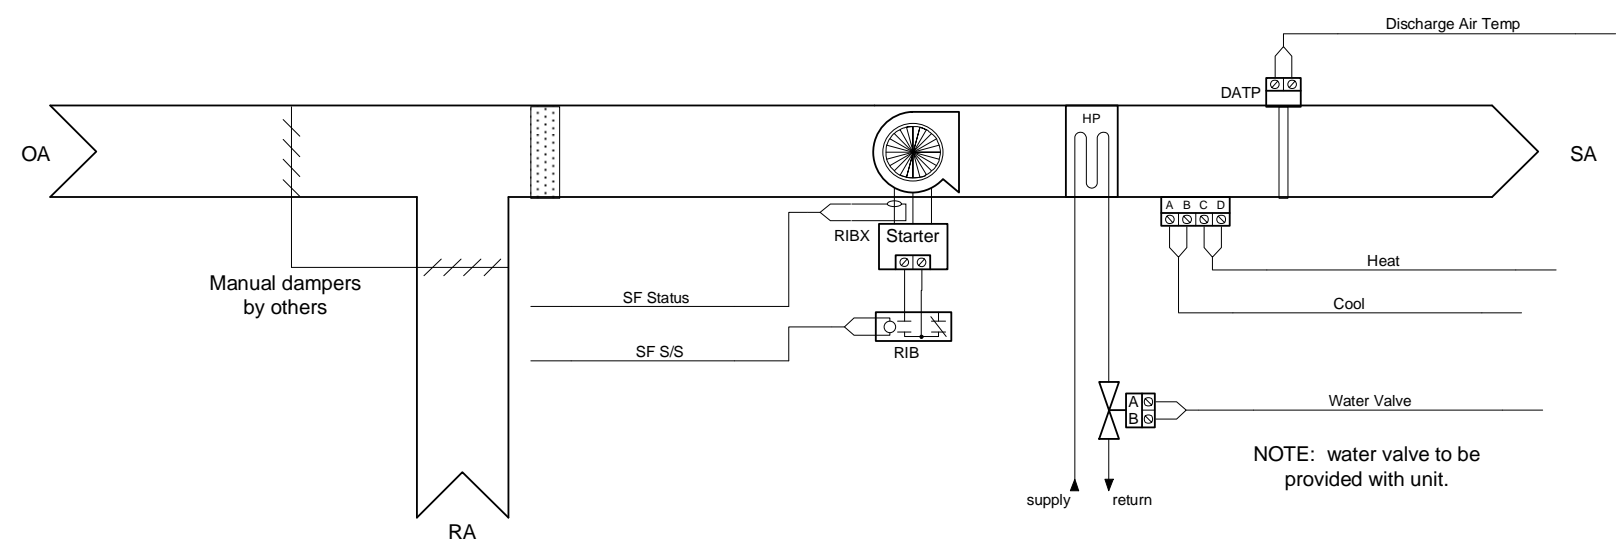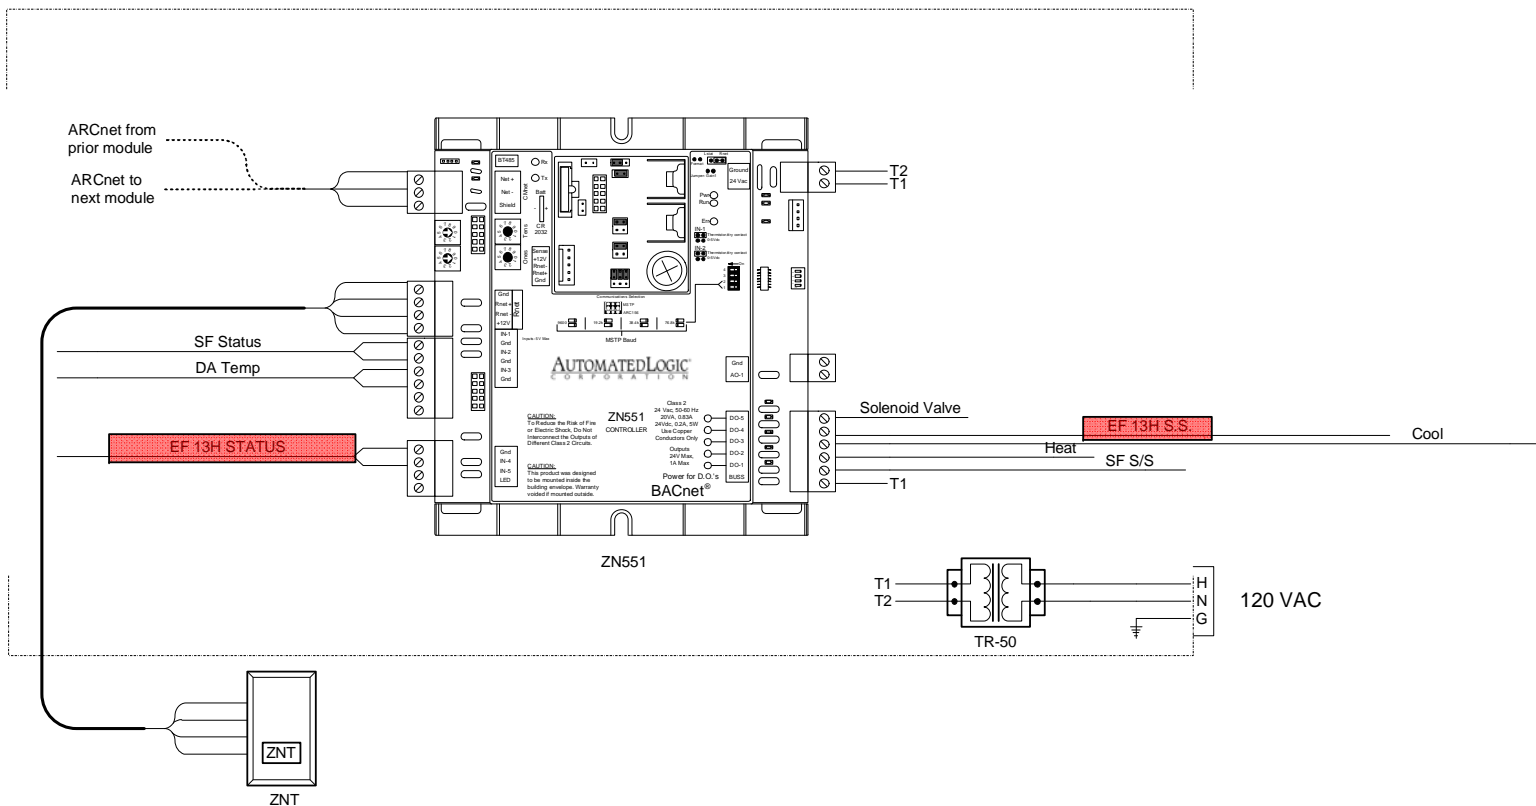

General Notes:
 All ARC156 wiring shall be 22AWG single twisted pair, low capacitance (12.5pF/ft), shielded, plenum rated cable. ALC recommends Magnum Cable Corporation Product number A3ARC156.

Each ARC156 segment must be wired in a daisy chain configuration. Branching requires the use of a REP485.

Each ARC156 segment should have one (1) PROT485 installed to provide protection from electrical surges.


Each ARC156 segment end must be terminated with a TERM485 (120 ohm) terminating resistor.

The ARC156 network segment must have at least one (1) DIAG485 installed to supply bias.



Do not strip back shielded cable sheath more than 1" in order to keep twisted pair from separating. Do not ground shield to the panel or chassis ground. The shield should only be connected to the "Optional Shield" connection at a module.

Routing of communications cabling and control module locations shall be field verified.



DCMO BOCES - Phase 1&2 AS BUILT			
Norwich / Masonville, New York			
Air Temp Heating & Air Conditioning, Inc.			
HPHarold A226 Office			
REV: 1	As-Built	11/19/2007	JOB NO: P7425-7290
			CHECK BY: RSL
			DSCODE:
48 of 69			

HPHarold B312 Bathrooms

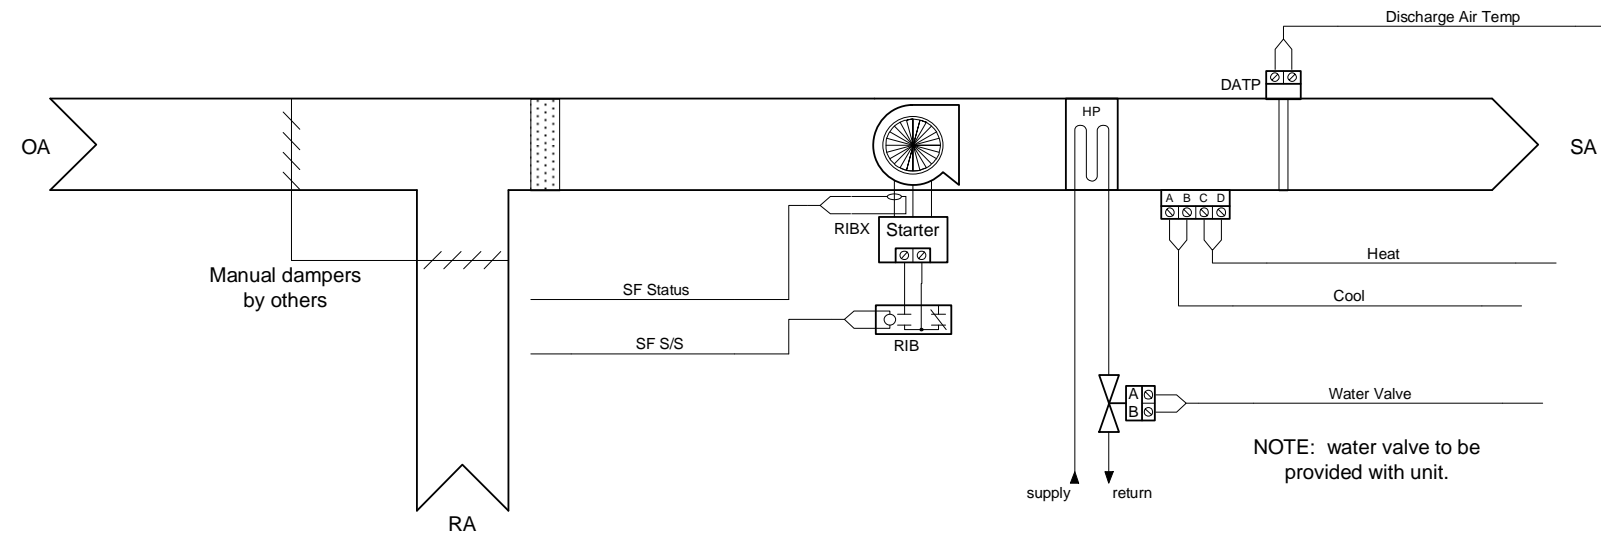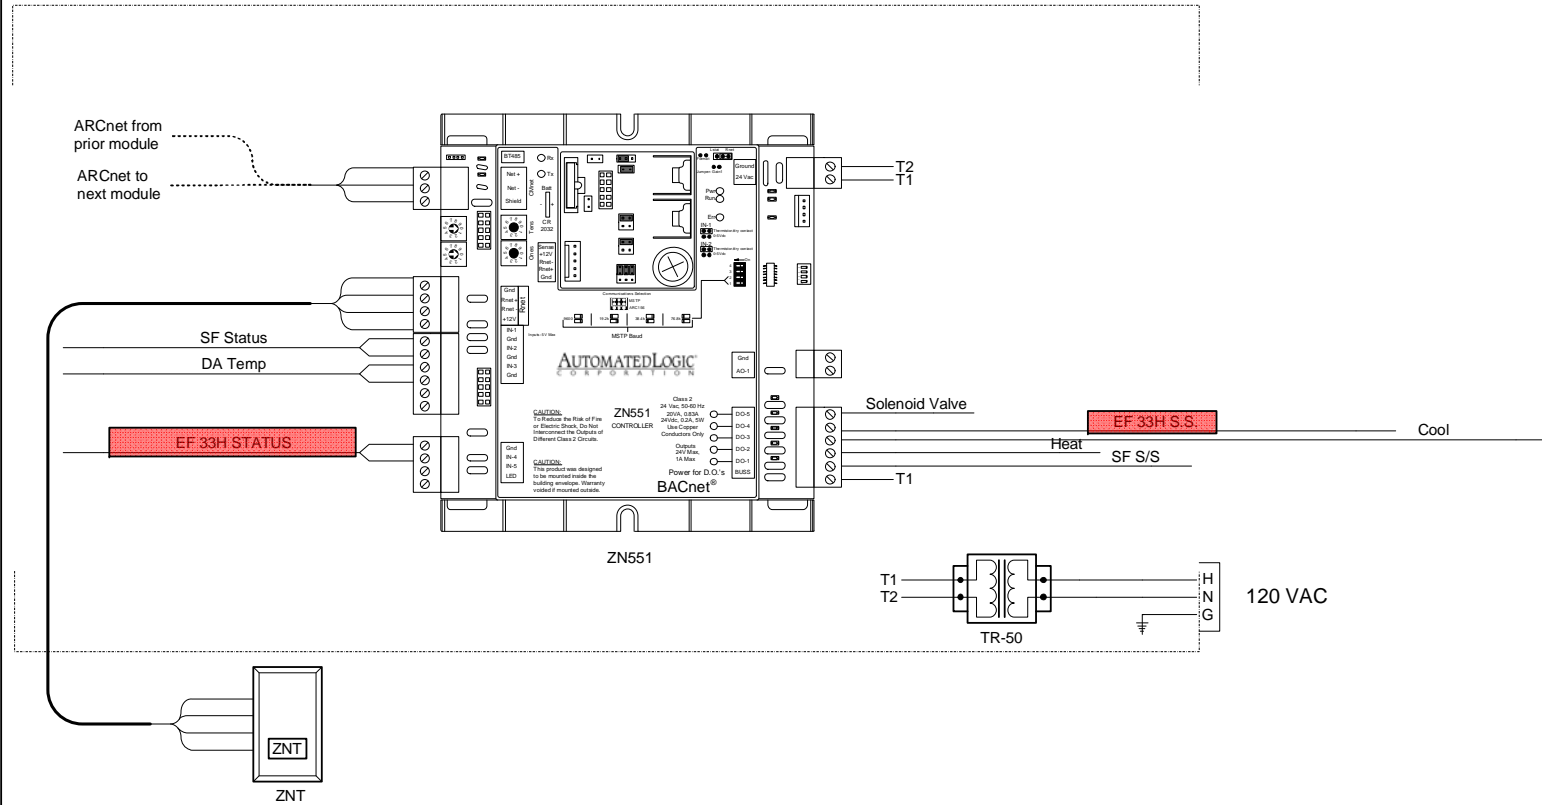

Bill of Materials				
DID	DESCRIPTION	MANUFACTURER	PART NUMBER	QTY
DATP	DISCHARGE AIR TEMP SENSOR	BAPI	BA/10K-2-RPP-8	102 ea
RIB	RELAY	FUNCTIONAL DEVICES	RIBU1C	102 ea
RIBX	CURRENT SWITCH	FUNCTIONAL DEVICES	RIBXKF	102 ea
TR-50	TRANSFORMER, 120/24VAC, 50VA	FUNCTIONAL DEVICES	TR50VA002	102 ea
ZN551	CONTROL MODULE	AUTOMATED LOGIC	ZN551	102 ea
ZNT	ZONE TEMPERATURE SENSOR	AUTOMATED LOGIC	RS PLUS	102 ea

General Notes:

All ARC156 wiring shall be 22AWG single twisted pair, low capacitance (12.5pF/ft), shielded, plenum rated cable. ALC recommends Magnum Cable Corporation Product number A3ARC156.

Each ARC156 segment must be wired in a daisy chain configuration. Branching requires the use of a REP485.

Each ARC156 segment should have one (1) PROT485 installed to provide protection from electrical surges.


Each ARC156 segment end must be terminated with a TERM485 (120 ohm) terminating resistor.

The ARC156 network segment must have at least one (1) DIAG485 installed to supply bias.

Do not strip back shielded cable sheath more than 1" in order to keep twisted pair from separating. Do not ground shield to the panel or chassis ground. The shield should only be connected to the "Optional Shield" connection at a module.



Routing of communications cabling and control module locations shall be field verified.



DCMO BOCES - Phase 1&2 AS BUILT			
Norwich / Masonville, New York			
Air Temp Heating & Air Conditioning, Inc.			
HPHarold B312 Bathrooms			
REV: 1	As-Built	11/19/2007	JOB NO: P7425-7290
			CHECK BY: RSL
			DSCODE:
49 of 69			

HPHarold A215 Bathrooms

Bill of Materials				
DID	DESCRIPTION	MANUFACTURER	PART NUMBER	QTY
DATP	DISCHARGE AIR TEMP SENSOR	BAPI	BA/10K-2-RPP-8	102 ea
RIB	RELAY	FUNCTIONAL DEVICES	RIBU1C	102 ea
RIBX	CURRENT SWITCH	FUNCTIONAL DEVICES	RIBXKF	102 ea
TR-50	TRANSFORMER, 120/24VAC, 50VA	FUNCTIONAL DEVICES	TR50VA002	102 ea
ZN551	CONTROL MODULE	AUTOMATED LOGIC	ZN551	102 ea
ZNT	ZONE TEMPERATURE SENSOR	AUTOMATED LOGIC	RS PLUS	102 ea

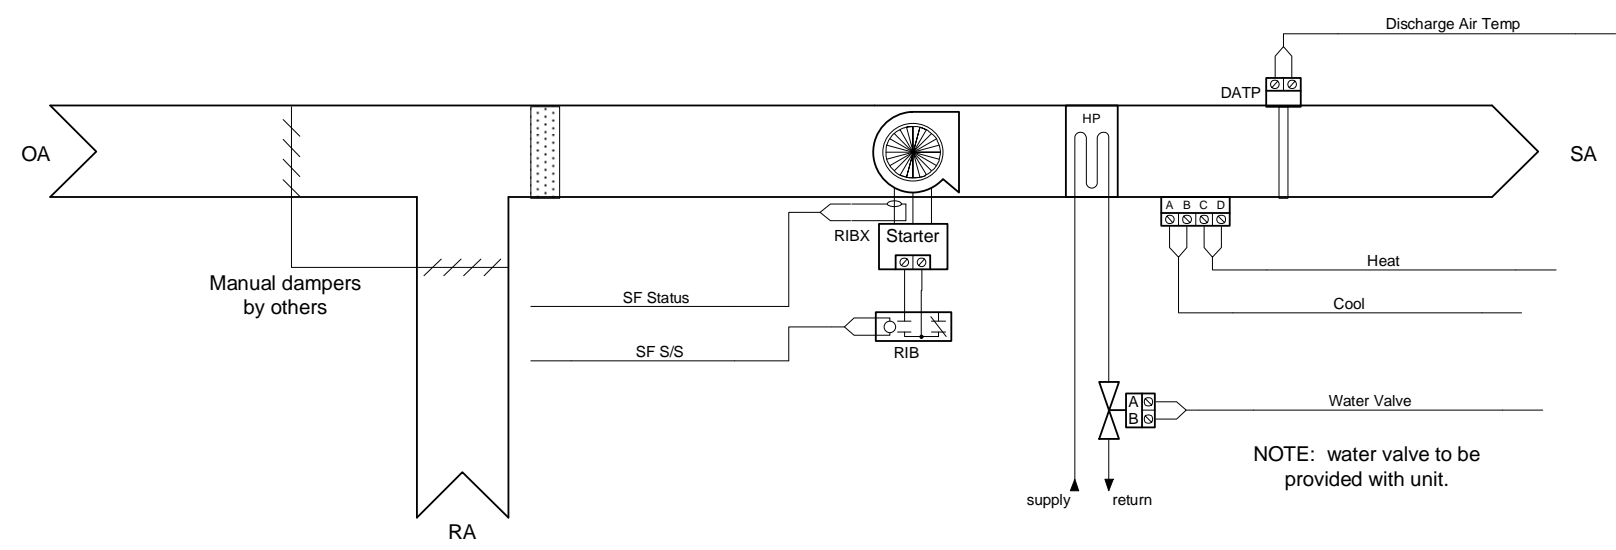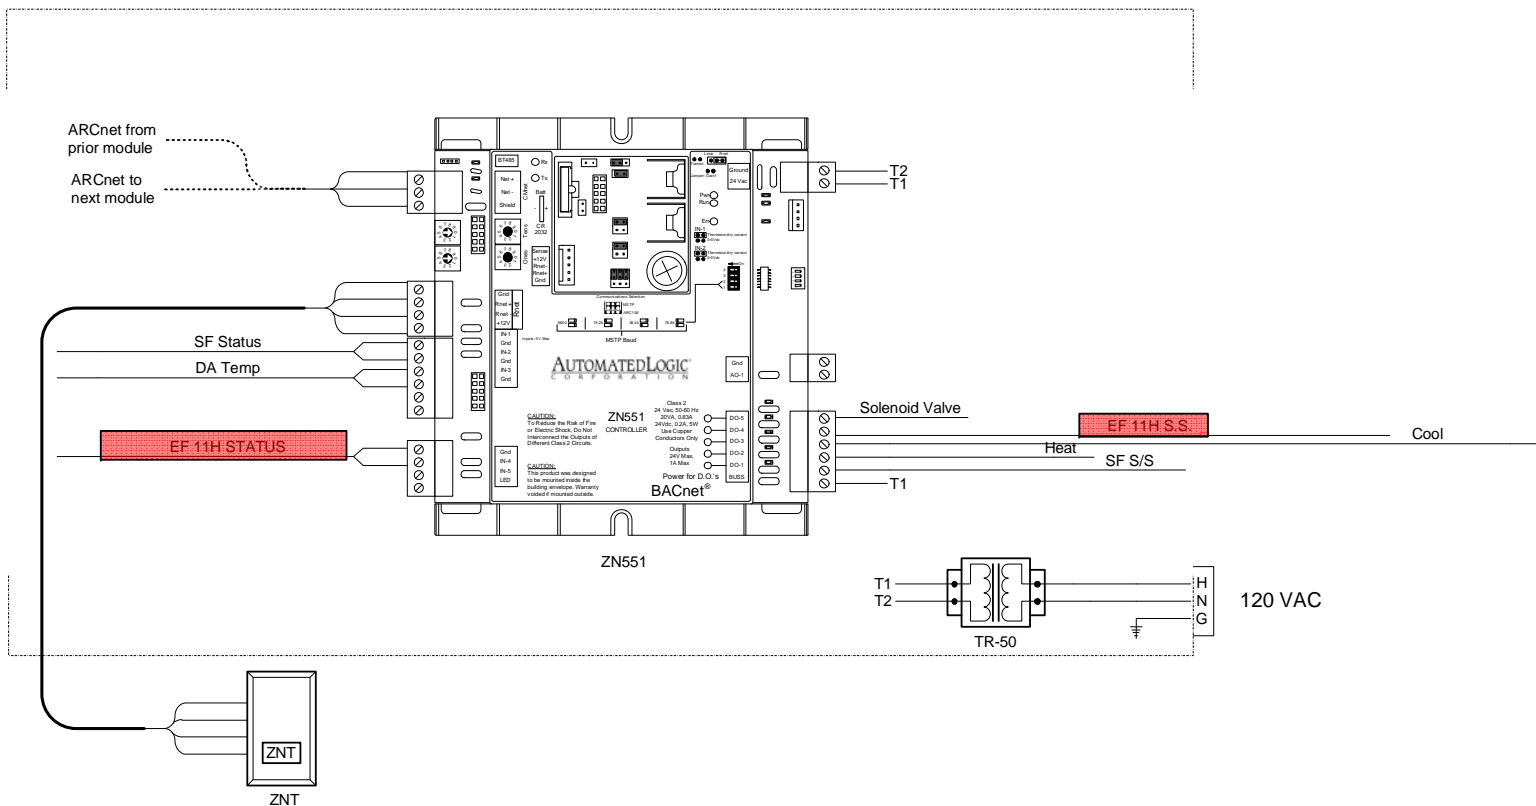

General Notes:
 All ARC156 wiring shall be 22AWG single twisted pair, low capacitance (12.5pF/ft), shielded, plenum rated cable. ALC recommends Magnum Cable Corporation Product number A3ARC156.

Each ARC156 segment must be wired in a daisy chain configuration. Branching requires the use of a REP485.

Each ARC156 segment should have one (1) PROT485 installed to provide protection from electrical surges.


Each ARC156 segment end must be terminated with a TERM485 (120 ohm) terminating resistor.

The ARC156 network segment must have at least one (1) DIAG485 installed to supply bias.

Do not strip back shielded cable sheath more than 1" in order to keep twisted pair from separating. Do not ground shield to the panel or chassis ground. The shield should only be connected to the "Optional Shield" connection at a module.



Routing of communications cabling and control module locations shall be field verified.



DCMO BOCES - Phase 1&2 AS BUILT			
Norwich / Masonville, New York			
Air Temp Heating & Air Conditioning, Inc.			
HPHarold A215 Bathrooms			
REV: 1	As-Built	11/19/2007	JOB NO: P7425-7290
CHECK BY: RSL			DSCODE:
			50 of 69

HPHarold A227.3 Work Room

Bill of Materials				
DID	DESCRIPTION	MANUFACTURER	PART NUMBER	QTY
DATP	DISCHARGE AIR TEMP SENSOR	BAPI	BA/10K-2-RPP-8	102 ea
RIB	RELAY	FUNCTIONAL DEVICES	RIBU1C	102 ea
RIBX	CURRENT SWITCH	FUNCTIONAL DEVICES	RIBXKF	102 ea
TR-50	TRANSFORMER, 120/24VAC, 50VA	FUNCTIONAL DEVICES	TR50VA002	102 ea
ZN551	CONTROL MODULE	AUTOMATED LOGIC	ZN551	102 ea
ZNT	ZONE TEMPERATURE SENSOR	AUTOMATED LOGIC	RS PLUS	102 ea

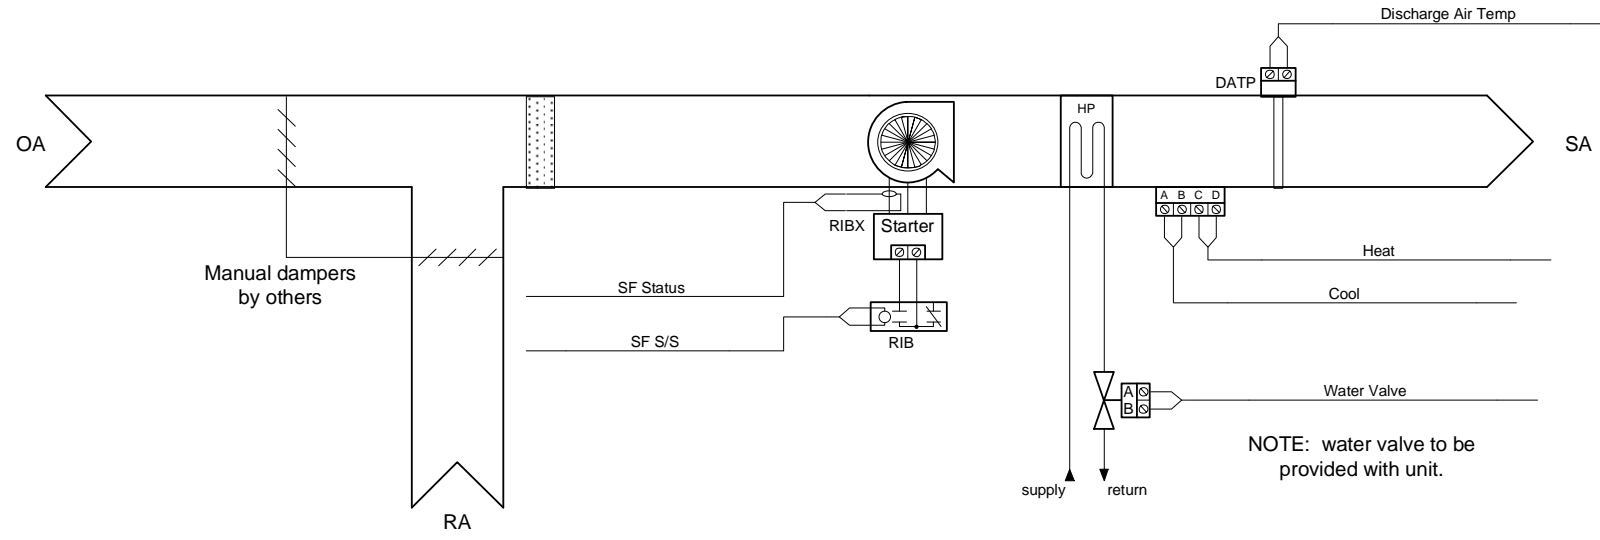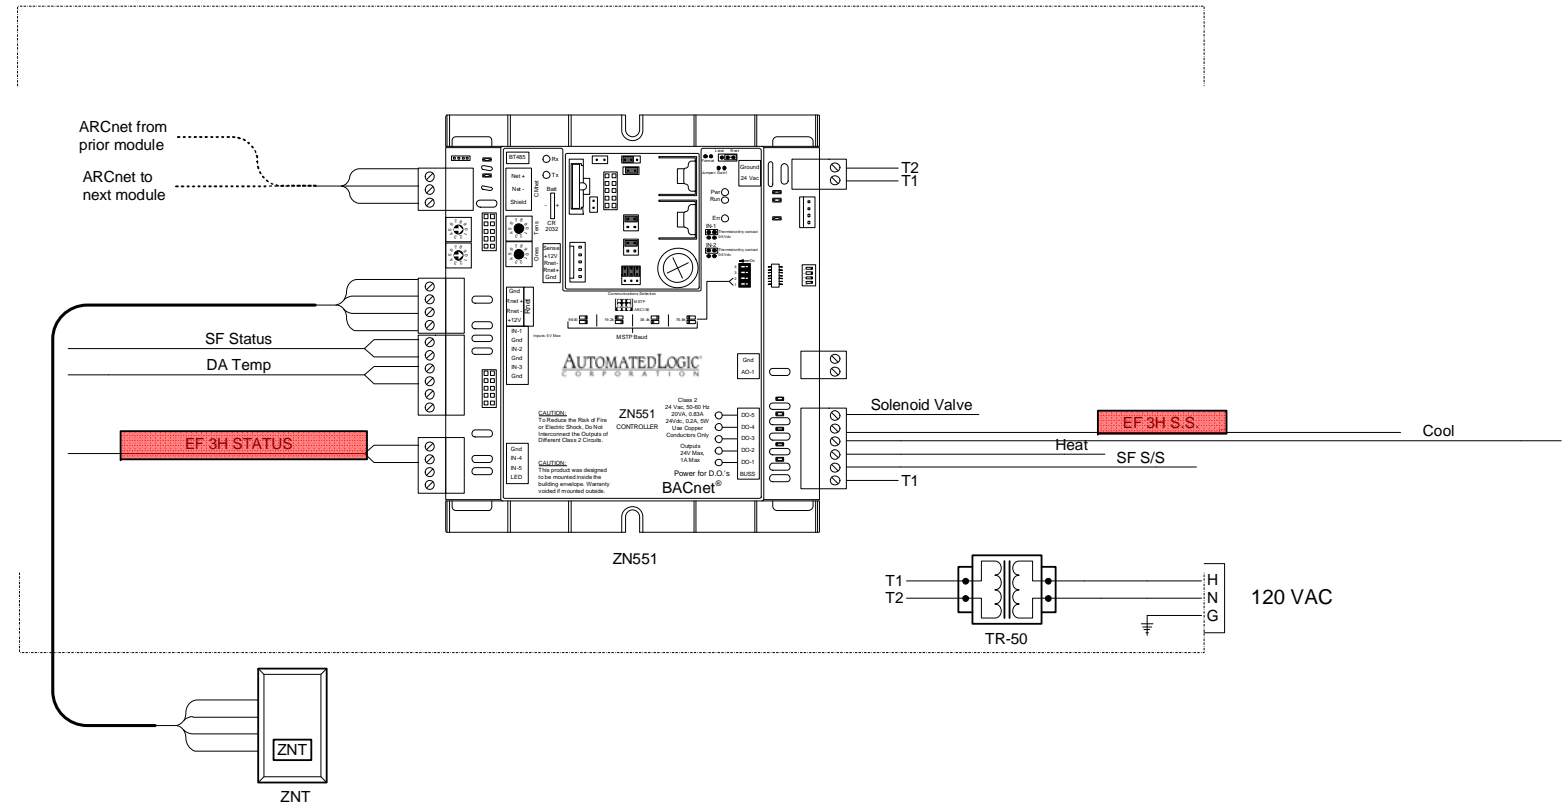

General Notes:
 All ARC156 wiring shall be 22AWG single twisted pair, low capacitance (12.5pF/ft), shielded, plenum rated cable. ALC recommends Magnum Cable Corporation Product number A3ARC156.

Each ARC156 segment must be wired in a daisy chain configuration. Branching requires the use of a REP485.

Each ARC156 segment should have one (1) PROT485 installed to provide protection from electrical surges.

Each ARC156 segment end must be terminated with a TERM485 (120 ohm) terminating resistor.

The ARC156 network segment must have at least one (1) DIAG485 installed to supply bias.

Do not strip back shielded cable sheath more than 1" in order to keep twisted pair from separating. Do not ground shield to the panel or chassis ground. The shield should only be connected to the "Optional Shield" connection at a module.

Routing of communications cabling and control module locations shall be field verified.



DCMO BOCES - Phase 1&2 AS BUILT
 Norwich / Masonville, New York

Air Temp Heating & Air Conditioning, Inc.

HPHarold A227.3 Work Room



REV: 1	As-Built	11/19/2007	JOB NO: P7425-7290
CHECK BY: RSL			DSCODE:

AIR TEMP HEATING & AIR CONDITIONING, INC.
 A LINC SERVICE CONTRACTOR

51 of 69

HPHarold A222 Office

Bill of Materials				
DID	DESCRIPTION	MANUFACTURER	PART NUMBER	QTY
DATP	DISCHARGE AIR TEMP SENSOR	BAPI	BA/10K-2-RPP-8	102 ea
RIB	RELAY	FUNCTIONAL DEVICES	RIBU1C	102 ea
RIBX	CURRENT SWITCH	FUNCTIONAL DEVICES	RIBXKF	102 ea
TR-50	TRANSFORMER, 120/24VAC, 50VA	FUNCTIONAL DEVICES	TR50VA002	102 ea
ZN551	CONTROL MODULE	AUTOMATED LOGIC	ZN551	102 ea
ZNT	ZONE TEMPERATURE SENSOR	AUTOMATED LOGIC	RS PLUS	102 ea

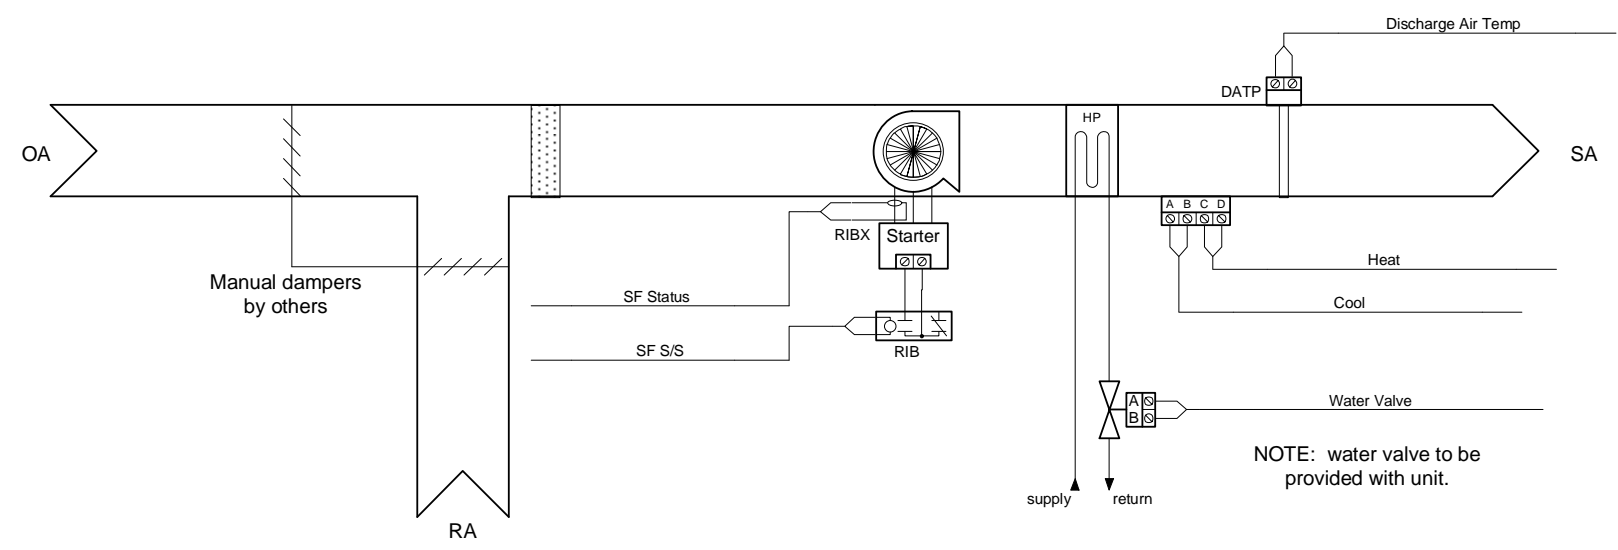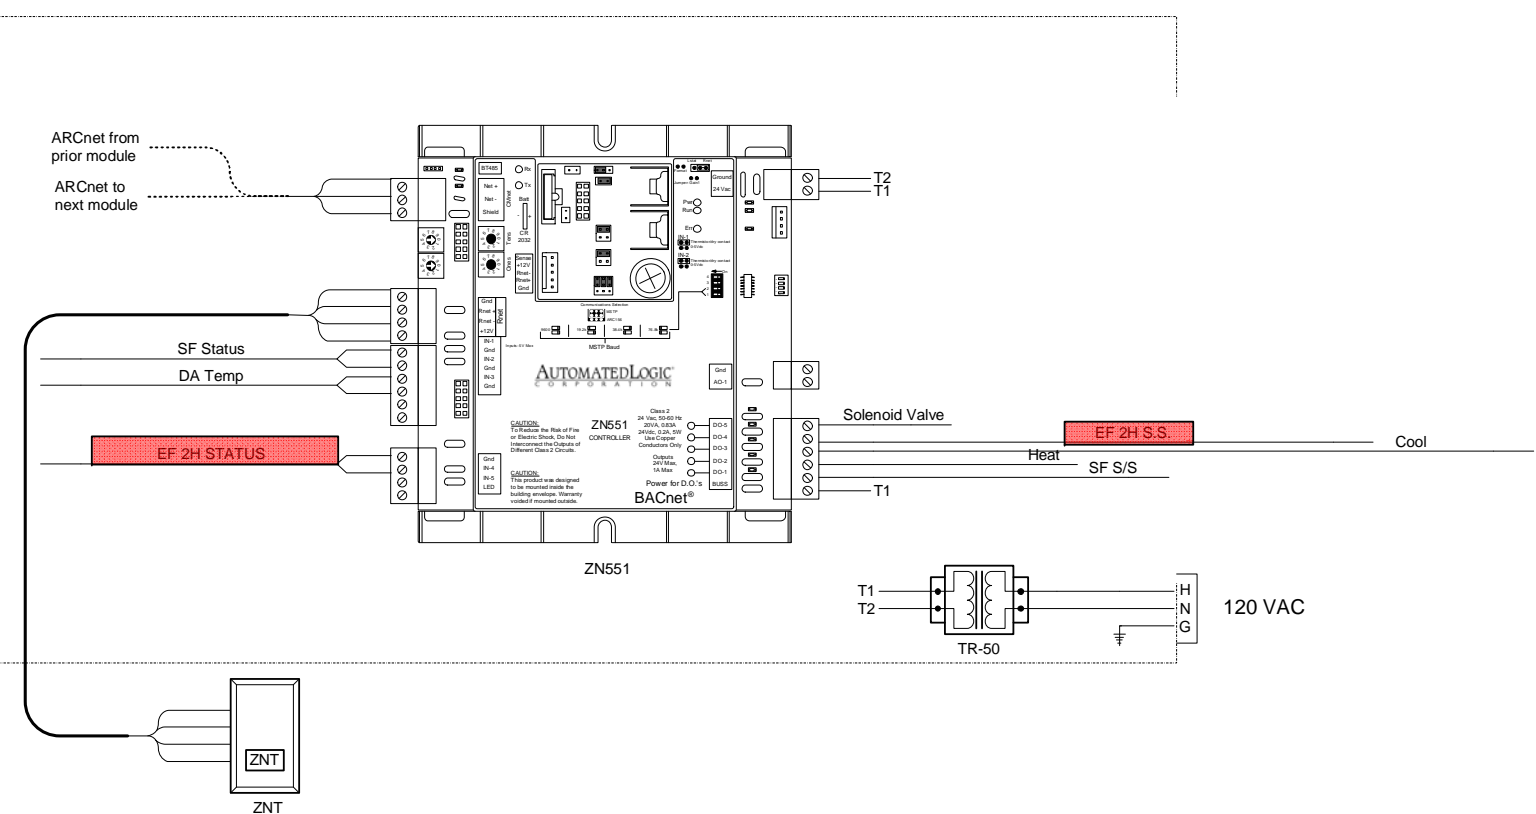

General Notes:
 All ARC156 wiring shall be 22AWG single twisted pair, low capacitance (12.5pF/ft), shielded, plenum rated cable. ALC recommends Magnum Cable Corporation Product number A3ARC156.

Each ARC156 segment must be wired in a daisy chain configuration. Branching requires the use of a REP485.

Each ARC156 segment should have one (1) PROT485 installed to provide protection from electrical surges.

Each ARC156 segment end must be terminated with a TERM485 (120 ohm) terminating resistor.

The ARC156 network segment must have at least one (1) DIAG485 installed to supply bias.


Do not strip back shielded cable sheath more than 1" in order to keep twisted pair from separating. Do not ground shield to the panel or chassis ground. The shield should only be connected to the "Optional Shield" connection at a module.

Routing of communications cabling and control module locations shall be field verified.




DCMO BOCES - Phase 1&2 AS BUILT
 Norwich / Masonville, New York


Air Temp Heating & Air Conditioning, Inc.
 HPHarold A222 Office

REV: 1	As-Built	11/19/2007	JOB NO: P7425-7290
			CHECK BY: RSL
			DSCODE:
52 of 69			

HPHarold South Stairs Upper

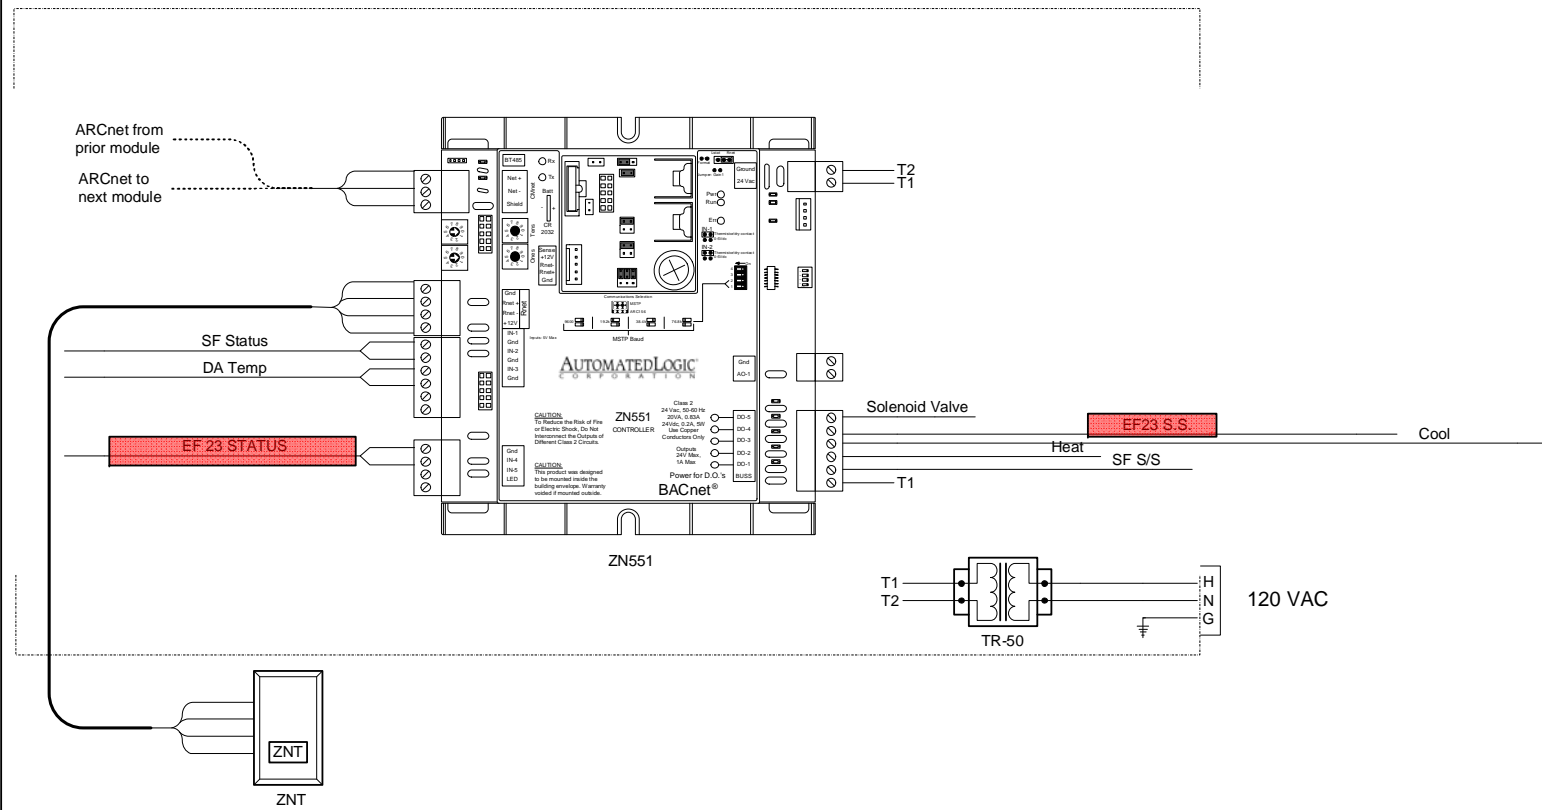

Bill of Materials				
DID	DESCRIPTION	MANUFACTURER	PART NUMBER	QTY
DATP	DISCHARGE AIR TEMP SENSOR	BAPI	BA/10K-2-RPP-8	102 ea
RIB	RELAY	FUNCTIONAL DEVICES	RIBU1C	102 ea
RIBX	CURRENT SWITCH	FUNCTIONAL DEVICES	RIBXKF	102 ea
TR-50	TRANSFORMER, 120/24VAC, 50VA	FUNCTIONAL DEVICES	TR50VA002	102 ea
ZN551	CONTROL MODULE	AUTOMATED LOGIC	ZN551	102 ea
ZNT	ZONE TEMPERATURE SENSOR	AUTOMATED LOGIC	RS PLUS	102 ea

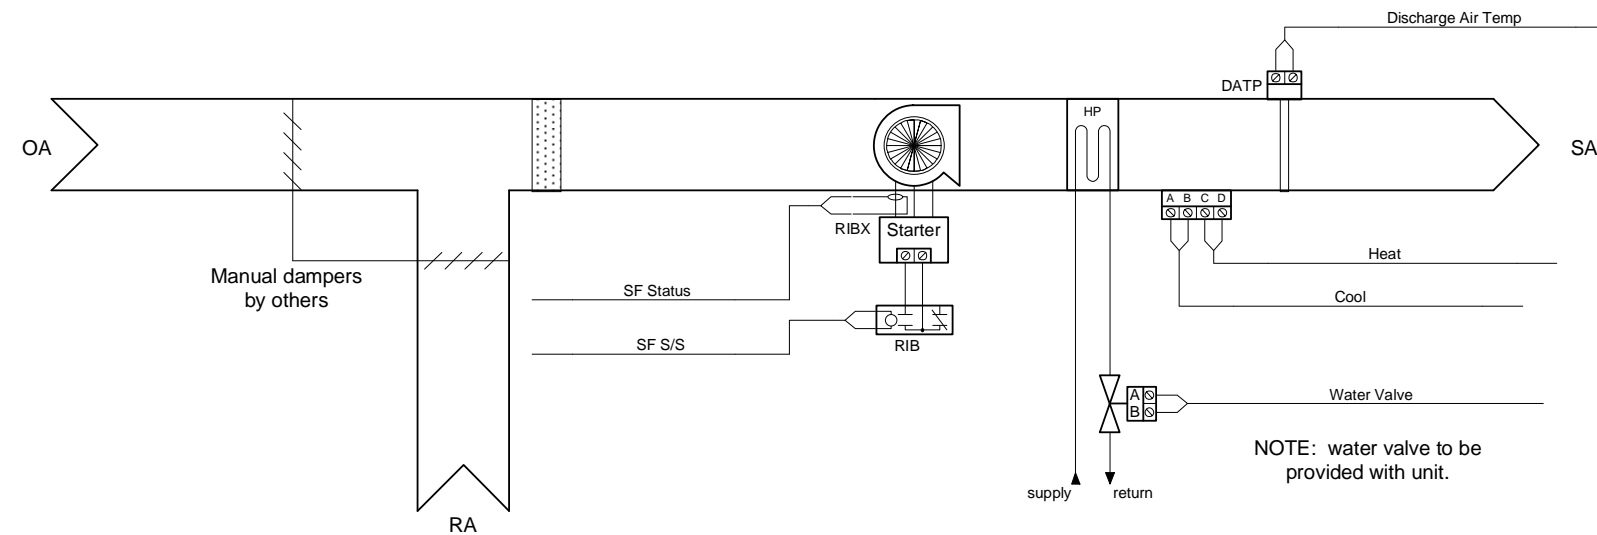

General Notes:

All ARC156 wiring shall be 22AWG single twisted pair, low capacitance (12.5pF/ft), shielded, plenum rated cable. ALC recommends Magnum Cable Corporation Product number A3ARC156.

Each ARC156 segment must be wired in a daisy chain configuration. Branching requires the use of a REP485.

Each ARC156 segment should have one (1) PROT485 installed to provide protection from electrical surges.


Each ARC156 segment end must be terminated with a TERM485 (120 ohm) terminating resistor.

The ARC156 network segment must have at least one (1) DIAG485 installed to supply bias.


Do not strip back shielded cable sheath more than 1" in order to keep twisted pair from separating. Do not ground shield to the panel or chassis ground. The shield should only be connected to the "Optional Shield" connection at a module.

Routing of communications cabling and control module locations shall be field verified.





DCMO BOCES - Phase 1&2 AS BUILT			
Norwich / Masonville, New York			
Air Temp Heating & Air Conditioning, Inc.			
HPHarold South Stairs Upper			
REV: 1	As-Built	11/19/2007	JOB NO: P7425-7290
			CHECK BY: RSL
			DSCODE:
53 of 69			

MAU - HC

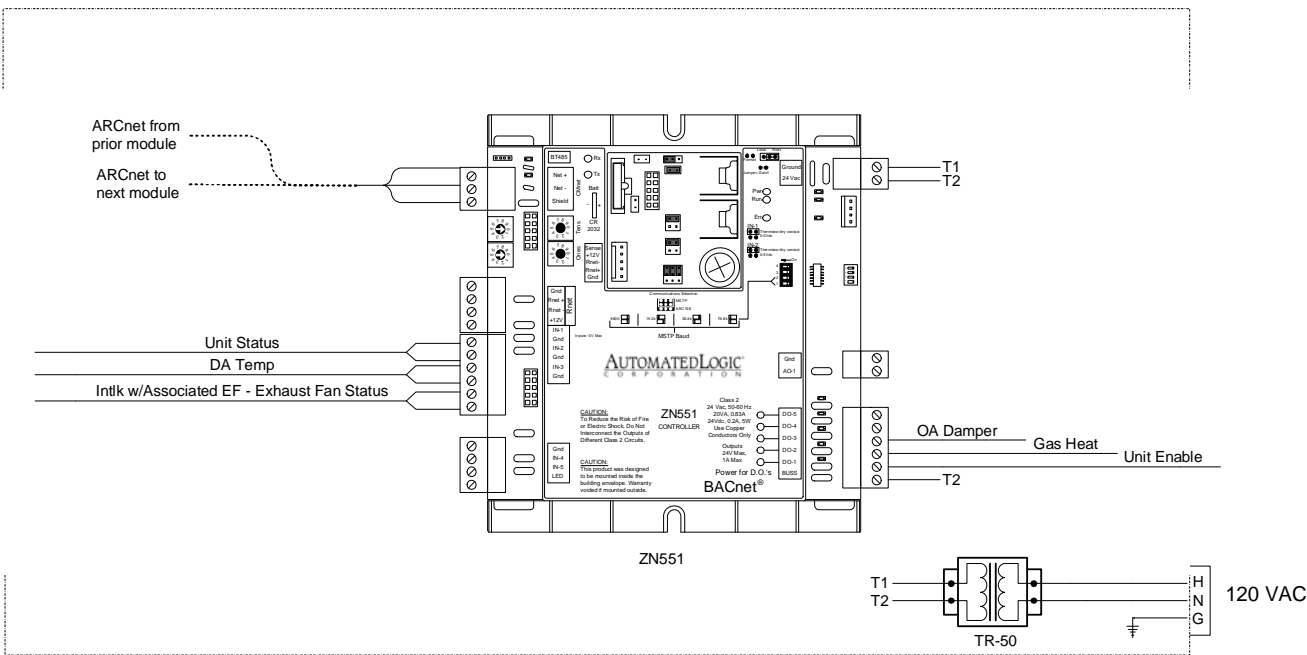

Bill of Materials				
DID	DESCRIPTION	MANUFACTURER	PART NUMBER	QTY
DAT	DA TEMP SENSOR	BAPI	BA/10K-2-D-12	4 ea
HTL	HIGH TEMP SENSOR	SIEMENS	141-0530	4 ea
OAD	DAMPER ACTUATOR	BELIMO	NF24-US	4 ea
RIB	RELAY	FUNCTIONAL DEVICES	RIBU1C	4 ea
RIBX	CURRENT SWITCH	FUNCTIONAL DEVICES	RIBXKF	4 ea
TR-50	TRANSFORMER, 120/24VAC, 50VA	FUNCTIONAL DEVICES	TR50VA002	4 ea
ZN551	CONTROL MODULE	AUTOMATED LOGIC	ZN551	4 ea

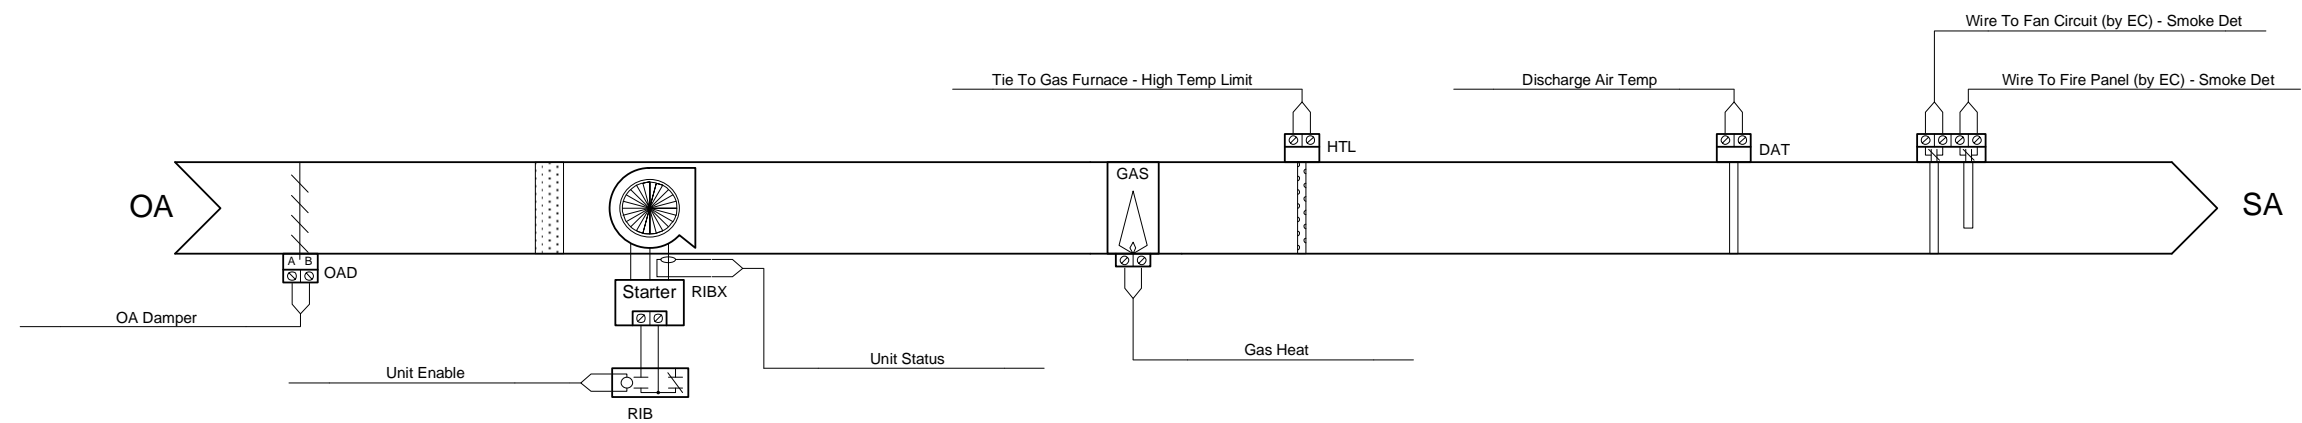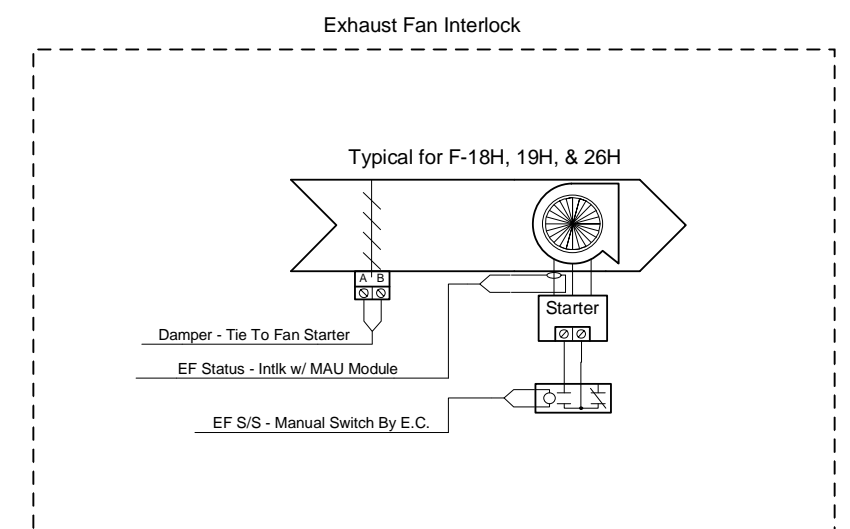


General Notes:
 All ARC156 wiring shall be 22AWG single twisted pair, low capacitance (12.5pF/ft), shielded, plenum rated cable. ALC recommends Magnum Cable Corporation Product number A3ARC156.
 Each ARC156 segment must be wired in a daisy chain configuration. Branching requires the use of a REP485.
 Each ARC156 segment should have one (1) PROT485 installed to provide protection from electrical surges.
 Each ARC156 segment end must be terminated with a TERM485 (120 ohm) terminating resistor.
 The ARC156 network segment must have at least one (1) DIAG485 installed to supply bias.
 Do not strip back shielded cable sheath more than 1" in order to keep twisted pair from separating. Do not ground shield to the panel or chassis ground. The shield should only be connected to the "Optional Shield" connection at a module.
 Routing of communications cabling and control module locations shall be field verified.




DCMO BOCES - Phase 1&2 AS BUILT			
Norwich / Masonville, New York			
Air Temp Heating & Air Conditioning, Inc.			
MAU - HC			
REV: 1	As-Built	11/19/2007	JOB NO: P7425-7290
			CHECK BY: RSL
			DSCODE:
54 of 69			

HRU - 3H

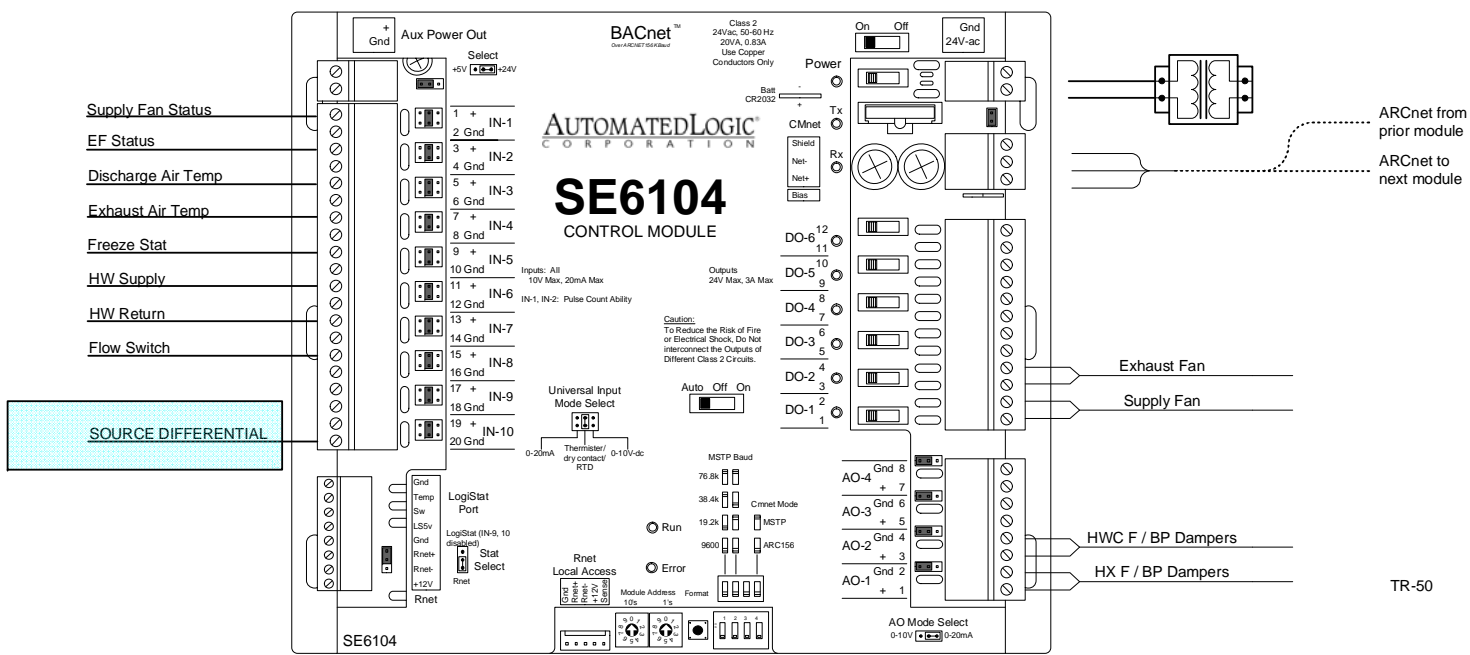

Bill of Materials				
DID	DESCRIPTION	MANUFACTURER	PART NUMBER	QTY
DA-B	SR PROPORTIONAL 133 IN-LB 2-10VDC	BELIMO	AF24-SR ALC	2 ea
DAT	DA TEMP SENSOR	BAPI	BA/10K-2-D-12	3 ea
DP	DIF WET	SETRA	SETRA	1 ea
IMMS	IMMERSON TEMP SENSOR	BAPI	BA/10K-2-I-2	2 ea
RIB	RELAY	FUNCTIONAL DEVICES	RIBU1C	2 ea
RIBX	CURRENT SWITCH	FUNCTIONAL DEVICES	RIBXKF	4 ea
SE6104	SE6104	AUTOMATED LOGIC	SE6104	1 ea
TR-50	TRANSFORMER, 120/24VAC, 50VA	FUNCTIONAL DEVICES	TR50VA002	1 ea
WELS	IMMERSON TEMP SENSOR WELL	BAPI	BA/2	2 ea

MASONVILLE

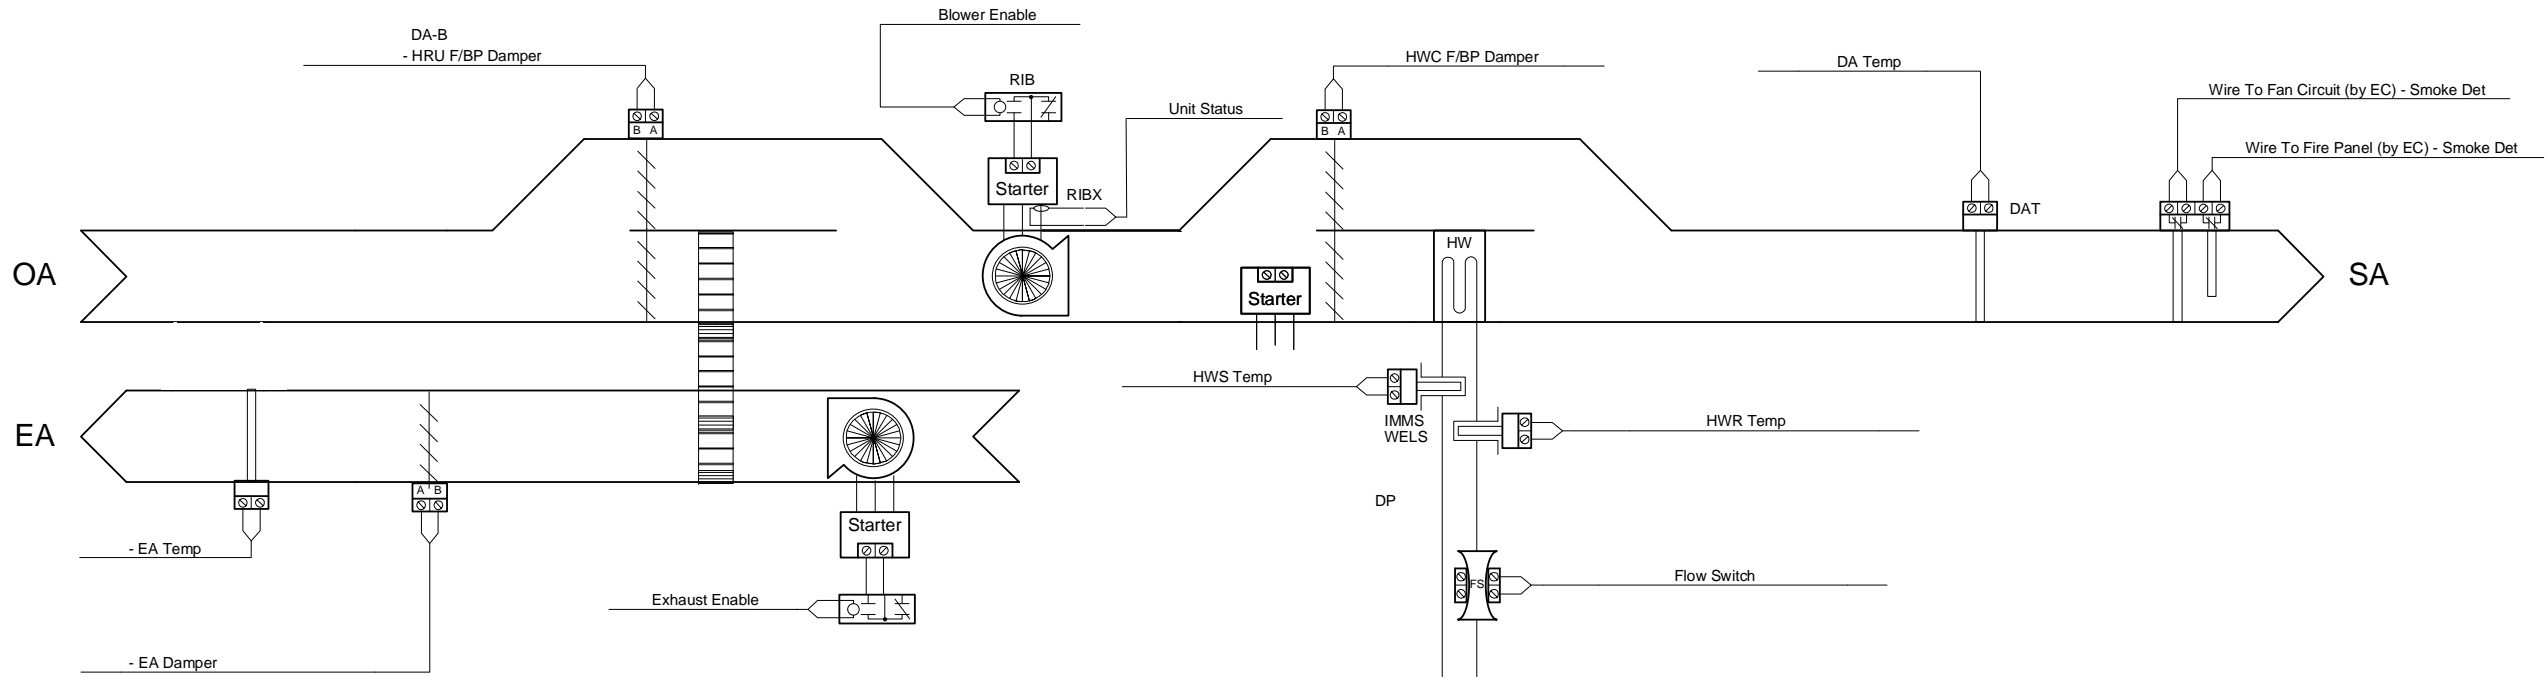

DCMO BOCES - Phase 1&2 AS BUILT
 Norwich / Masonville, New York

Air Temp Heating & Air Conditioning, Inc.


HRU - 3H

REV: 1	As-Built	11/19/2007	JOB NO: P7425-7290
CHECK BY: RSL			DSCODE:

AIR TEMP HEATING & AIR CONDITIONING, INC.
 A LINC SERVICE © CONTRACTOR


55 of 69

HRU - 6H&4H

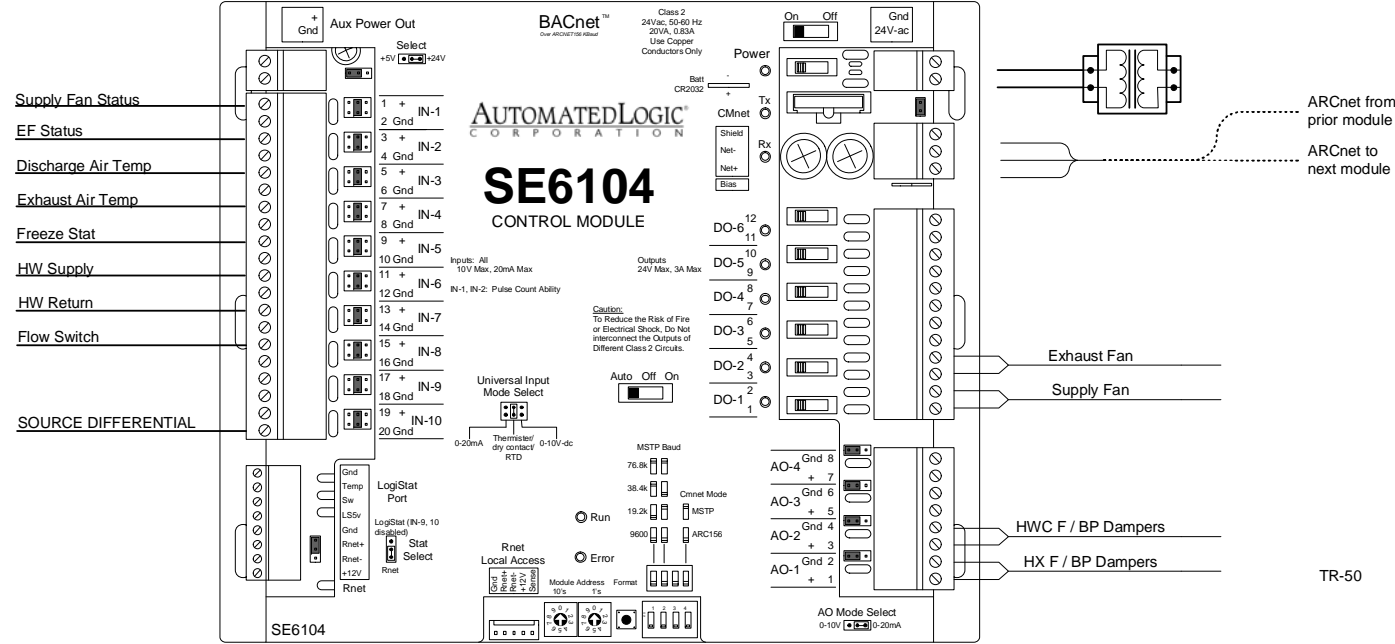

Bill of Materials				
DID	DESCRIPTION	MANUFACTURER	PART NUMBER	QTY
DA-B	SR PROPORTIONAL 133 IN-LB 2-10VDC	BELIMO	AF24-SR ALC	4 ea
DAT	DA TEMP SENSOR	BAPI	BA/10K-2-D-12	6 ea
IMMS	IMMERSION TEMP SENSOR	BAPI	BA/10K-2-I-2	4 ea
RIB	RELAY	FUNCTIONAL DEVICES	RIBU1C	4 ea
RIBX	CURRENT SWITCH	FUNCTIONAL DEVICES	RIBXKF	4 ea
SE6104	SE6104	AUTOMATED LOGIC	SE6104	2 ea
TR-50	TRANSFORMER, 120/24VAC, 50VA	FUNCTIONAL DEVICES	TR50VA002	2 ea
WELS	IMMERSION TEMP SENSOR WELL	BAPI	BA/2	4 ea

MASONVILLE

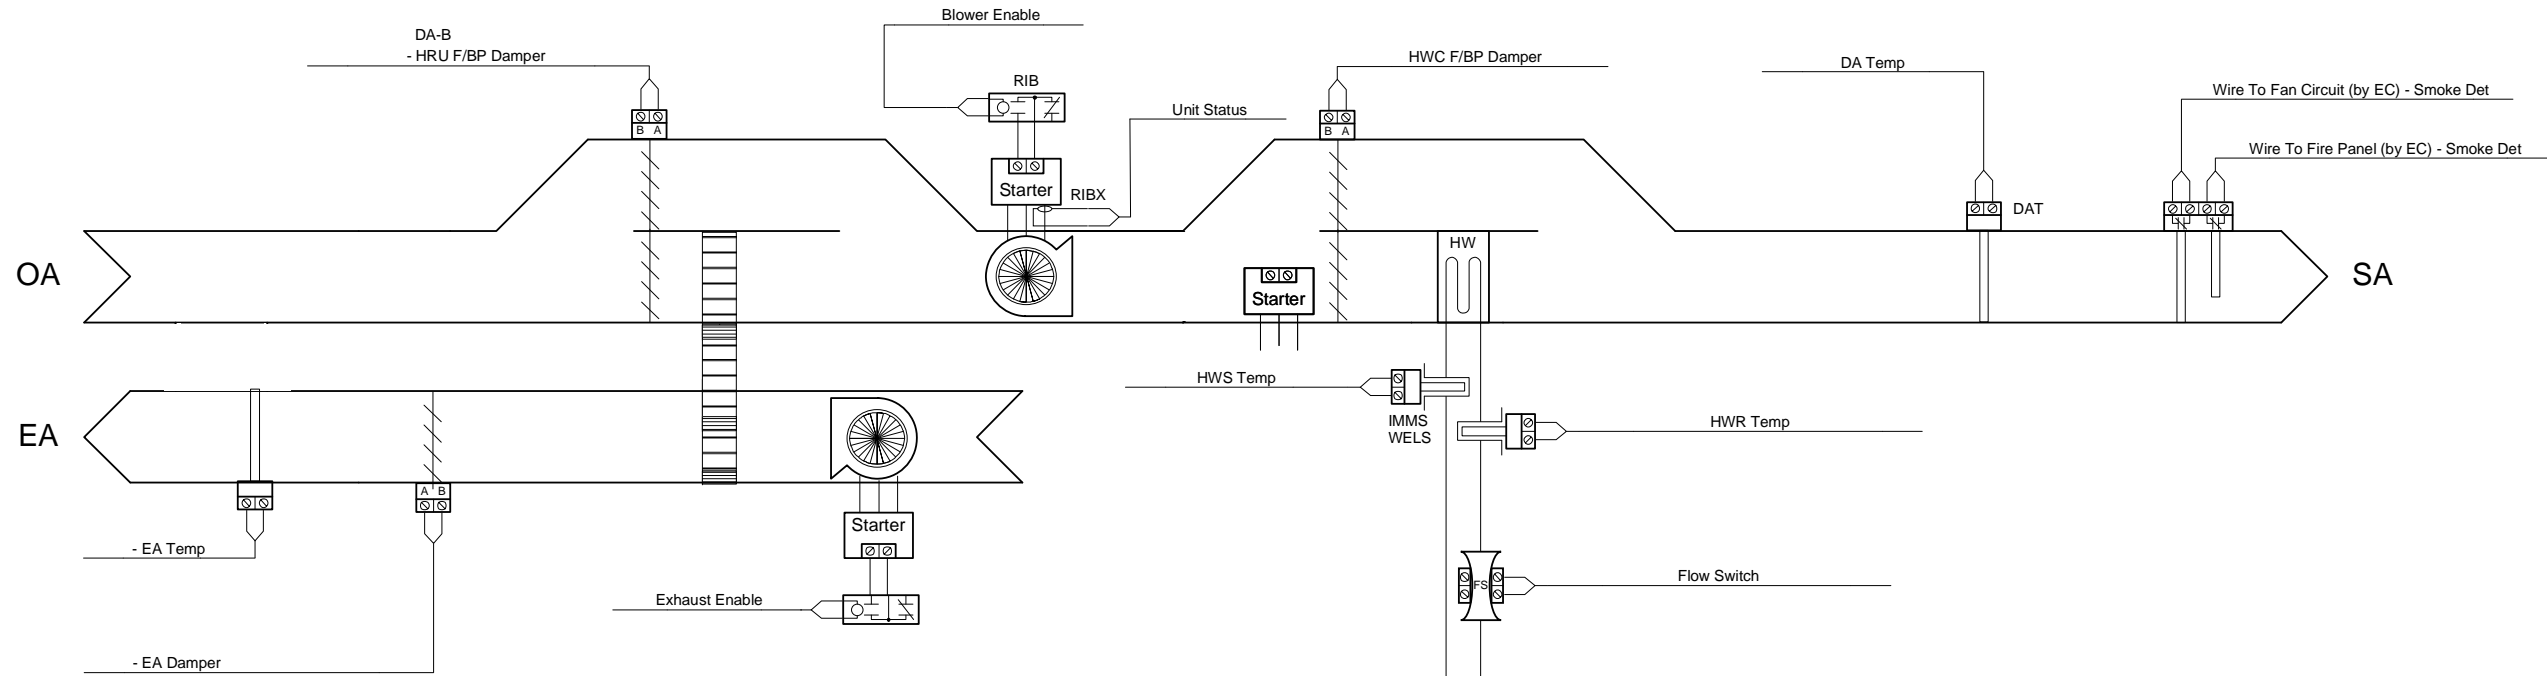

DCMO BOCES - Phase 1&2 AS BUILT
Norwich / Masonville, New York

Air Temp Heating & Air Conditioning, Inc.


HRU - 6H&4H

REV: 1	As-Built	11/19/2007	JOB NO: P7425-7290
			CHECK BY: RSL
			DSCODE:

56 of 69




HRU - 5H

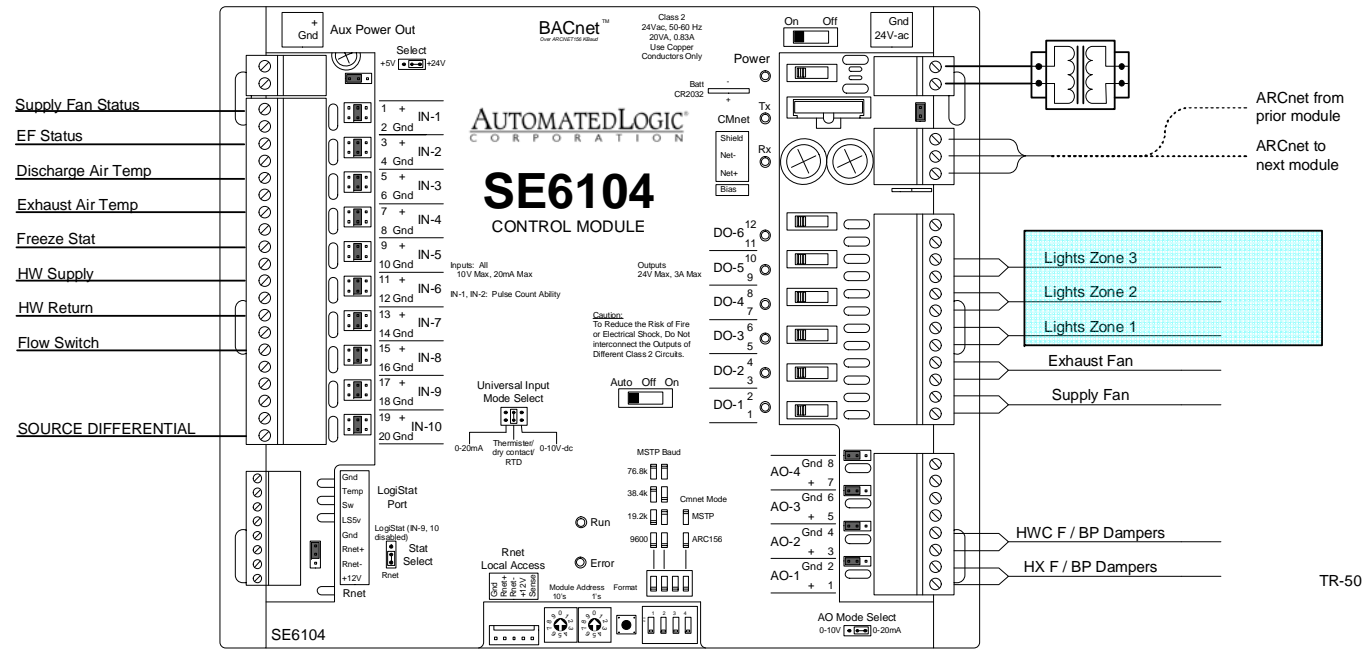

Bill of Materials				
DID	DESCRIPTION	MANUFACTURER	PART NUMBER	QTY
DA-B	SR PROPORTIONAL 133 IN-LB 2-10VDC	BELIMO	AF24-SR ALC	2 ea
DAT	DA TEMP SENSOR	BAPI	BA/10K-2-D-12	3 ea
IMMS	IMMERSION TEMP SENSOR	BAPI	BA/10K-2-I-2	2 ea
RIB	RELAY	FUNCTIONAL DEVICES	RIBU1C	2 ea
RIBX	CURRENT SWITCH	FUNCTIONAL DEVICES	RIBXKF	4 ea
SE6104	SE6104	AUTOMATED LOGIC	SE6104	1 ea
TR-50	TRANSFORMER, 120/24VAC, 50VA	FUNCTIONAL DEVICES	TR50VA002	1 ea
WELS	IMMERSION TEMP SENSOR WELL	BAPI	BA/2	2 ea

MASONVILLE

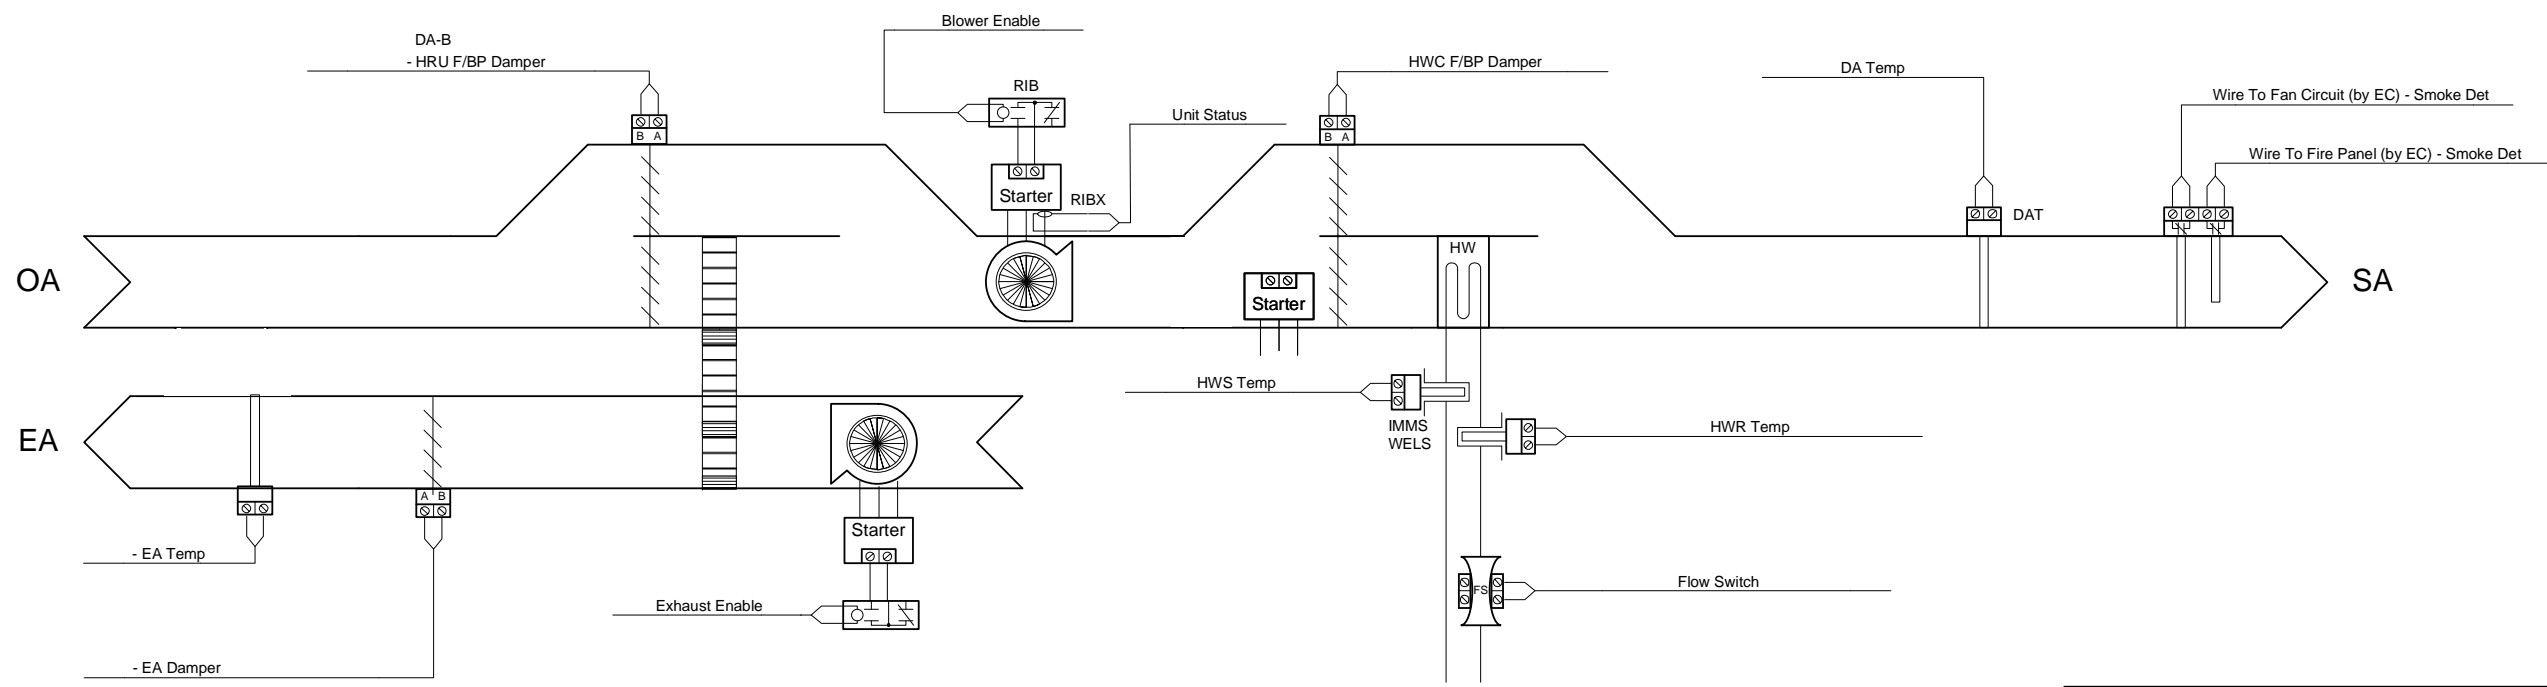

DCMO BOCES - Phase 1&2 AS BUILT
 Norwich / Masonville, New York

Air Temp Heating & Air Conditioning, Inc.

HRU - 5H

REV: 1	As-Built	11/19/2007	JOB NO: P7425-7290
CHECK BY: RSL			DSCODE:


AIR TEMP HEATING & AIR CONDITIONING, INC.
 A LINC SERVICE CONTRACTOR

57 of 69


HRU 7H GYM SOUTH

Bill of Materials

DID	DESCRIPTION	MANUFACTURER	PART NUMBER	QTY
DA-B	SR PROPORTIONAL 133 IN-LB 2-10VDC	BELIMO	AF24-SR ALC	2 ea
DAT	DA TEMP SENSOR	BAPI	BA/10K-2-D-12	3 ea
IMMS	IMMERSION TEMP SENSOR	BAPI	BA/10K-2-I-2	2 ea
RIB	RELAY	FUNCTIONAL DEVICES	RIBU1C	2 ea
RIBX	CURRENT SWITCH	FUNCTIONAL DEVICES	RIBXKF	4 ea
SE6104	SE6104	AUTOMATED LOGIC	SE6104	1 ea
TR-50	TRANSFORMER, 120/24VAC, 50VA	FUNCTIONAL DEVICES	TR50VA002	1 ea
WELS	IMMERSION TEMP SENSOR WELL	BAPI	BA/2	2 ea

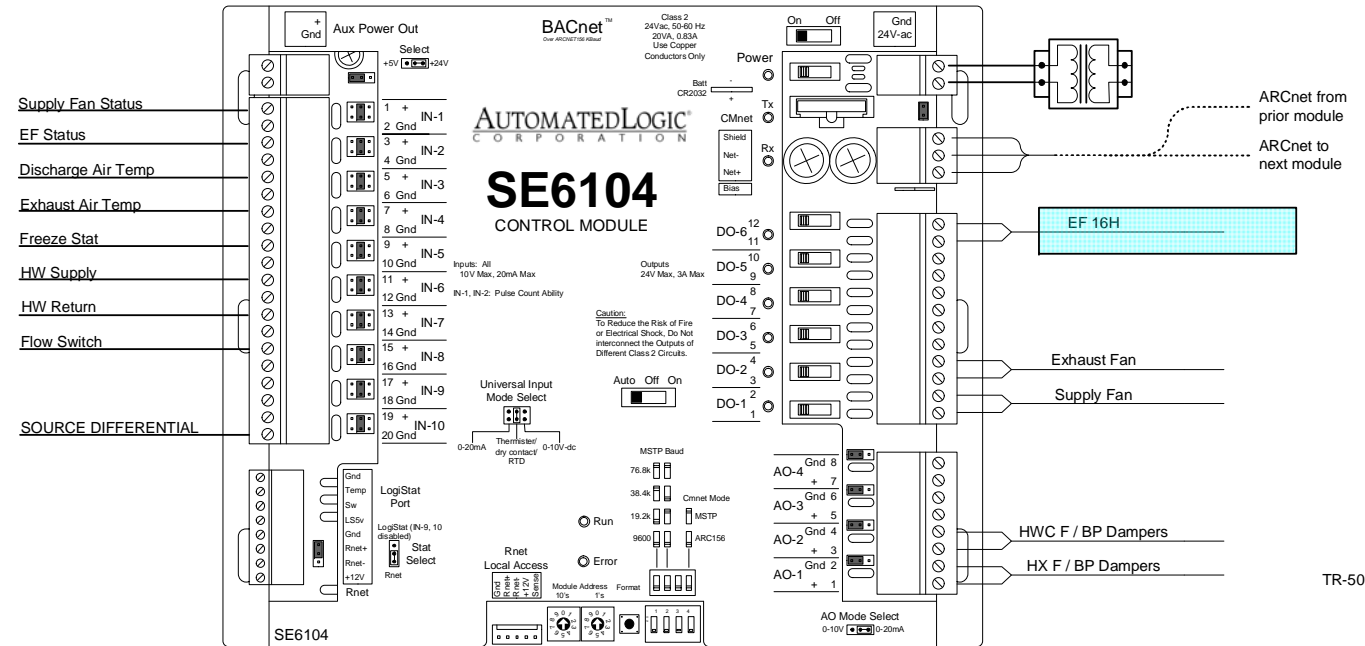


MASONVILLE

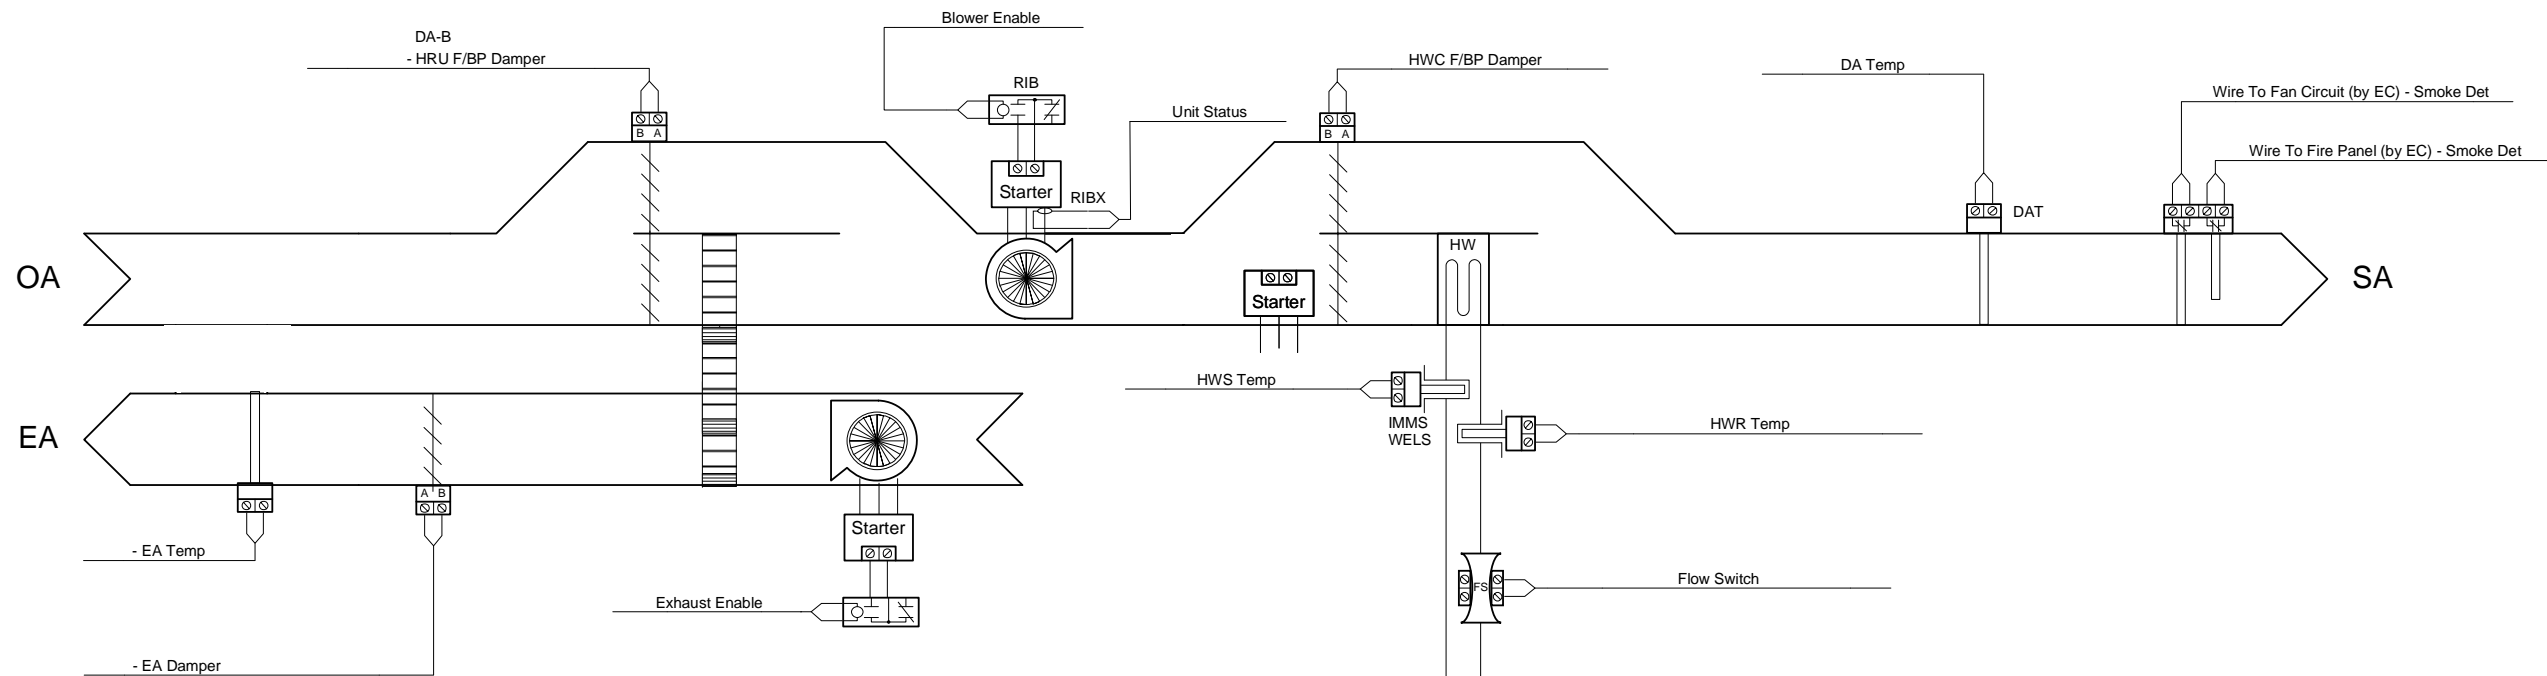

DCMO BOCES - Phase 1&2 AS BUILT			
Norwich / Masonville, New York			
Air Temp Heating & Air Conditioning, Inc.			
HRU 7H GYM SOUTH			
REV: 1	As-Built	11/19/2007	JOB NO: P7425-7290
			CHECK BY: RSL
			DSCODE:
			58 of 69




HRU 8H GYM NORTH

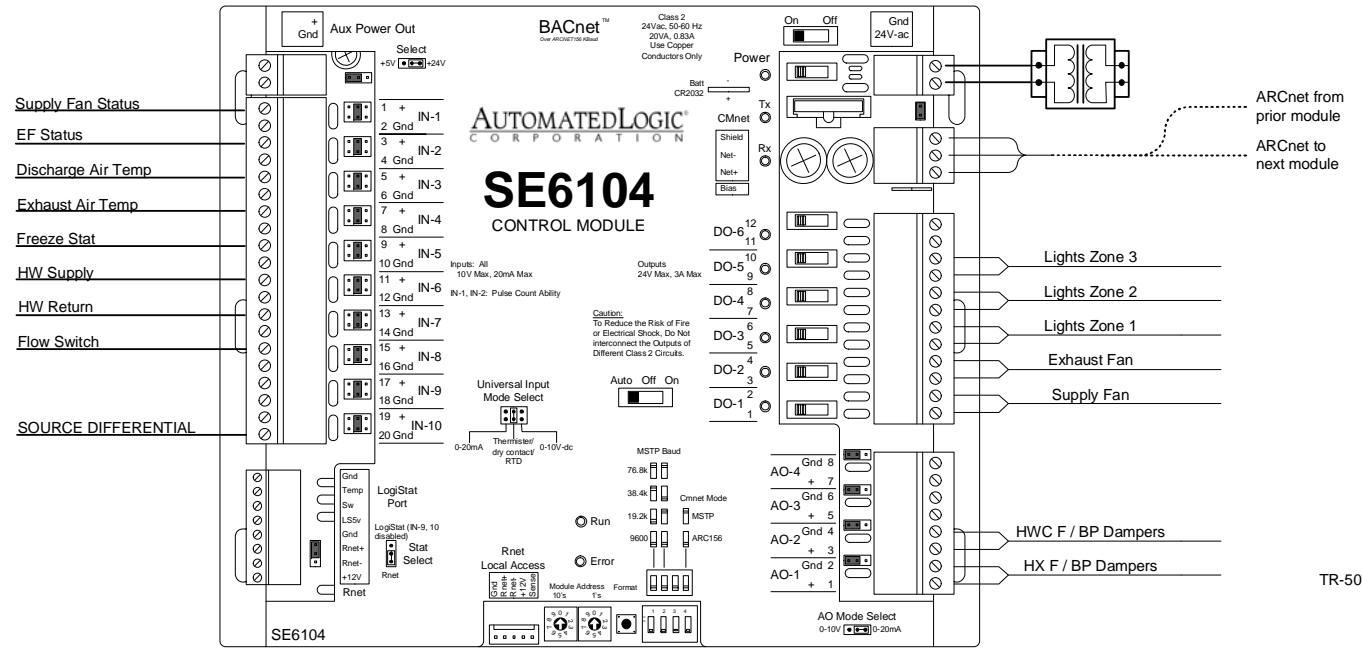

Bill of Materials				
DID	DESCRIPTION	MANUFACTURER	PART NUMBER	QTY
DA-B	SR PROPORTIONAL 133 IN-LB 2-10VDC	BELIMO	AF24-SR ALC	2 ea
DAT	DA TEMP SENSOR	BAPI	BA/10K-2-D-12	3 ea
IMMS	IMMERSION TEMP SENSOR	BAPI	BA/10K-2-I-2	2 ea
RIB	RELAY	FUNCTIONAL DEVICES	RIBU1C	2 ea
RIBX	CURRENT SWITCH	FUNCTIONAL DEVICES	RIBXKF	4 ea
SE6104	SE6104	AUTOMATED LOGIC	SE6104	1 ea
TR-50	TRANSFORMER, 120/24VAC, 50VA	FUNCTIONAL DEVICES	TR50VA002	1 ea
WELS	IMMERSION TEMP SENSOR WELL	BAPI	BA/2	2 ea

MASONVILLE

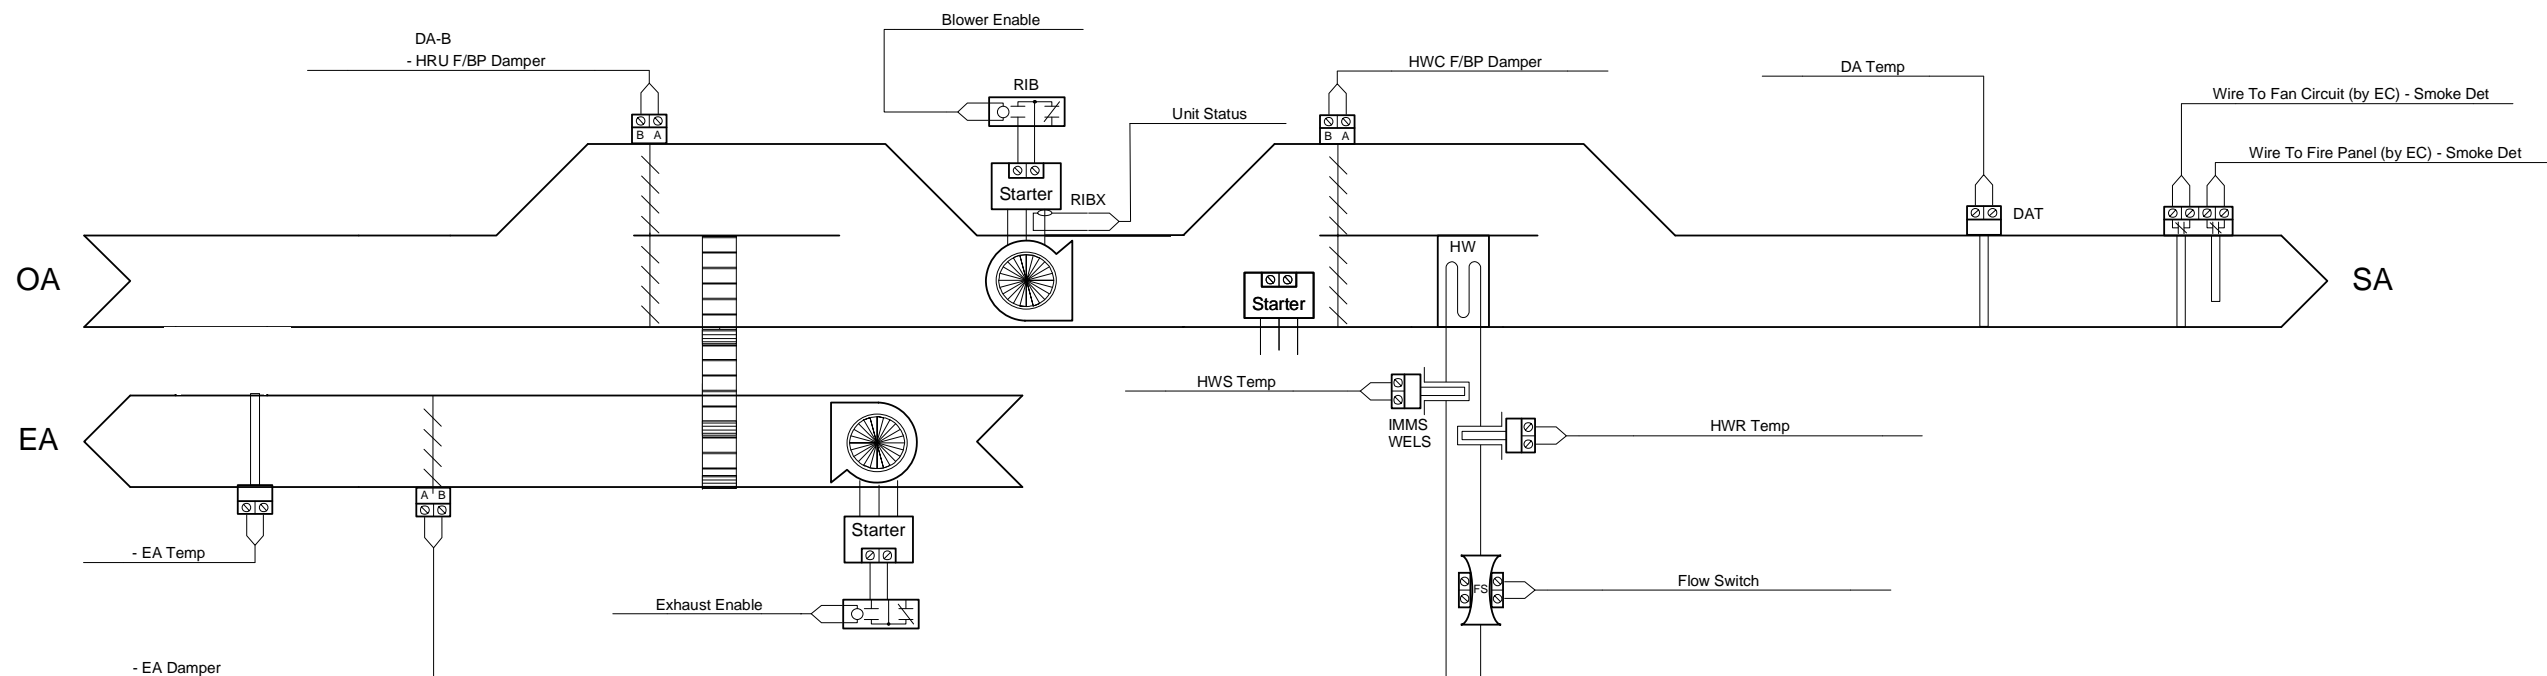

DCMO BOCES - Phase 1&2 AS BUILT
Norwich / Masonville, New York


Air Temp Heating & Air Conditioning, Inc.

HRU 8H GYM NORTH


REV: 1	As-Built	11/19/2007	JOB NO: P7425-7290
CHECK BY: RSL			DSCODE:

59 of 69

AHU 1H MSN

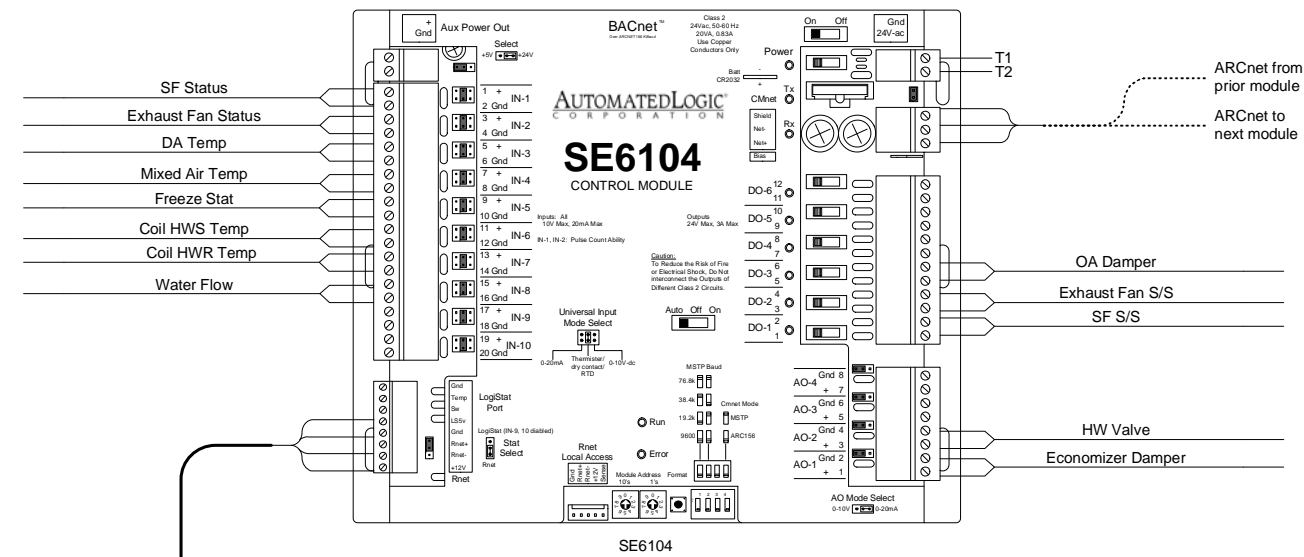

Network 1 Address 26

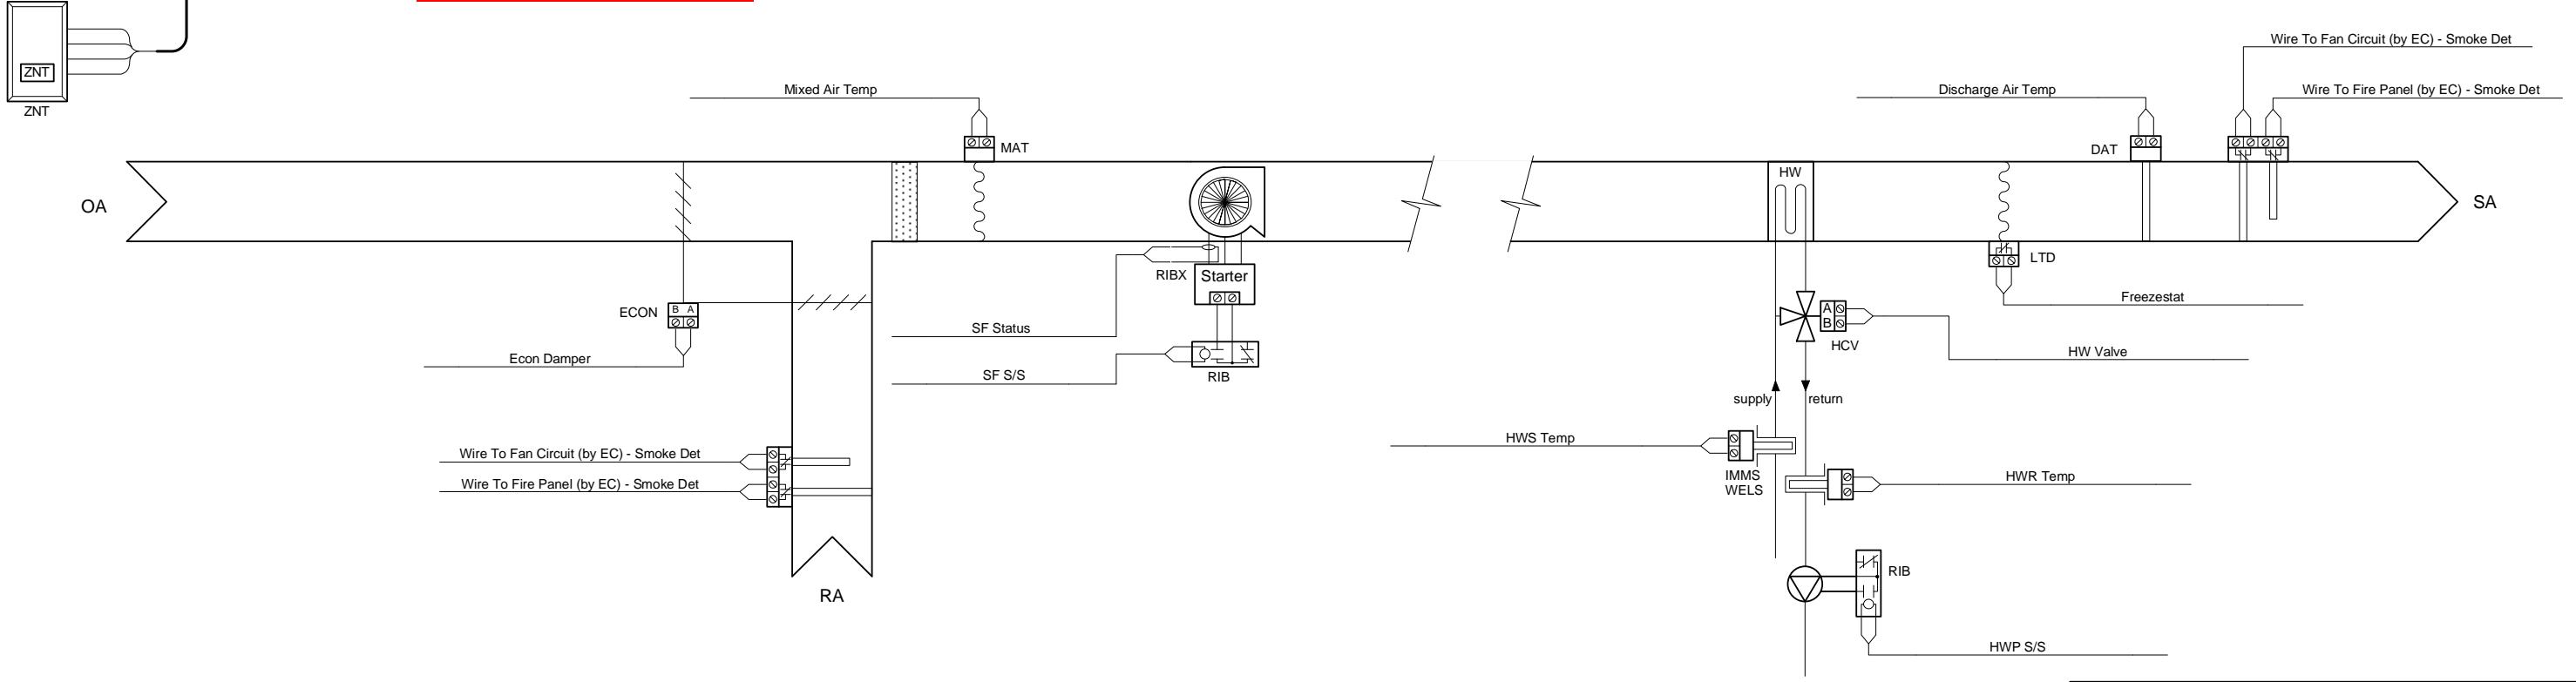

MASONVILLE

Bill of Materials

DID	DESCRIPTION	MANUFACTURER	PART NUMBER	QTY
DAT	DISCHARGE AIR TEMP SENSOR	BAPI	BA/10K-2-D-12	1 ea
ECON	DAMPER ACTUATOR	BELIMO	AF24-SR US	1 ea
HCV	HEATING CONTROL VALVE	BELIMO	SEE VALVE SCHEDULE	7 ea
IMMS	IMMERSSION TEMP SENSOR	BAPI	BA/10K-2-I-2	2 ea
LTD	LOW AIR TEMP SENSOR	SIEMENS	134-1510	1 ea
MAT	MIXED AIR TEMP SENSOR	BAPI	BA/10K-2-A-12	1 ea
RIB	RELAY	FUNCTIONAL DEVICES	RIBU1C	2 ea
RIBX	CURRENT SWITCH	FUNCTIONAL DEVICES	RIBXKF	1 ea
SE6104	CONTROL MODULE	AUTOMATED LOGIC	SE6104	3 ea
WELS	IMMERSSION TEMP SENSOR WELL	BAPI	BA/2	2 ea
ZNT	ZONE TEMPERATURE SENSOR	AUTOMATED LOGIC	RS PLUS	1 ea

DCMO BOCES - Phase 1&2 AS BUILT

Norwich / Masonville, New York

Air Temp Heating & Air Conditioning, Inc.

AHU 1H MSN


REV: 1	As-Built	11/19/2007	JOB NO: P7425-7290
--------	----------	------------	--------------------

CHECK BY: RSL
DSCODE:




AIR TEMP HEATING & AIR CONDITIONING, INC.
A LINC SERVICE © CONTRACTOR

UV - HC ZN 551

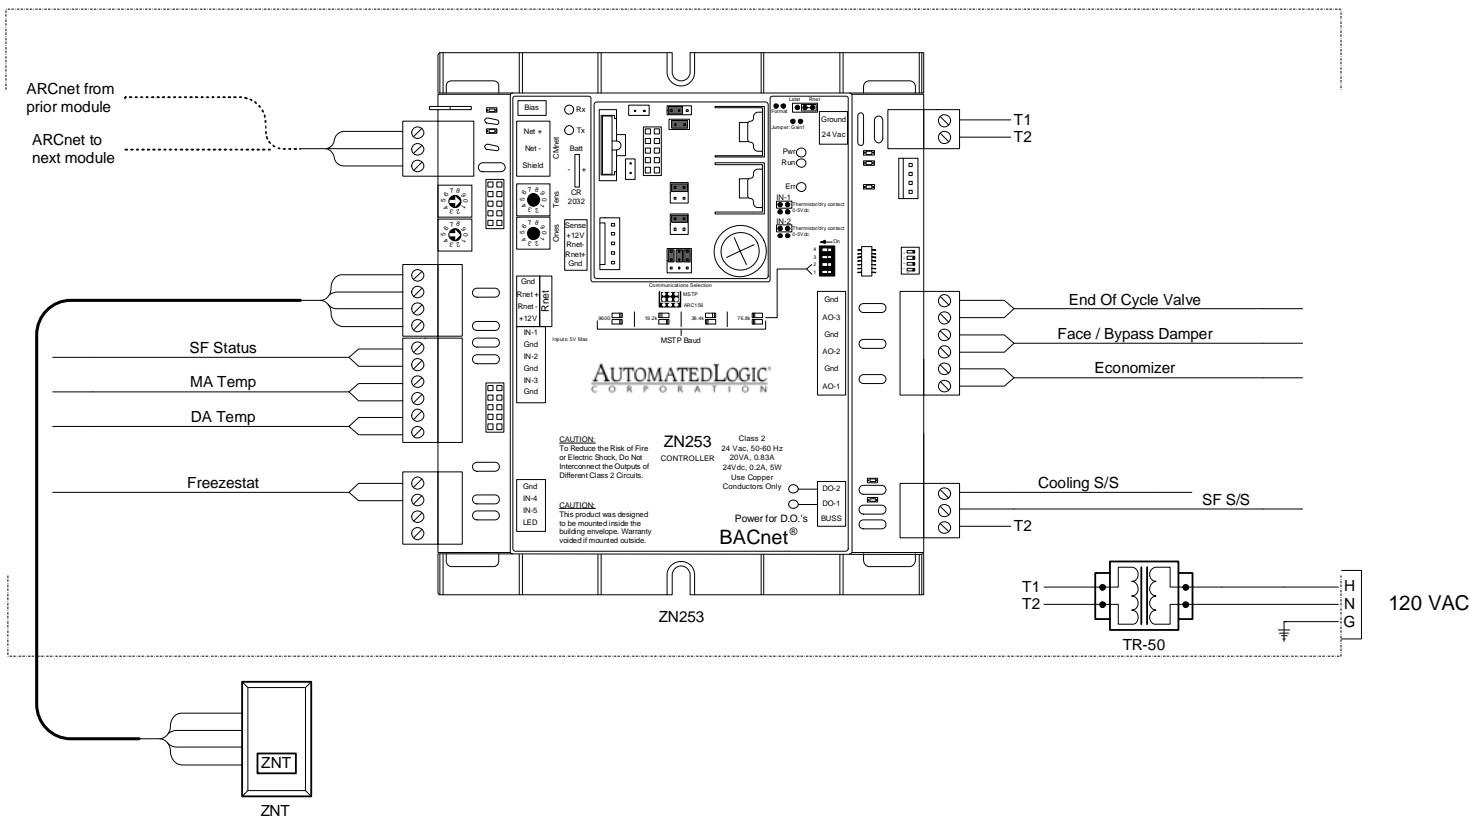

Bill of Materials				
DID	DESCRIPTION	MANUFACTURER	PART NUMBER	QTY
DATP	DISCHARGE AIR TEMP SENSOR	BAPI	BA/10K-2-RPP-8	3 ea
ECON	DAMPER ACTUATOR	BELIMO	LF24-SR US	3 ea
EOCV	CONTROL VALVE	BELIMO	SEE VALVE SCHEDULE	3 ea
F/BP	DAMPER ACTUATOR	BELIMO	LF24-SR US	3 ea
LTD	FREEZESTAT	SIEMENS	134-1510	3 ea
MAT	DUCT AVERAGING SENSOR	BAPI	BA/10K-2-A-12	3 ea
RIB	RELAY	FUNCTIONAL DEVICES	RIBU1C	3 ea
RIBX	CURRENT SWITCH	FUNCTIONAL DEVICES	RIBXKF	3 ea
TR-50	TRANSFORMER, 120/24VAC, 50VA	FUNCTIONAL DEVICES	TR50VA002	3 ea
ZN253	CONTROL MODULE	AUTOMATED LOGIC	ZN253	3 ea
ZNT	ZONE TEMPERATURE SENSOR	AUTOMATED LOGIC	RS PLUS	3 ea


UV 1H ENGINEERING TECH 2403-43
 UV 3H AUTO TECH 2403-40
 UV AUTO REFINISHING 2403-45
 UV B 401 2403-44

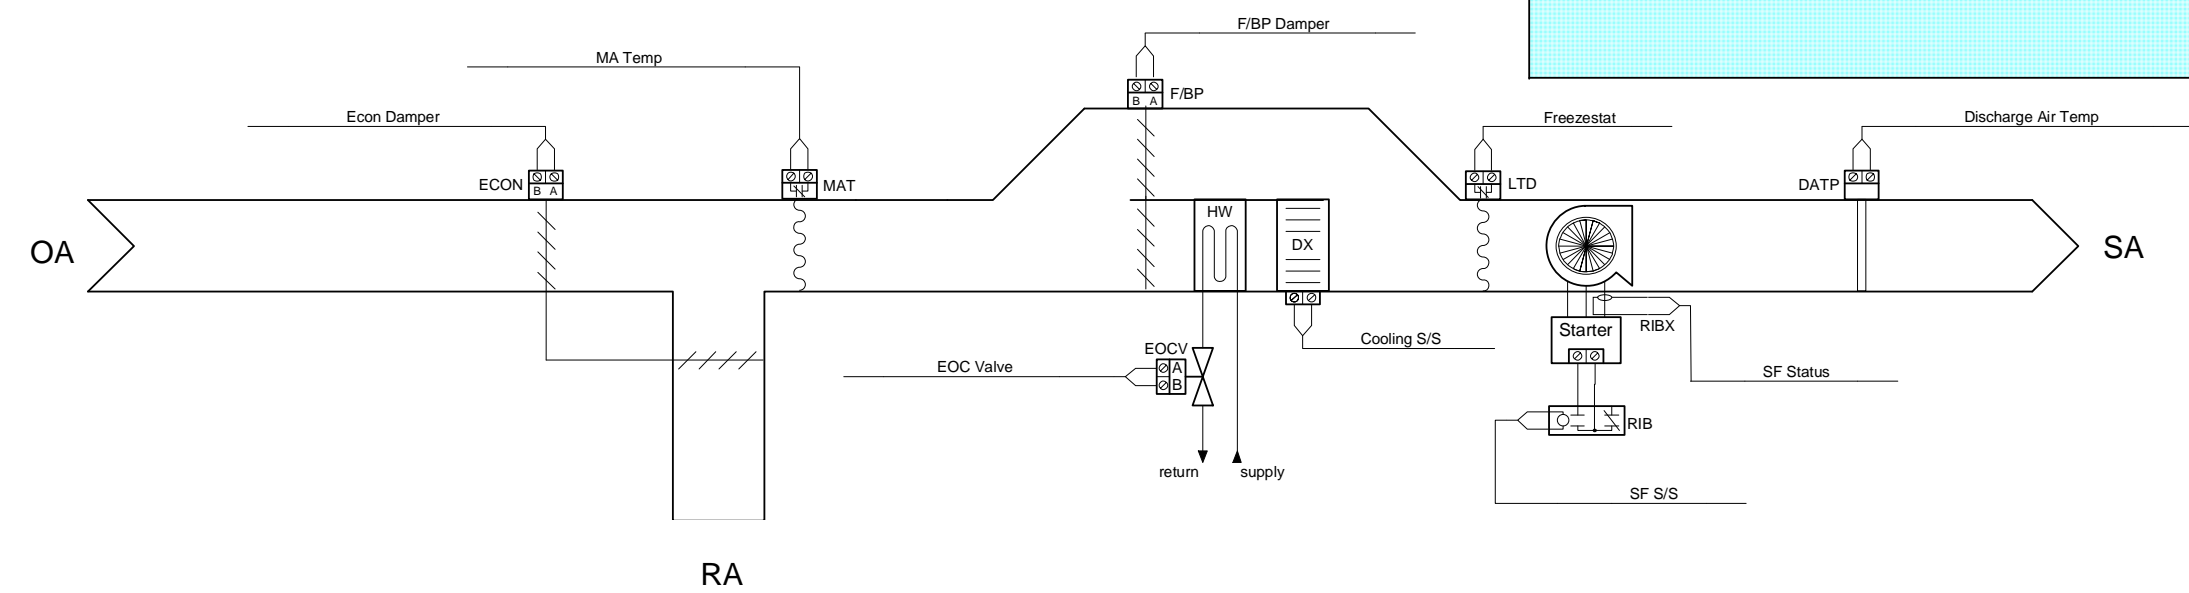



General Notes:
 All ARC156 wiring shall be 22AWG single twisted pair, low capacitance (12.5pF/ft), shielded, plenum rated cable. ALC recommends Magnum Cable Corporation Product number A3ARC156.
 Each ARC156 segment must be wired in a daisy chain configuration. Branching requires the use of a REP485.
 Each ARC156 segment should have one (1) PROT485 installed to provide protection from electrical surges.
 Each ARC156 segment end must be terminated with a TERM485 (120 ohm) terminating resistor.
 The ARC156 network segment must have at least one (1) DIAG485 installed to supply bias.
 Do not strip back shielded cable sheath more than 1" in order to keep twisted pair from separating. Do not ground shield to the panel or chassis ground. The shield should only be connected to the "Optional Shield" connection at a module.
 Routing of communications cabling and control module locations shall be field verified.

MASONVILLE

DCMO BOCES - Phase 1&2 AS BUILT
 Norwich / Masonville, New York
 Air Temp Heating & Air Conditioning, Inc.
 UV - HC ZN 551


REV: 1	As-Built	11/19/2007	JOB NO: P7425-7290
CHECK BY: RSL			DSCODE:
 AIR TEMP HEATING & AIR CONDITIONING, INC. A LINC SERVICE CONTRACTOR			61 of 69

UV-HC SE6104

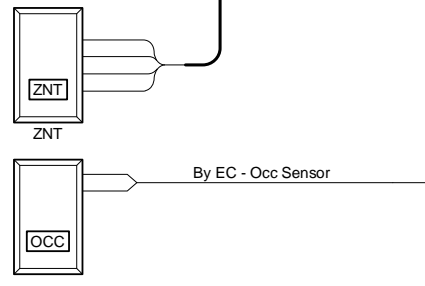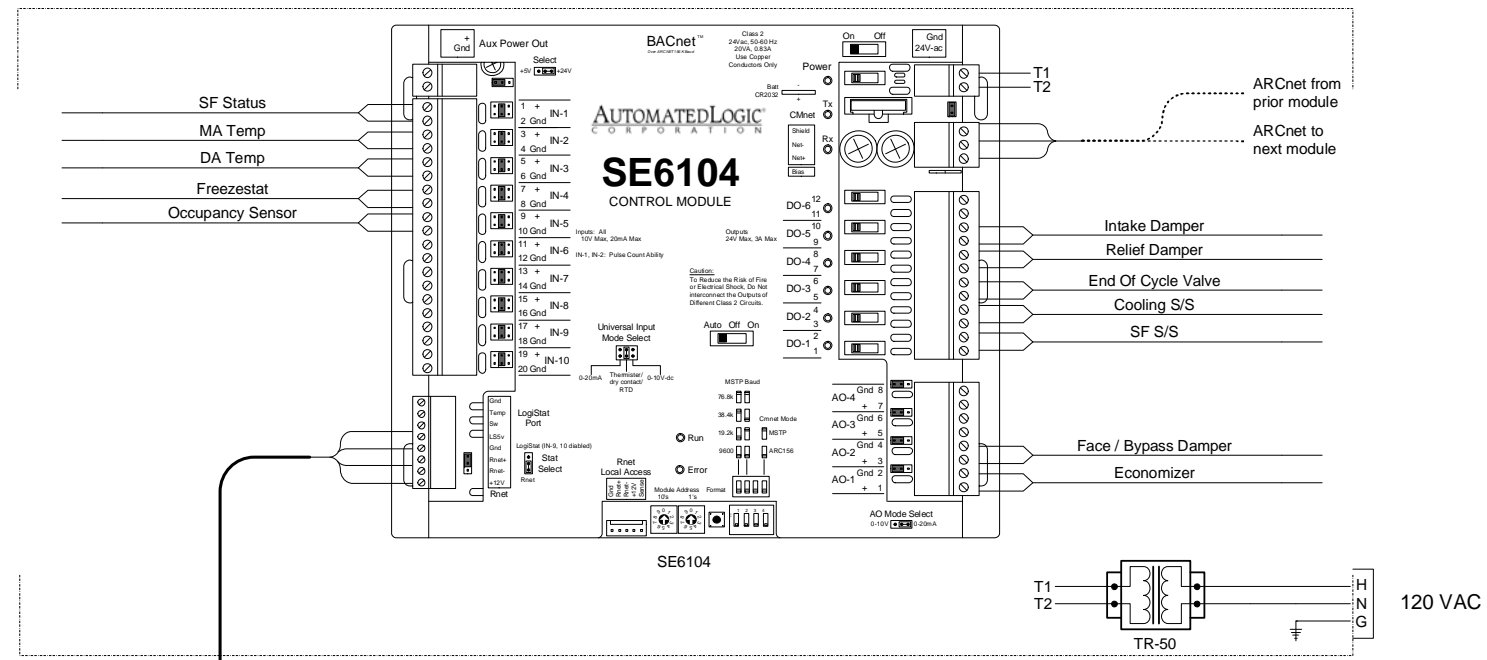

Bill of Materials				
DID	DESCRIPTION	MANUFACTURER	PART NUMBER	QTY
DATP	DISCHARGE AIR TEMP SENSOR	BAPI	BA/10K-2-RPP-8	5 ea
ECON	DAMPER ACTUATOR	BELIMO	LF24-SR US	5 ea
EOCV	CONTROL VALVE	BELIMO	B207B+TFX24	5 ea
F/BP	DAMPER ACTUATOR	BELIMO	LF24-SR US	5 ea
INTD	DAMPER ACTUATOR	BELIMO	NF24 US	5 ea
LTD	FREEZESTAT	SIEMENS	134-1510	5 ea
MAT	DUCT AVERAGING SENSOR	BAPI	BA/10K-2-A-12	5 ea
RELD	DAMPER ACTUATOR	BELIMO	NF24 US	5 ea
RIB	RELAY	FUNCTIONAL DEVICES	RIBU1C	5 ea
RIBX	CURRENT SWITCH	FUNCTIONAL DEVICES	RIBXKF	5 ea
SE6104	CONTROL MODULE	AUTOMATED LOGIC	SE6104	5 ea
TR-50	TRANSFORMER, 120/24VAC, 50VA	FUNCTIONAL DEVICES	TR50VA002	5 ea
ZNT	ZONE TEMPERATURE SENSOR	AUTOMATED LOGIC	RS PLUS	5 ea

UV GREENHOUSE MANAGEMENT 2403-11
 UV 3H EGUIP TECH 2403-10
 UV CONSERVATION 2403-09
 UV WELD SHOP 2403-08
 UV BUILDINGS AND TRADES 2403-07

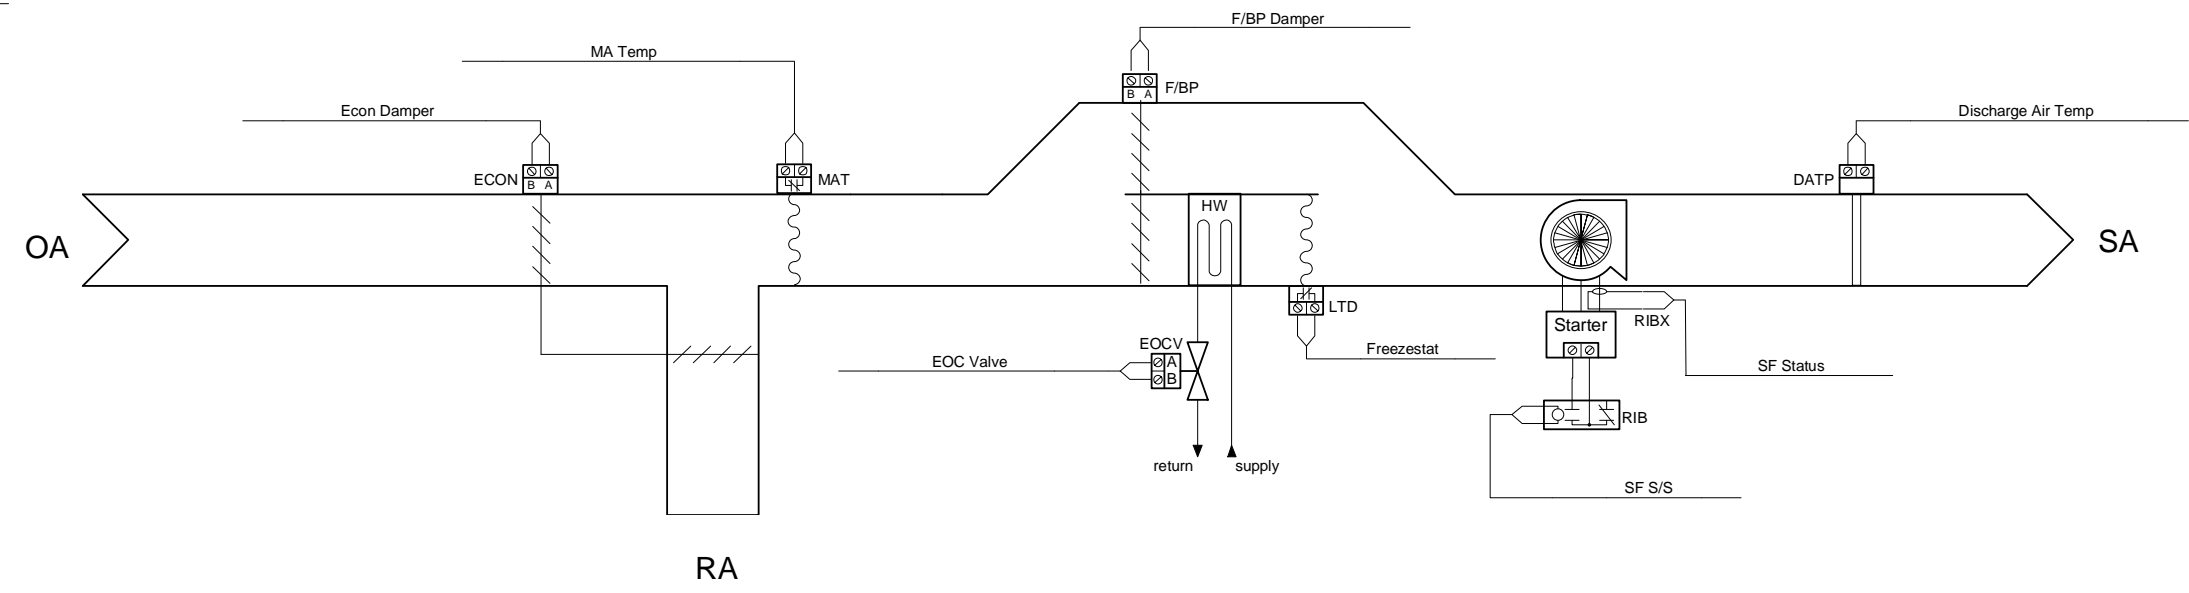

DCMO BOCES - Phase 1&2 AS BUILT			
Norwich / Masonville, New York			
Air Temp Heating & Air Conditioning, Inc.			
UV-HC SE6104			
REV: 1	As-Built	11/19/2007	JOB NO: P7425-7290
			CHECK BY: RSL
			DSCODE:
62 of 69			

NETWORKED EF'S HAROLD



DCMO BOCES - Phase 1&2 AS BUILT

Norwich / Masonville, New York

Air Temp Heating & Air Conditioning, Inc.

NETWORKED EF'S HAROLD

REV: 1	As-Built	11/19/2007	JOB NO: P7425-7290
--------	----------	------------	--------------------

CHECK BY: RSL



DSCODE:

Sequence Of Operation-pg.1

Exhaust Fan – BAS Control:

A. General:

- Units shall be provided with field mounted controls.
- Fan shall be energized by a manual switch. BAS, on during occupied mode, off during un-occupied mode.
- Automatic damper shall open when fan energizes and shall remain closed when fan is off.

B. Control Interlock:

- When fan is energized, associated AHU/RTU/UV is to energize with outdoor air damper positioned to it's 100% open position.
- Refer to fan schedule for interlocks.

Exhaust Fan – Thermostat Control:

A. General:

- Units shall be provided with field mounted controls.
- Fan shall be energized by a thermostat.
- Automatic damper shall open when fan energizes and shall remain closed when fan is off.

B. Control Interlock:

- When fan is energized, associated AHU/RTU/UV is to energize with outdoor air damper positioned to it's 100% open position.
- Refer to fan schedule for interlocks.

Exhaust Fan – Manual Switch Control:

A. General:

- Units shall be provided with field mounted controls.
- Fan shall be energized by a manual switch.
- Automatic damper shall open when fan energizes and shall remain closed when fan is off.

B. Control Interlock:

- When fan is energized, associated AHU/RTU/UV is to energize with outdoor air damper positioned to it's 100% open position.
- Refer to fan schedule for interlocks.

Boiler Room Equipment Control:

A. General:

- All controls shall be field mounted.

B. Boiler Control:

- The boilers shall be sequenced to operate based on header mounted temperature sensor per the attached schedule. System shall be energized when outdoor air temperature is 60 degrees or below.
- Hot water temperature shall be reset linearly as follows: 170 degrees at 60 degrees OAT, and 190 degrees at 0 degrees OAT.

C. Boiler Emergency Shutdown:

- When emergency shutdown switches are broken, boilers and domestic hot water heaters shall be disabled.

D. Boiler room pumps:


- Boiler pumps shall be controlled by the BAS to run when respective boiler runs.
- P-1C or P-2C shall run with automatic standby (lead/lag) whenever heating is enabled. Pump speed shall vary to maintain a minimum 15psi at the remote differential pressure sensor.
- P-3C or P-4C shall run with automatic standby (lead/lag) whenever heating is enabled, or whenever any heat pump is scheduled to run, or overridden to run. Pump speed shall vary to maintain a minimum 15psi at the remote differential pressure sensor.
- P-5C or P-6C shall run with automatic standby (lead/lag) whenever heating is enabled, or whenever loop return temperature is below 42 degrees. Valve V-1 shall modulate to maintain a temperature of 42 degrees.
- P-7C or P-8C shall run with automatic standby (lead/lag) whenever any heat pump is enabled to run, or overridden to run, and when loop return temperature is above 65 degrees. Pump speed shall vary to maintain a bore hole loop temperature differential of 7 degrees.
- P-9C shall run whenever P-3C or P-4C run.

E. Boiler room alarms:

- Should any pump fail, or standby pump be energized due to failure of the lead pump, an alarm shall sound through the BAS.
- Should any alarm condition occur at the boiler panel, an alarm shall be sent to the BAS operator terminal.
- Should P-3C or P-4C fail to run, or flow not be sensed when any heat pump is running, an alarm shall sound and all heat pumps shall be disabled.
- Should carbon monoxide concentrations exceed 100ppm, an audible alarm shall sound, and an alarm message shall be sent to the BAS operator terminal.

F. Boiler room combustion air:

- Combustion air control panel shall start combustion air fan to introduce outside air into boiler room. Combustion air control panel shall modulate variable speed fan to maintain equalized boiler room pressure.

DCMO BOCES - Phase 1&2 AS BUILT			
Norwich / Masonville, New York			
Air Temp Heating & Air Conditioning, Inc.			
Sequence Of Operation-pg.1			
REV: 1	As-Built	11/19/2007	JOB NO: P7425-7290
 AIR TEMP HEATING & AIR CONDITIONING, INC. <small>A LINC SERVICE © CONTRACTOR</small>			CHECK BY: RSL
			DSCODE:
65 of 69			

Sequence Of Operation-pg.2

MAU Sequence:

A. General:

- Units shall be provided with field mounted controls.

B. Safeties:

- High temperature limit shall de-energize unit when 120 degree discharge air is sensed.
- Fan shutdown shall be provided by the Electrical Contractor through the BAS.

C. Occupied Cycle:

- Whenever the exhaust serving the spaces is energized, the air handling unit supply fan shall be energized with outdoor air damper fully open.
- a. Discharge air sensor shall cycle gas furnace to maintain a minimum discharge air temperature of 65 degrees.

D. Un-occupied Cycle:

- The outdoor air damper shall remain fully closed, return air damper fully open, with the gas furnace cycling in sequence with supply fan to maintain the unoccupied space temperature setpoint of 55 degrees.

AHU Sequence:

A. General:

- Units shall be provided with field mounted controls.
- Units shall be automatically indexed to heating or cooling cycle by the BAS.
- Economizer shall be disabled based on a single global system enthalpy sensor.

B. Safeties:

- High temperature limit shall de-energize unit when 120 degree discharge air is sensed.
- Low temperature limit shall de-energize unit when 37 degree discharge air is sensed.
- Fan shutdown shall be provided by the Electrical Contractor.

C. Occupied Heating Cycle:

- Supply fan shall run continuously.
- Outdoor air damper shall position to it's scheduled minimum position, with return air damper positioning reverse correspondingly. Outdoor air damper is never positioned below minimum scheduled position for ventilation purposes.
- Space sensor shall modulate heating valve to maintain occupied cycle setpoint of 72 degrees. Outdoor air & return air dampers shall modulate to reduce overheating.

- Discharge air sensor shall modulate outdoor air & return air dampers to maintain a minimum discharge air temperature of 60 degrees.
- Hot water coil pump shall operate whenever the outside air temperature is below 60 degrees.

D. Un-occupied Heating Cycle:


- The outdoor air damper shall remain fully closed, return air damper fully open, with the heating valve modulating in sequence with supply fan to maintain the unoccupied space temperature setpoint.

E. Warm-up Cycle:

- The unit shall perform an optimized warm-up prior to the start of the occupied mode.
- During the warm-up cycle, the outdoor air damper shall be closed. The unit shall modulate the heating valve and re-circulate 100% return air until the space temperature reaches the occupied temperature setpoint.

F. Exhaust Fan Interlock:

- Where called for, whenever the exhaust serving the spaces is energized, the air handling unit shall be returned to occupied mode (if not already in occupied mode) with outdoor air damper positioned to 100%. Refer to fan schedule.

DCMO BOCES - Phase 1&2 AS BUILT			
Norwich / Masonville, New York			
Air Temp Heating & Air Conditioning, Inc.			
Sequence Of Operation-pg.2			
REV: 1	As-Built	11/19/2007	JOB NO: P7425-7290
 AIR TEMP HEATING & AIR CONDITIONING, INC. <small>A LINC SERVICE © CONTRACTOR</small>			CHECK BY: RSL
			DSCODE:
			66 of 69

Sequence Of Operation-pg.3

Heat Pump Sequence:

A. General:

- Units shall be provided with field mounted controls.
- Units shall be automatically indexed to occupied or un-occupied cycle by the BAS.
- Units shall be automatically indexed to heating or cooling cycle by the BAS.
- A five degree deadband shall be maintained between heating and mechanical cooling space temperature setpoints.

B. Safeties:

- Low temperature limit shall de-energize unit when low temperature of 45 degrees is sensed.
- Factory mounted freezestat shall shut unit down when 35 degree SLR temperature is sensed at heat pump.

C. Occupied Heating Cycle:

- Supply fan shall run continuously, outdoor air damper shall be open to minimum position, valve fully open.
- Outdoor air damper shall position to it's scheduled minimum position, with return air damper positioning reverse correspondingly. Discharge temperature sensor shall modulate damper to maintain 55 degree minimum DAT.
- Space sensor shall cycle unit to maintain occupied setpoint of 72 degrees.

D. Un-occupied Heating Cycle:

- The outdoor air damper shall remain fully closed, return air damper fully open, with the unit cycling to maintain the unoccupied space temperature setpoint of 62 degrees.
- Valve shall be fully open when unit is operating.

E. Warm-up Cycle:

- The unit shall perform an optimized warm-up prior to the start of the occupied mode.
- During the warm-up cycle, the outdoor air damper shall be closed. The unit shall open the control valve 100% and re-circulate 100% return air until the space temperature reaches the occupied temperature setpoint.
- Valve shall be fully open.

F. Occupied Cooling Cycle:

- Supply fan shall run continuously, valve shall be open.
- Outdoor air damper shall position to it's scheduled minimum position, with return air damper positioning reverse correspondingly.
- Space sensor shall cycle the unit to maintain occupied cycle setpoint of 75 degrees.

G. Un-occupied Cooling Cycle:

- The outdoor air damper shall remain fully closed, return air damper fully open, with the unit cycling to maintain an un-occupied space temperature setpoint of 80 degrees.
- Valve shall be fully open when unit is operating.

H. Cool-down Cycle:

- The unit shall perform an optimized cool-down prior to the start of the occupied mode.
- During the cool-down cycle, the outdoor air damper shall be closed. The unit shall cycle and re-circulate 100% return air until the space temperature reaches the occupied temperature setpoint.
- Valve shall be fully open when unit is operating.

I. Economizer:

- Unit shall utilize outdoor air for free cooling whenever possible based on a global system enthalpy sensor.


CUH / UH Control:

A. General:

- Units shall be provided with field mounted controls.
- Aquastat shall de-energize unit when water temperature of 110 degrees or less is sensed.

B. Occupied Mode:

- The supply fan shall cycle to maintain an occupied temperature of 72 degrees.

DCMO BOCES - Phase 1&2 AS BUILT			
Norwich / Masonville, New York			
Air Temp Heating & Air Conditioning, Inc.			
Sequence Of Operation-pg.3			
REV: 1	As-Built	11/19/2007	JOB NO: P7425-7290
 AIR TEMP HEATING & AIR CONDITIONING, INC. <small>A LINC SERVICE © CONTRACTOR</small>			CHECK BY: RSL
			DSCODE:
			67 of 69

Sequence Of Operation-pg.4

Unit Ventilator Sequence:

A. General:

- Units shall be provided with field mounted controls.
- Units shall be automatically indexed to occupied or un-occupied cycle by the BAS.
- Units shall be automatically indexed to heating or cooling cycle by the BAS.
- Economizer shall be disabled based on a single global system enthalpy sensor.

A. Safeties:

- Discharge air sensor shall indicate alarm when high temperature of 130 degrees is sensed.
- Factory mounted low temperature limit shall de-energize unit when low temperature of 36 degrees is sensed.
- Discharge air sensor shall assume control of the dampers as required to maintain minimum discharge air temperature of 60 degrees.

B. Occupied Cycle:


- Supply fan shall run continuously.
- Outdoor air damper shall position to it's scheduled minimum position, with return air damper positioning reverse correspondingly. Outdoor air damper is never positioned below minimum scheduled position for ventilation purposes.
- Space sensor shall modulate face and bypass damper to maintain occupied cycle setpoint of 72 degrees. Outdoor air & return air dampers shall modulate to reduce overheating when outdoor air temperature is below 80 degrees.
- Condensing unit shall cycle to maintain occupied cooling setpoint of 76 degrees. OA damper shall position to minimum position during cooling cycle.

C. Un-occupied Cycle:

- The outdoor air damper shall remain fully closed, return air damper fully open, with the face and bypass damper modulating in sequence with supply fan to maintain the unoccupied space temperature setpoint of 62 degrees.

D. Warm-up Cycle:

- The unit shall perform an optimized warm-up prior to the start of the occupied mode.
- During the warm-up cycle, the outdoor air damper shall be closed. The unit shall position face and bypass damper to 100% face and re-circulate 100% return air until the space temperature reaches the occupied temperature setpoint.

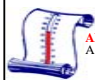DCMO BOCES - Phase 1&2 AS BUILT			
Norwich / Masonville, New York			
Air Temp Heating & Air Conditioning, Inc.			
Sequence Of Operation-pg.4			
REV: 1	As-Built	11/19/2007	JOB NO: P7425-7290
 AIR TEMP HEATING & AIR CONDITIONING, INC. <small>A LINC SERVICE © CONTRACTOR</small>			CHECK BY: RSL
			DSCODE:
			68 of 69

Sequence Of Operation-pg.5

HRU Sequence:

A. General: The factory provided controller shall be wired to control the following functions (based on specified unit):

- Outside & re-circulation dampers based on return air dewpoint.
- Exhaust fan VFD shall track outside air damper and offset based on space differential pressure to maintain space negative pressure. Sensor is provided by unit manufacturer and field installed by TC contractor.
- Outside air heat exchanger face/bypass damper based on heat exchanger exhaust temperature (defrost).
- Cooling modulation based on return air dewpoint, return temperature, supply discharge low limit, and the CW low limit temperature sensors.
- Heating modulation based on return air temperature and discharge high/low limits.
- Summer/Winter changeover based on outside air temperature.
- Supply and exhaust fan enable/disable & remote enable/disable.
- Freezestat input in the supply air discharge (freezestat is factory supplied and installed).
- Purge mode start/stop by digital input, or button on remote user terminal.
- Alarm indication output.

B. Winter Mode:

- Humidity control - The outside and re-circulation air dampers modulate to maintain return air dewpoint (winter setpoint = 63.7 degrees dewpoint {82 degrees F, 55% RH}).
- When the outside air damper is at minimum, the re-circulation air damper is at maximum, and the exhaust fan VFD is at minimum exhaust.
- Cooling shall be locked out.
- Heating shall be controlled to maintain return air temperature setpoint (winter setpoint = 82 degrees F).
- Pressure control - Exhaust fan VFD shall track outside air damper and offset based on space differential pressure to maintain space negative pressure (0.04" WC).

C. Summer Mode:

- Humidity control - The outside and re-circulation air dampers modulate to maintain return air dewpoint (summer setpoint = 69.4 degrees dewpoint {85 degrees F, 60% RH}).
- When the outside air damper is at minimum, the re-circulation air damper is at maximum, and the exhaust fan VFD is at minimum exhaust. Maximum outside air shall be maintained while the cooling is energized for return dewpoint or temperature control (outside air damper is in its maximum position, return air damper is in its minimum position).

- Heating coil face/bypass dampers shall be controlled to maintain discharge air temperature setpoint of 80 degrees.
- Pressure control - Exhaust fan VFD shall track outside air damper and offset based on space differential pressure to maintain space negative pressure (0.04" WC).

D. Summer / Winter Changeover:

- The controller shall perform summer/winter changeover at 60 degrees outside air temperature with a +/-20 degree deadband.
- Changeover shall include setpoint changes, cooling lockout, heating lockout (heating lockout only if summer heating & re-heat functions are disabled).

E. Outside Air Heat Exchanger Face/Bypass Dampers:

- Winter defrost mode (exhaust air temperature leaving the heat exchanger below 38 degrees) – controller shall modulate the heat exchanger face/bypass damper to prevent the exhaust air temperature from dropping below 38 degrees. The damper modulates to prevent frost from forming on the exhaust side of the heat exchanger.
- Energy recovery mode (exhaust air temperature leaving the heat exchanger above 38 degrees) - outside air heat exchanger face/bypass damper modulates to full face so all air flow is across the heat exchanger.

F. Heating High / Low Limits:


- The controller shall have a temperature sensor located in the supply air discharge duct. Supply high limit of 120 degrees shall decrease heat output. Supply low limit of 60 degrees shall increase heat output (winter mode only).
- If the supply air temperature drops below 40 degrees, the freezestat shall signal the controller to de-energize the unit.

G. Purge Mode:

- A digital input or a button on the remote user terminal can be used to energize/de-energize the purge mode. In purge mode the outside air damper fully opens, re-circulation damper fully closes. Humidity control shall be disabled and the temperature controls shall maintain their respective setpoints. The purge mode has an adjustable time limit factory set to 240 minutes.

H. Alarm Indication:

- The controller shall have one digital output for remote indication of an alarm condition (i.e. blower current/differential pressure switch, damper end switches, freezestat, fire/smoke stat...).

DCMO BOCES - Phase 1&2 AS BUILT			
Norwich / Masonville, New York			
Air Temp Heating & Air Conditioning, Inc.			
Sequence Of Operation-pg.5			
REV: 1	As-Built	11/19/2007	JOB NO: P7425-7290
 AIR TEMP HEATING & AIR CONDITIONING, INC. <small>A LINC SERVICE © CONTRACTOR</small>			CHECK BY: RSL
			DSCODE:
69 of 69			